


CALCULATED
APC
CHECKED
GA

PLAN & PROFILE
BEGIN PROJECT TO STA. 30+00.00

LAK-90-26.87

18
54

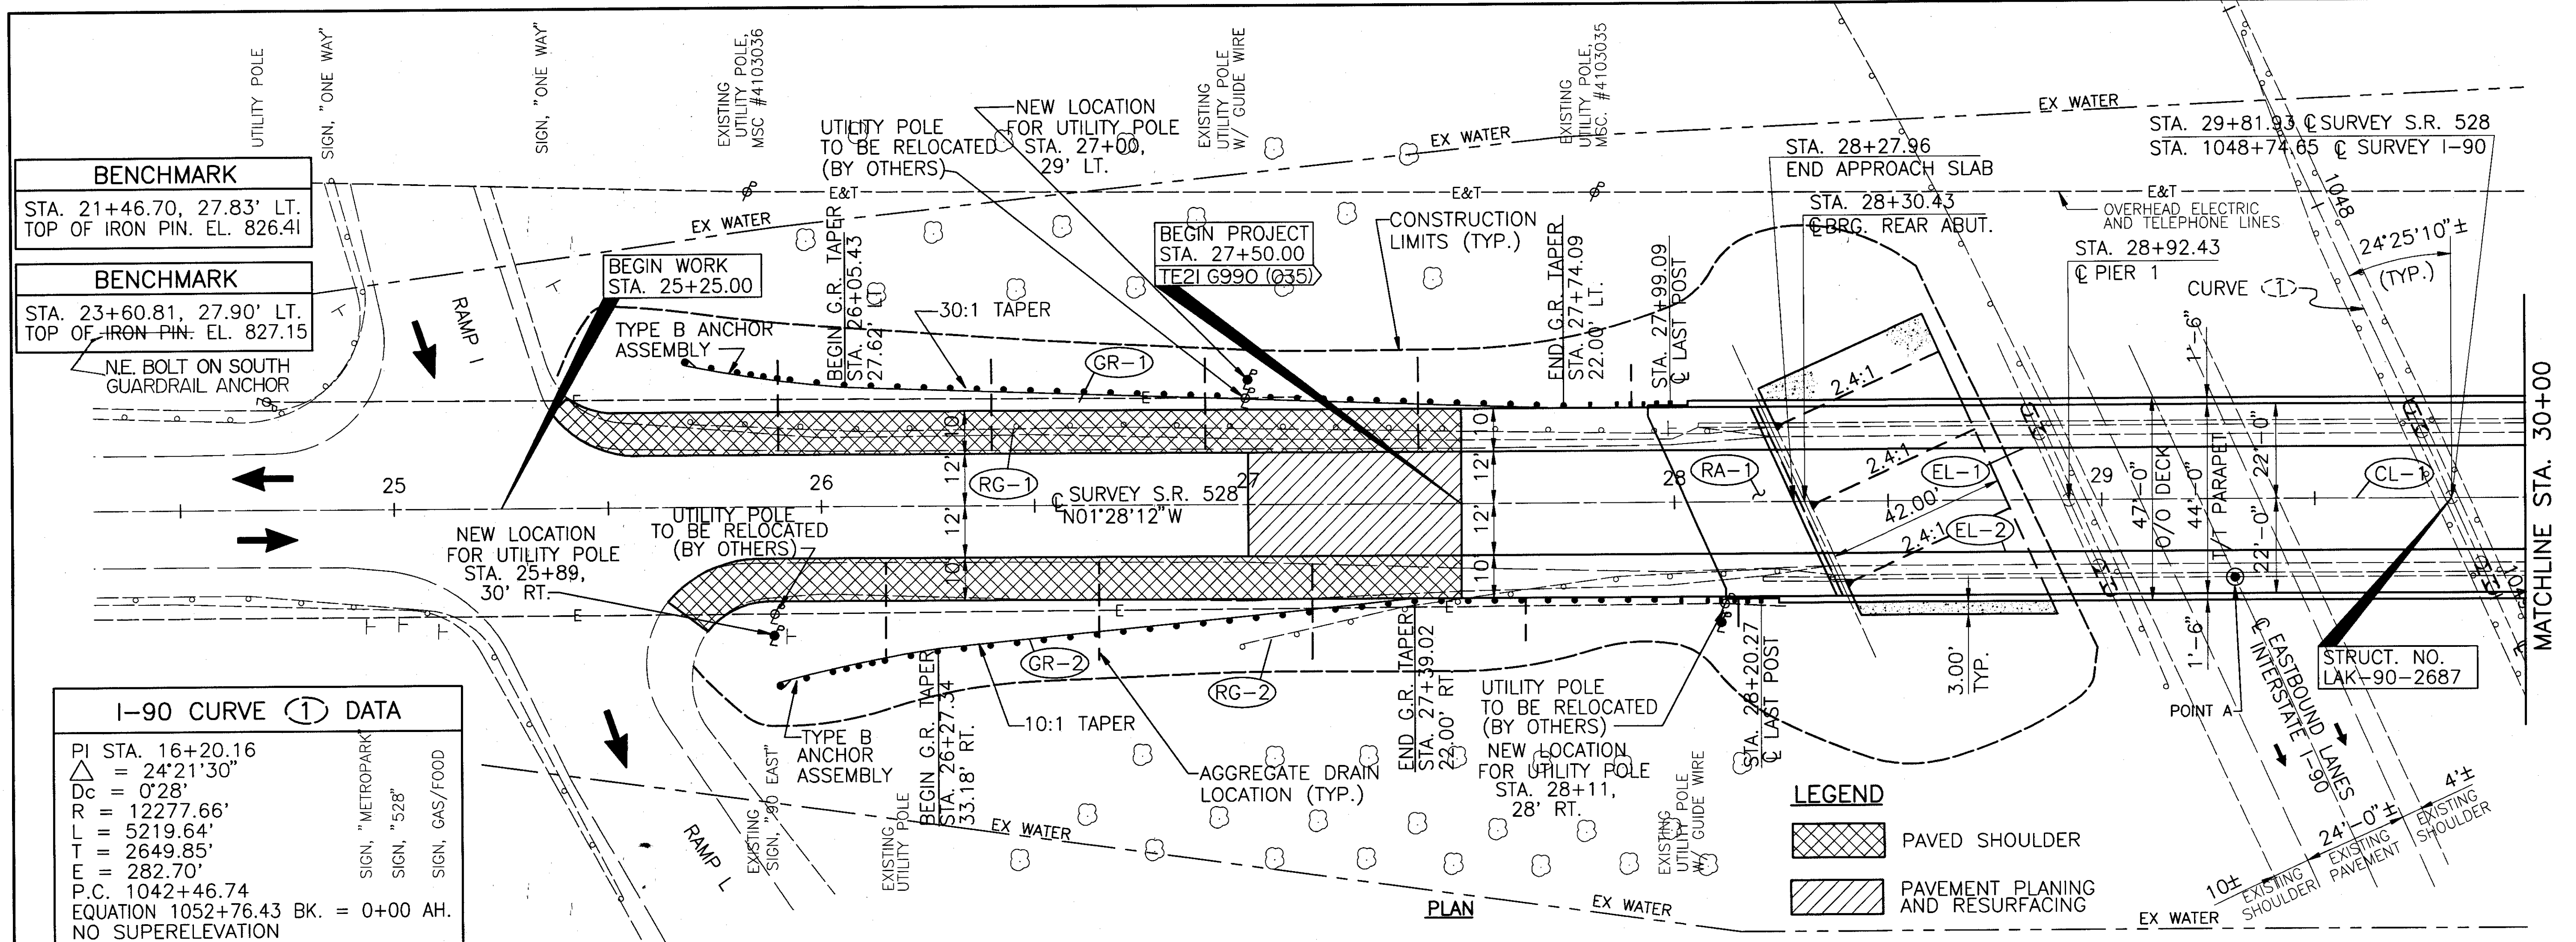


BENCHMARK
STA. 21+46.70, 27.83' LT.
TOP OF IRON PIN. EL. 826.41

BENCHMARK
STA. 23+60.81, 27.90' LT.
TOP OF IRON PIN. EL. 827.15

I-90 CURVE (1) DATA

PI STA.	16+20.16
Δ	24°21'30"
Dc	0'28"
R	12277.66'
L	5219.64'
T	2649.85'
E	282.70'
P.C.	1042+46.74
EQUATION	1052+76.43 BK. = 0+00 AH.
NO SUPERELEVATION	

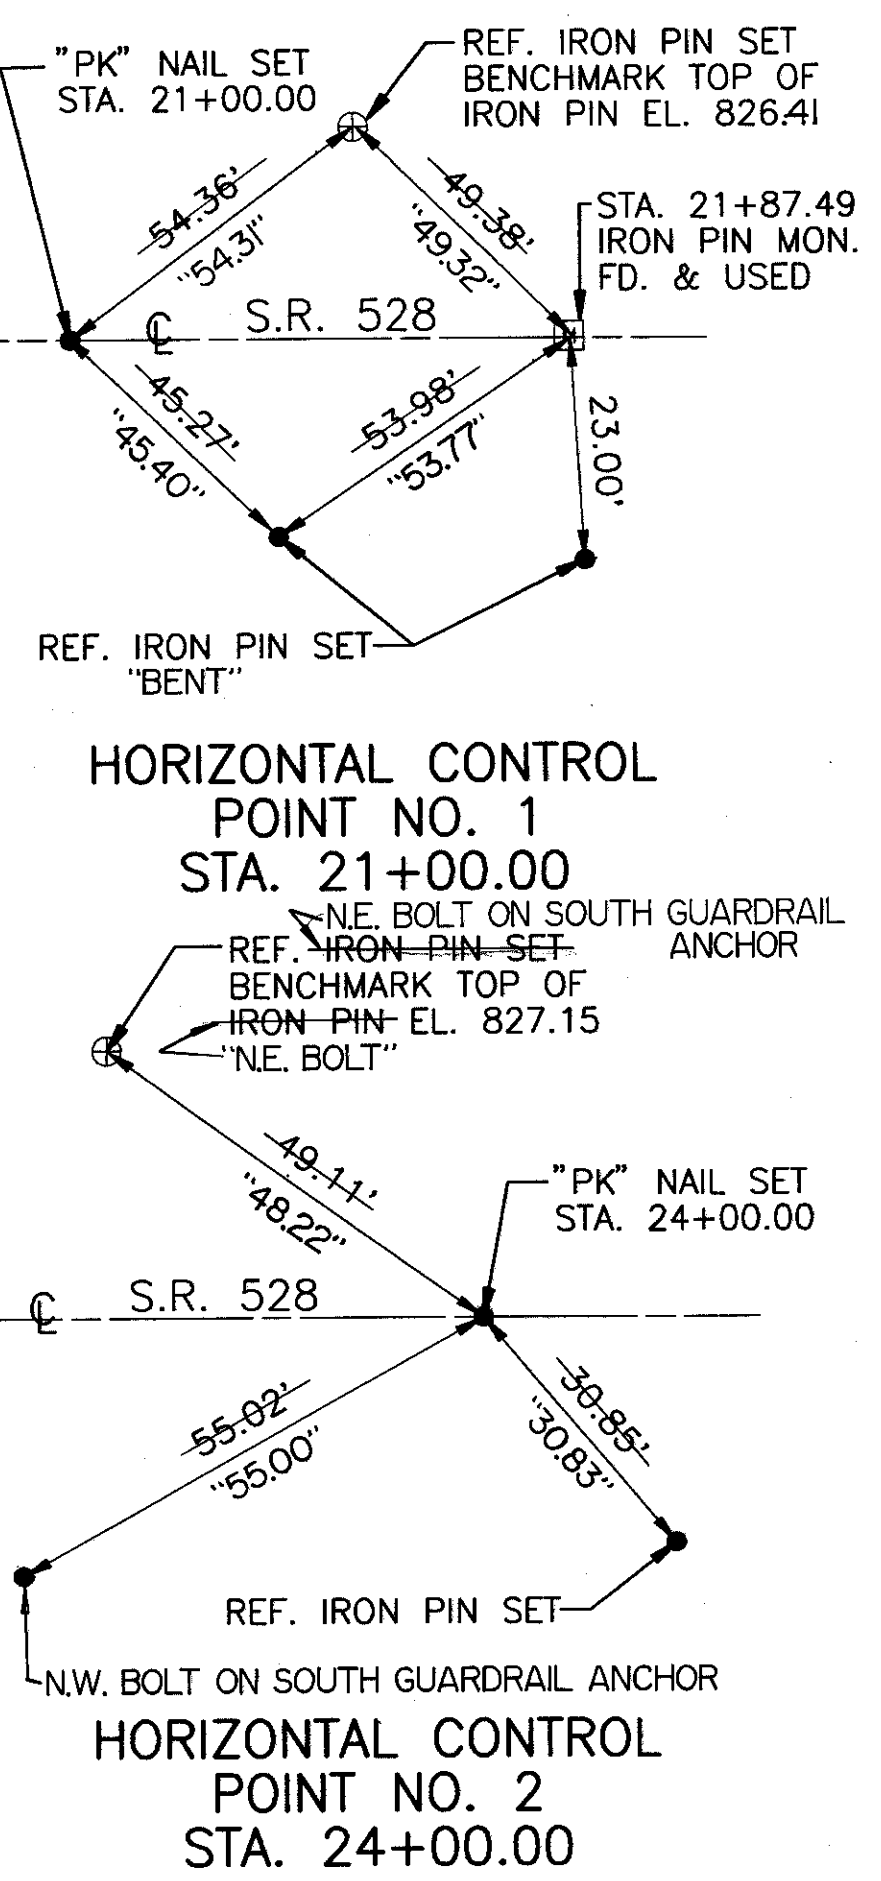

PROPOSED STRUCTURE

PROPOSED WORK: NEW WIDENED COMPOSITE REINFORCED CONCRETE DECK ON WIDENED SUBSTRUCTURES INCLUDING ADDING TWO NEW STEEL BEAMS, REPLACE ABUTMENT BACKWALLS, NEW WINGWALLS, RESET ROCKER BEARINGS, NEW STRIP SEAL EXPANSION JOINTS, PATCH AND SEAL SUBSTRUCTURES, REPLACE APPROACH SLABS, NEW VANDAL PROTECTION FENCE

SPAN LENGTHS: 62'-0"±, 89'-6"±, 89'-6"±, & 54'-0"±, C/C BEARINGS

ROADWAY WIDTH: 44'-0" TOE-TOE OF CONCRETE PARAPET

RAILINGS: CONCRETE PARAPET WITH CHAIN LINK FENCE

LOADINGS: HS20-44 CASE II AND ALTERNATE MILITARY LOADINGS


SKIEW: 24'-25'-10"±, RIGHT FORWARD

WEARING SURFACE: MONOLITHIC CONCRETE

APPROACH SLABS: AS-1-81 (25'-0" LONG)

ALIGNMENT: TANGENT

SUPERELEVATION: NONE

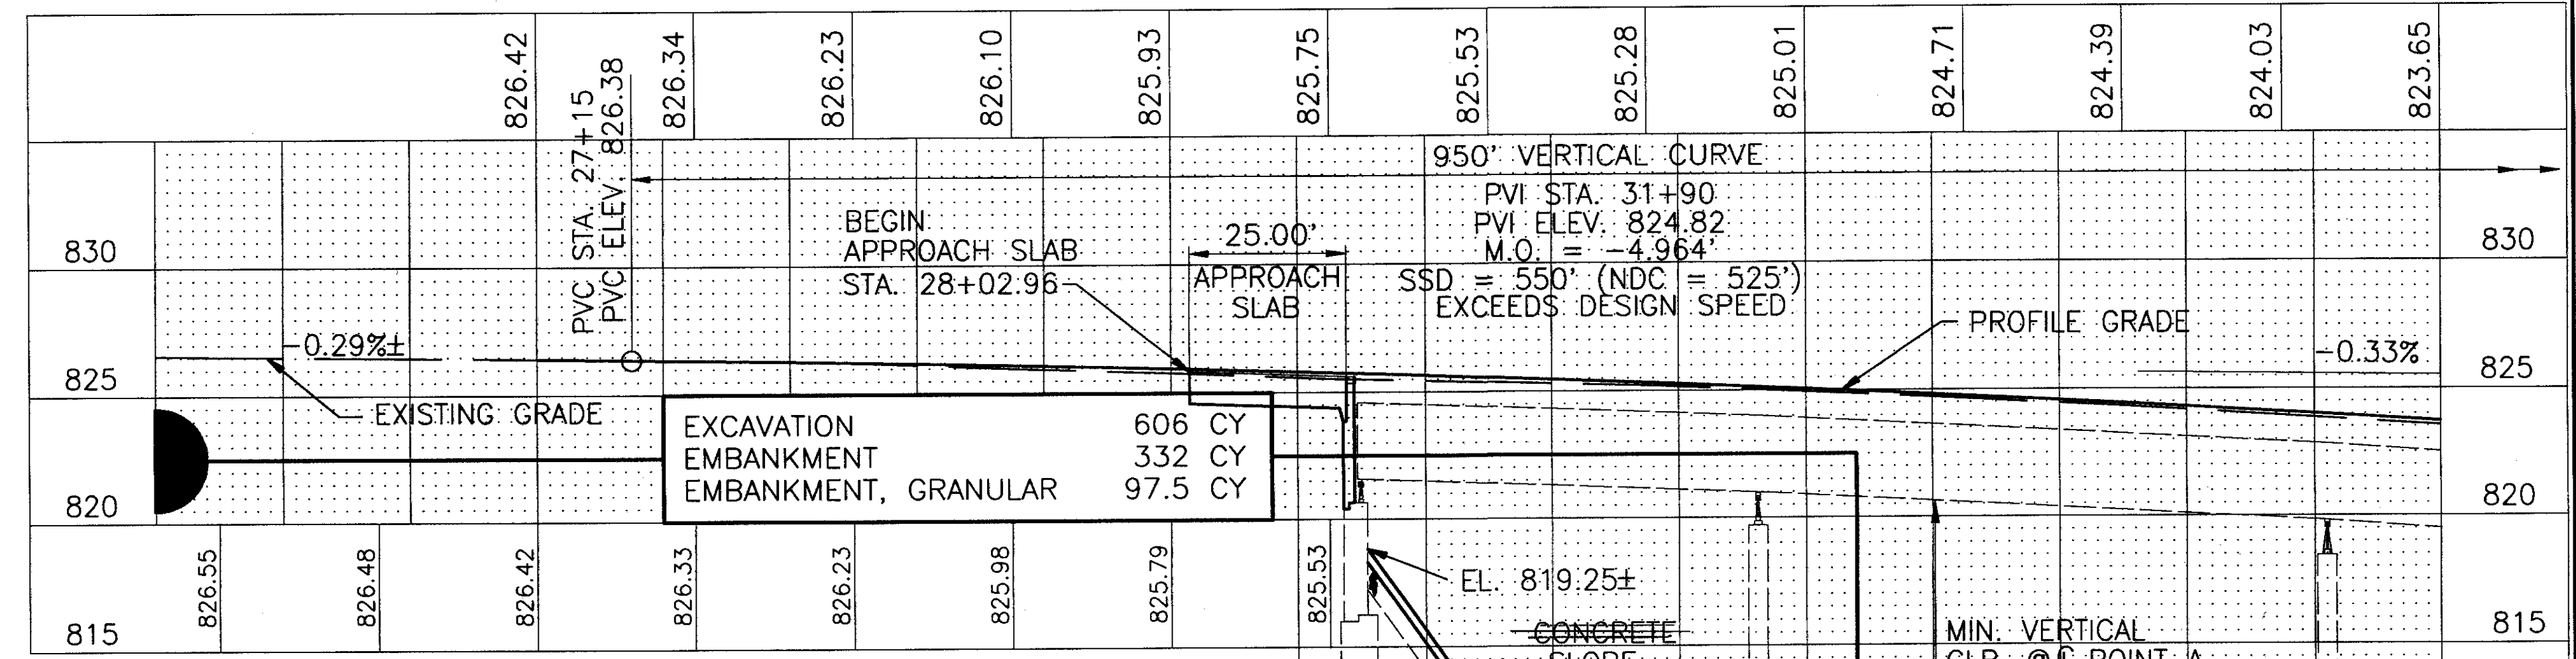

EXISTING STRUCTURE

TYPE: FOUR SPAN CONTINUOUS STEEL BEAMS WITH REINFORCED CONCRETE DECK & SUBSTRUCTURES

SPAN LENGTHS: 62'-0"±, 89'-6"±, 89'-6"±, & 54'-0"±, C/C BEARINGS

ROADWAY WIDTH: 30'-0" FACE-FACE OF CURB W/ 2'-0" SAFETY CURBS ON EACH SIDE

RAILINGS: CONCRETE PARAPET WITH PIPE RAILING

SKIEW: 24'-25'-10"±, RIGHT FORWARD

LOADING: CF-400

WEARING SURFACE: ASPHALT CONCRETE

APPROACH SLABS: AS-1-54 (25'-0" LONG)

ALIGNMENT: TANGENT

SUPERELEVATION: NONE

YEAR BUILT: 1960

STRUCTURE FILE #: 4305019

Filename: 02903000
Plot Scale: 1"=20'
Drawn By: J. J. McG