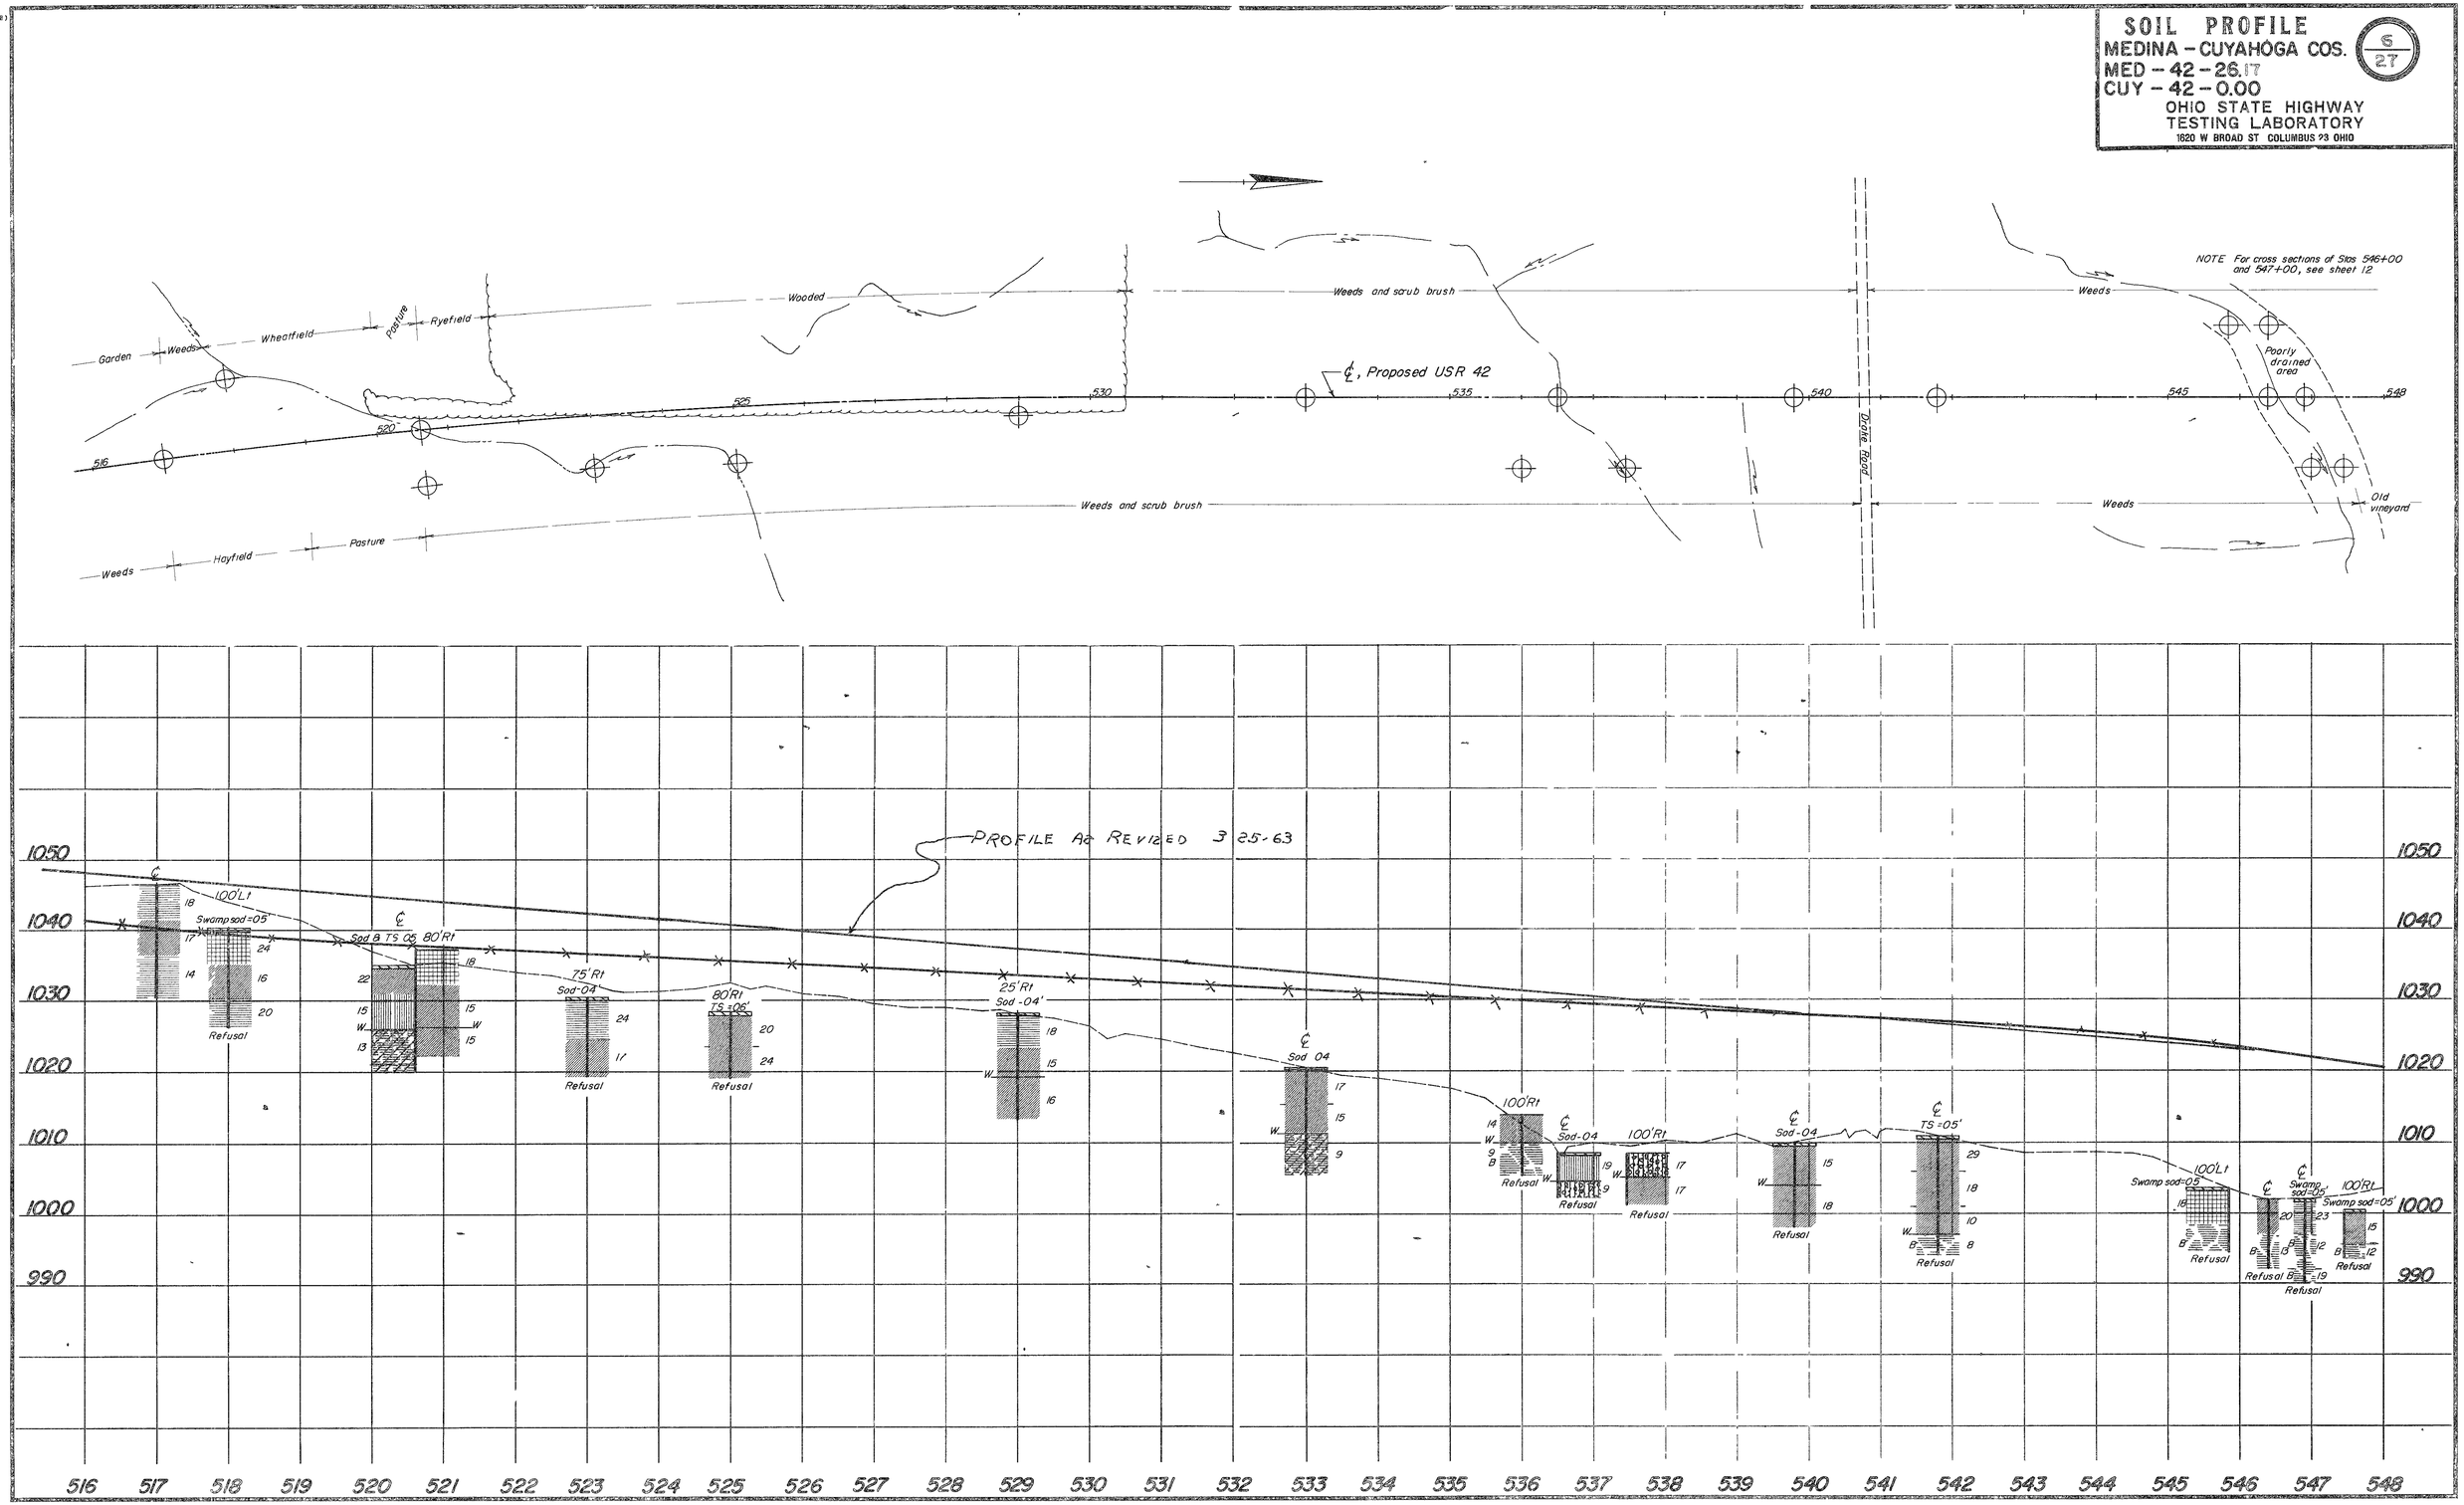
SOIL PROFILE
MEDINA - CUYAHOGA COS.
MED - 42 - 26.17
CUY - 42 - 0.00
OHIO STATE HIGHWAY
TESTING LABORATORY
1620 W BROAD ST COLUMBUS 23 OHIO
6
27
NOTE For cross sections of Stas 546+00 and 547+00, see sheet 12
Garden
Weeds
Wheatfield
Pasture
Ryefield
Wooded
Weeds and scrub brush
Weeds
Poorly drained area
Old vineyard
Drake Road
℄, Proposed USR 42
Weeds
Hayfield
Pasture
Weeds and scrub brush
Weeds
PROFILE AS REVISED 3-25-63
100'Lt
Swamp sod=05'
Refusal
Sod & TS 05
80'Rt
75'Rt
Sod-04
80'Rt
TS=06'
25'Rt
Sod-04'
Sod 04
100'Rt
Sod-04
100'Rt
Sod-04
TS=05'
100'Lt
Swamp sod=05
Swamp sod=05'
100'Rt
Swamp sod=05'
1050
1040
1030
1020
1010
1000
990
516
517
518
519
520
521
522
523
524
525
526
527
528
529
530
531
532
533
534
535
536
537
538
539
540
541
542
543
544
545
546
547
548