


CROSS SECTION INDEX

STATION	SHEET
646+00	17
649+00	18
653+00	18
655+00	18
655+61	19
657+00	19
659+00	19

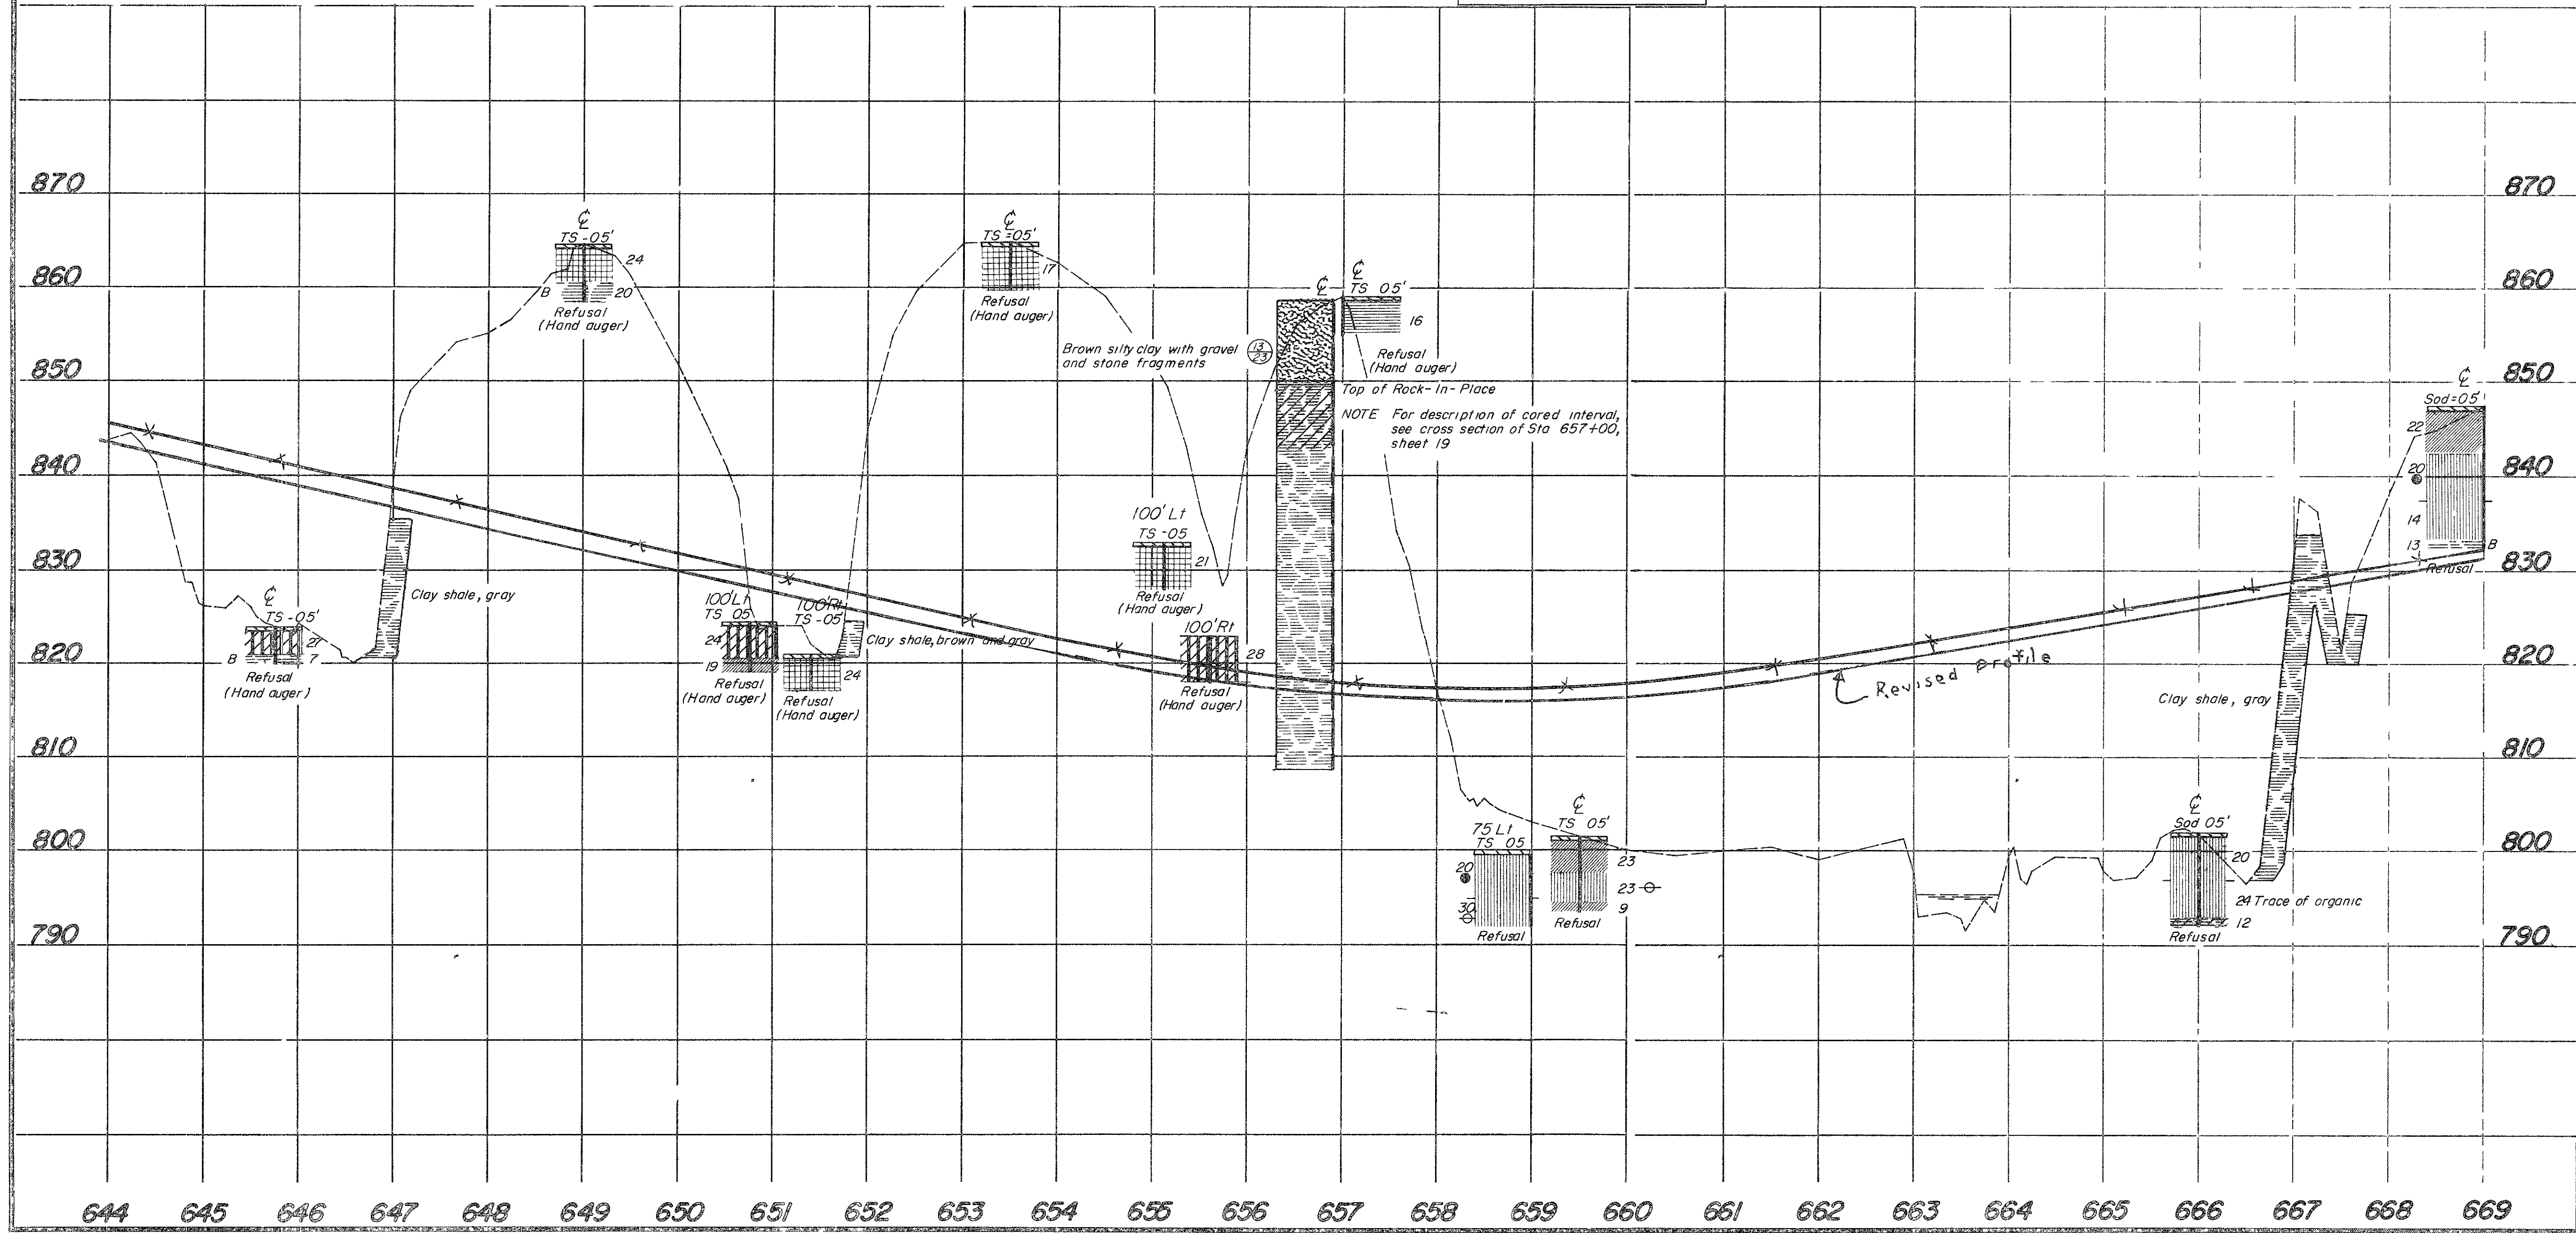

NOTE For description of cored interval, see cross section of Sta 657+00, sheet 19

644 645 646 647 648 649 650 651 652 653 654 655 656 657 658 659 660 661 662 663 664 665 666 667 668 669

870
860
850
840
830
820
810
800
790

870
860
850
840
830
820
810
800
790