


SR 82 (Royalton Road)
INTERCHANGE


SOIL PROFILE
MEDINA-CUYAHOGA COS.
MED-42-26.17
CUY-42-0.00
OHIO STATE HIGHWAY
TESTING LABORATORY
1620 W BROAD ST COLUMBUS 23 OHIO

24
27

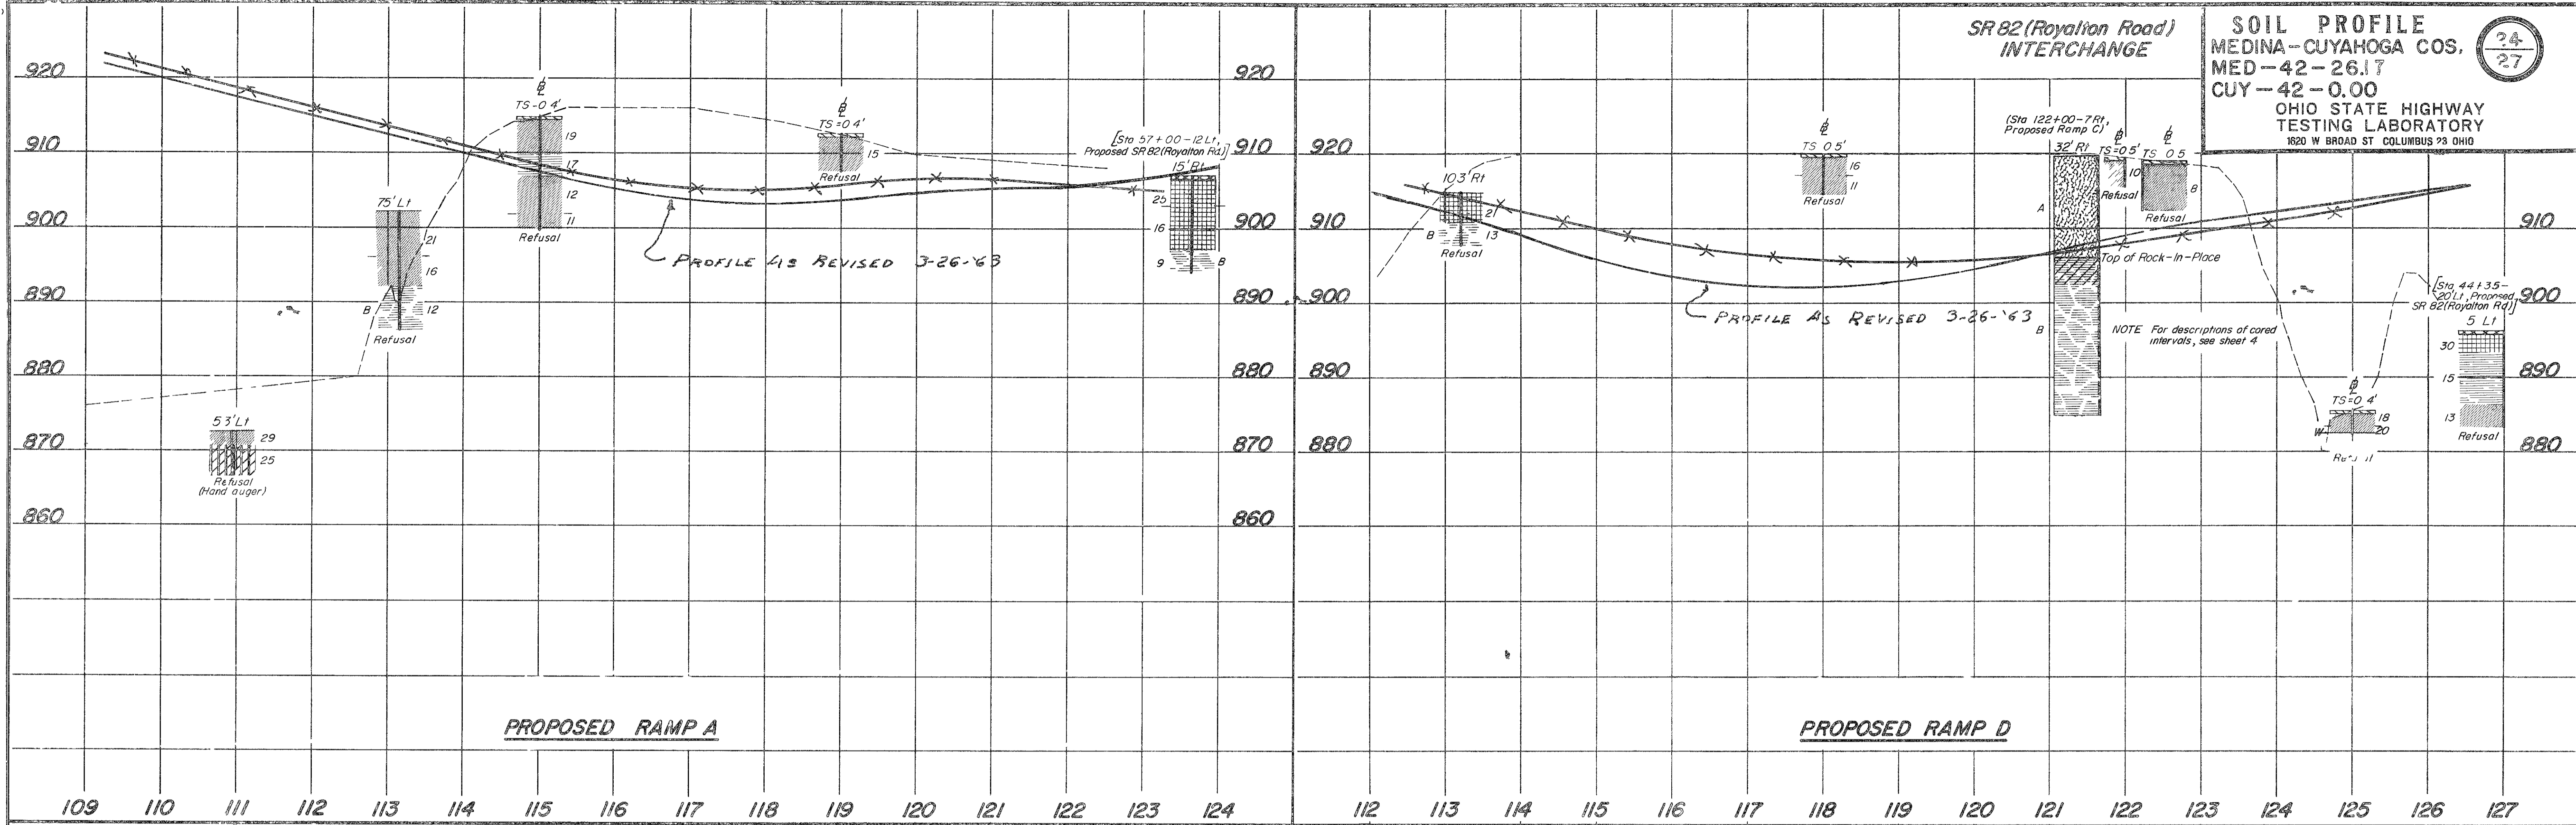

PROPOSED RAMP A

PROPOSED RAMP D

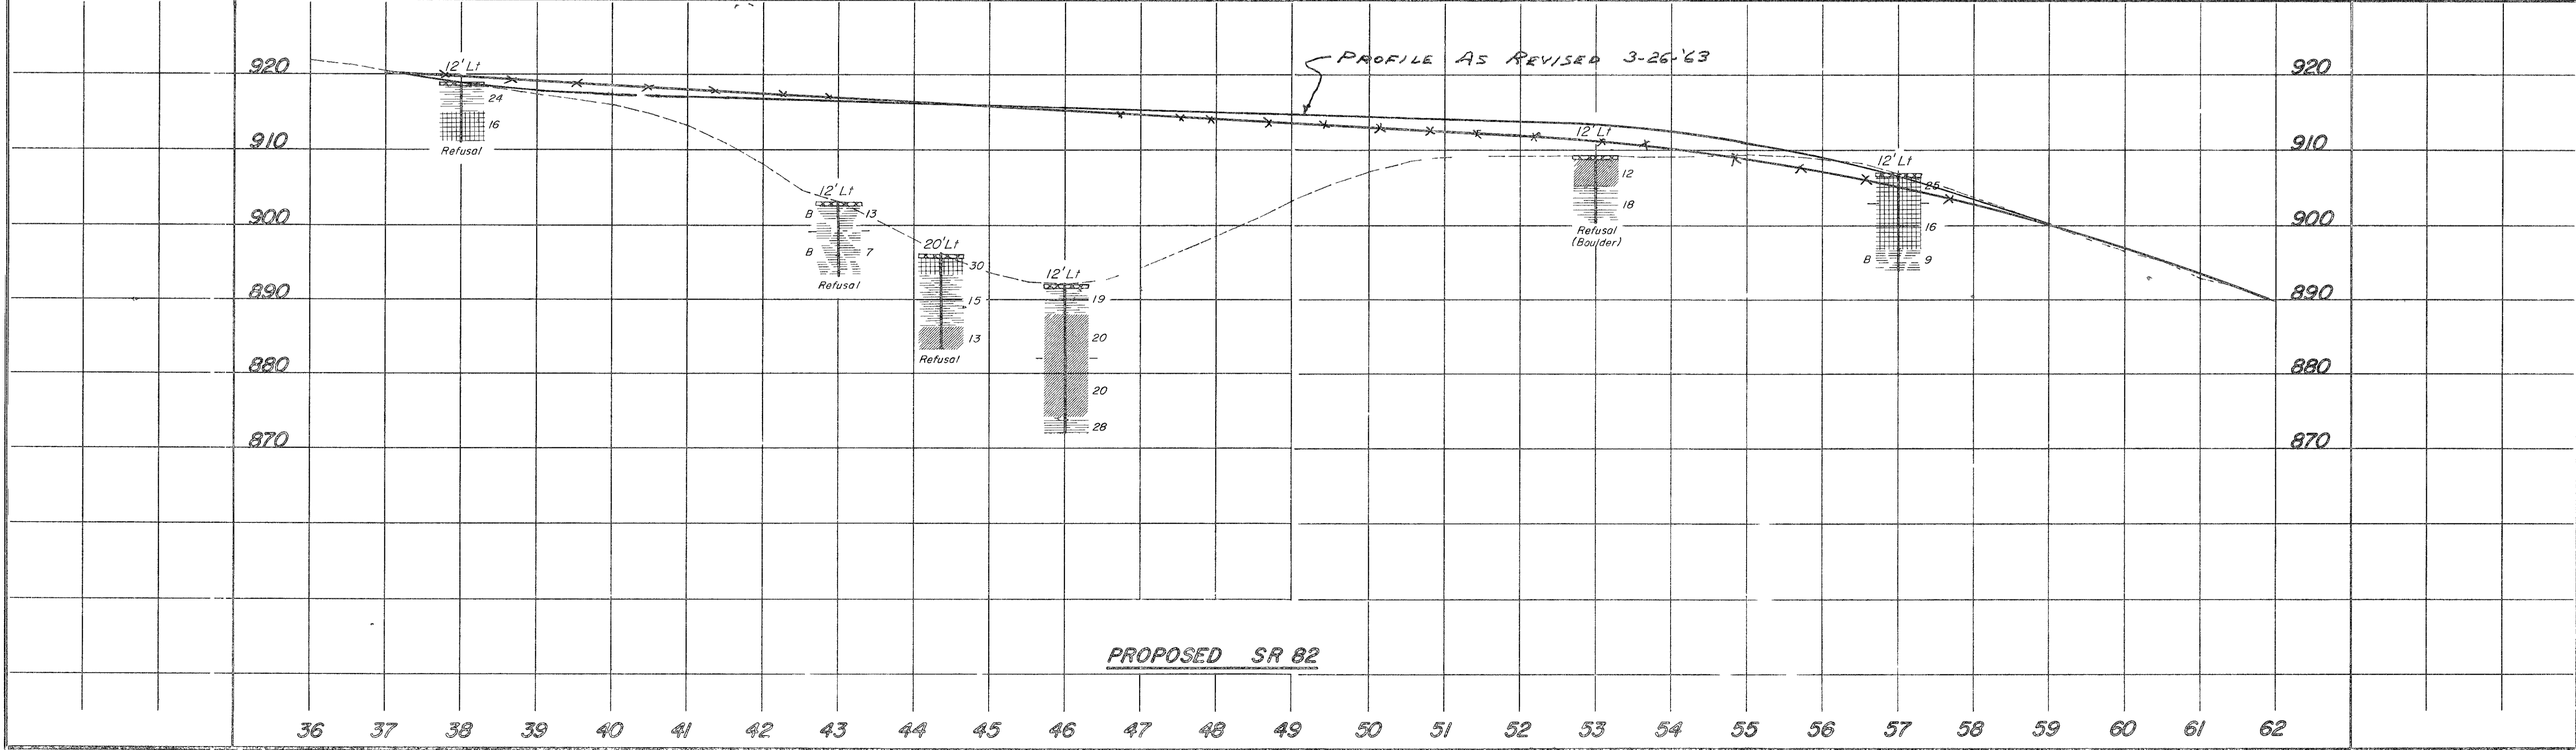

PROPOSED SR 82