


SR 82 (Royalton Road)
 INTERCHANGE

STATION 12+00 71'2"

- A Brown silty clay with soft weathered shale fragments and sandstone cobble sand fragments

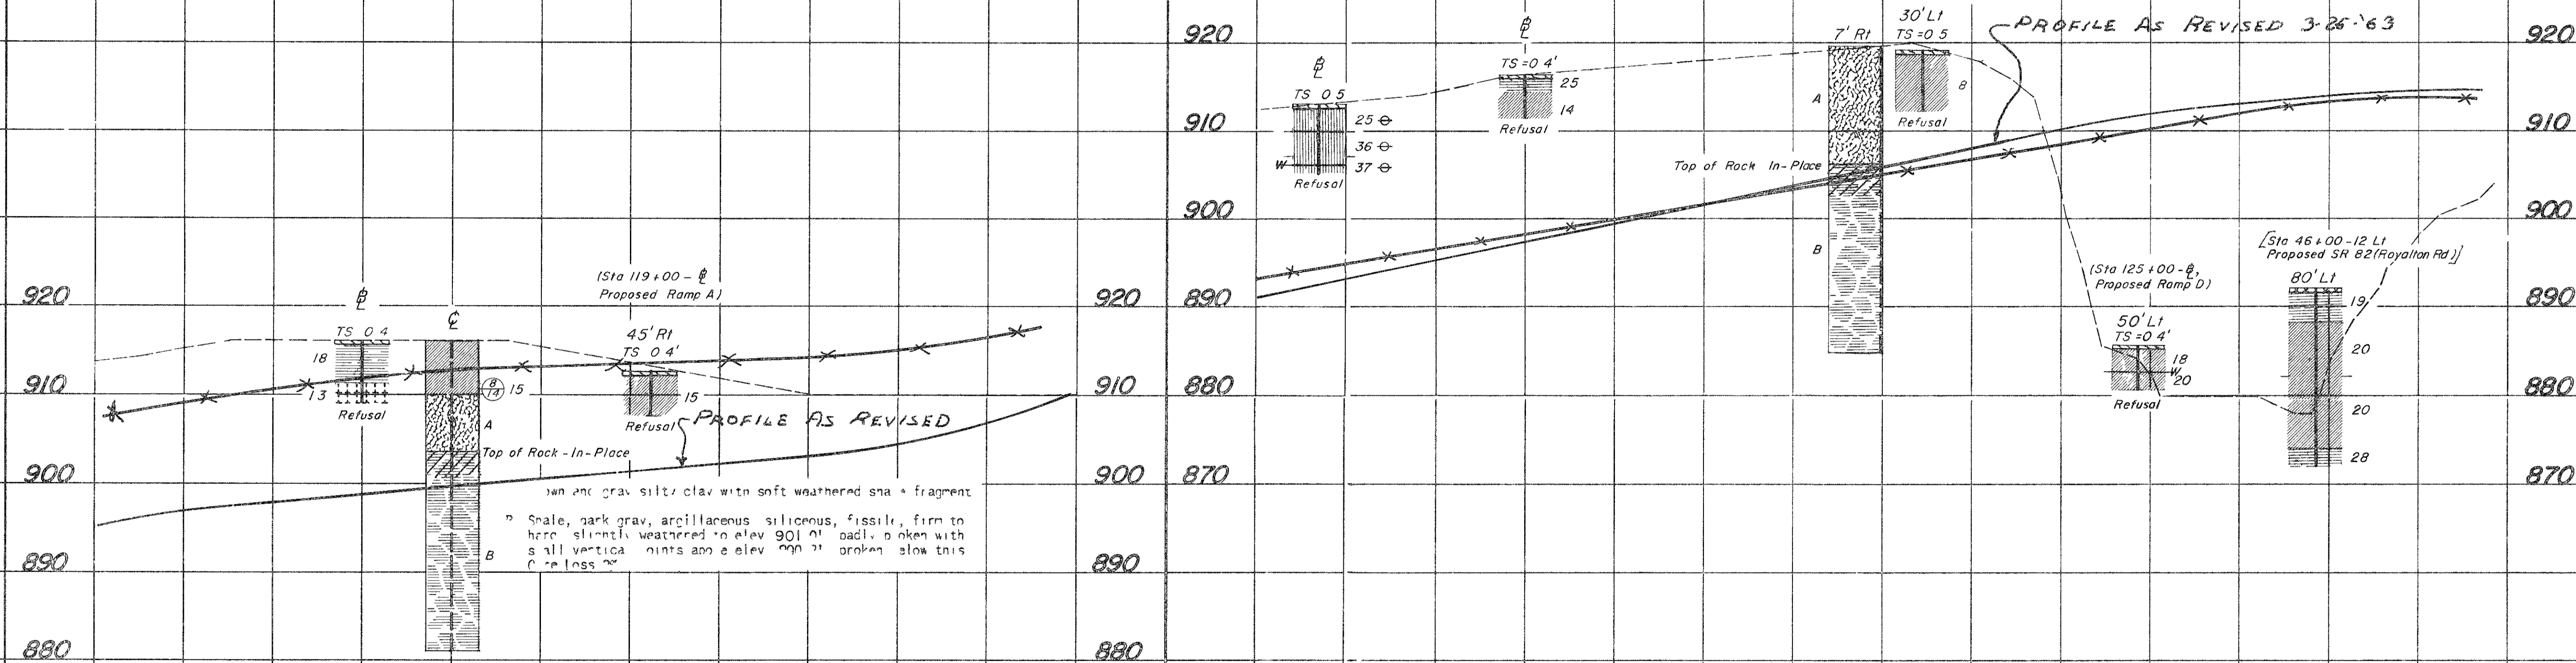

PROPOSED RAMP B

PROPOSED RAMP C