


TYPICAL SECTIONS

TYPE T-71, T-35 ON B-20 AND T-32 ON B-19

FED. RD. DIVISION	STATE	PROJECT
2	OHIO	1-1103 (20) S-46-(7)


6-5
333

LAKE COUNTY
LAK-1-4.02
This sheet supersedes
sheet No. 6

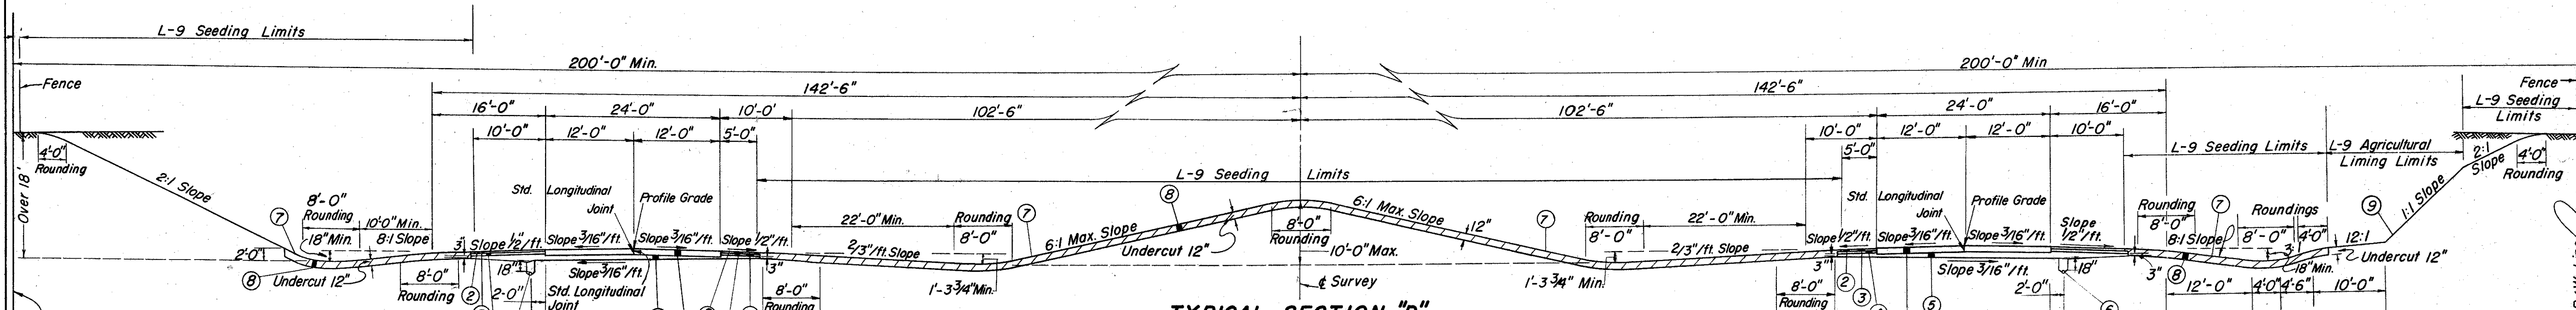


TYPICAL SECTION "D"
Limiting Stations
Sta. 251+44 to Sta. 255+40 Southbound Outside Only
Sta. 277+20 to Sta. 279+62
Sta. 297+25 to Sta. 311+00

- LEGEND—
- ① T-71 10" Reinforced Portland Cement Concrete Pavement
 - ② T-31 Bituminous Surface Treatment (See Proposal) * See Sheet No. 5
 - ③ B-219 3" Waterproofed Aggregate Base Course
 - ④ I-18 5" Stabilized Crushed Aggregate Shoulders and Approaches.
 - ⑤ I-22 Subbase (Variable Depth), Grading A or B, as per Plan
 - ⑥ I-4 6" Helical Perforated Corrugated Metal Pipe Sec. M-6.4 (h)
 - ⑦ L-9 Seeding and Protecting Roadway Areas
 - ⑧ L-3 Placing Stockpiled Topsoil.
 - ⑨ L-9 Agricultural Liming Material
- * Transition from existing shoulder width at Sta. 4+50 to a 5' width at Sta. 5+00.

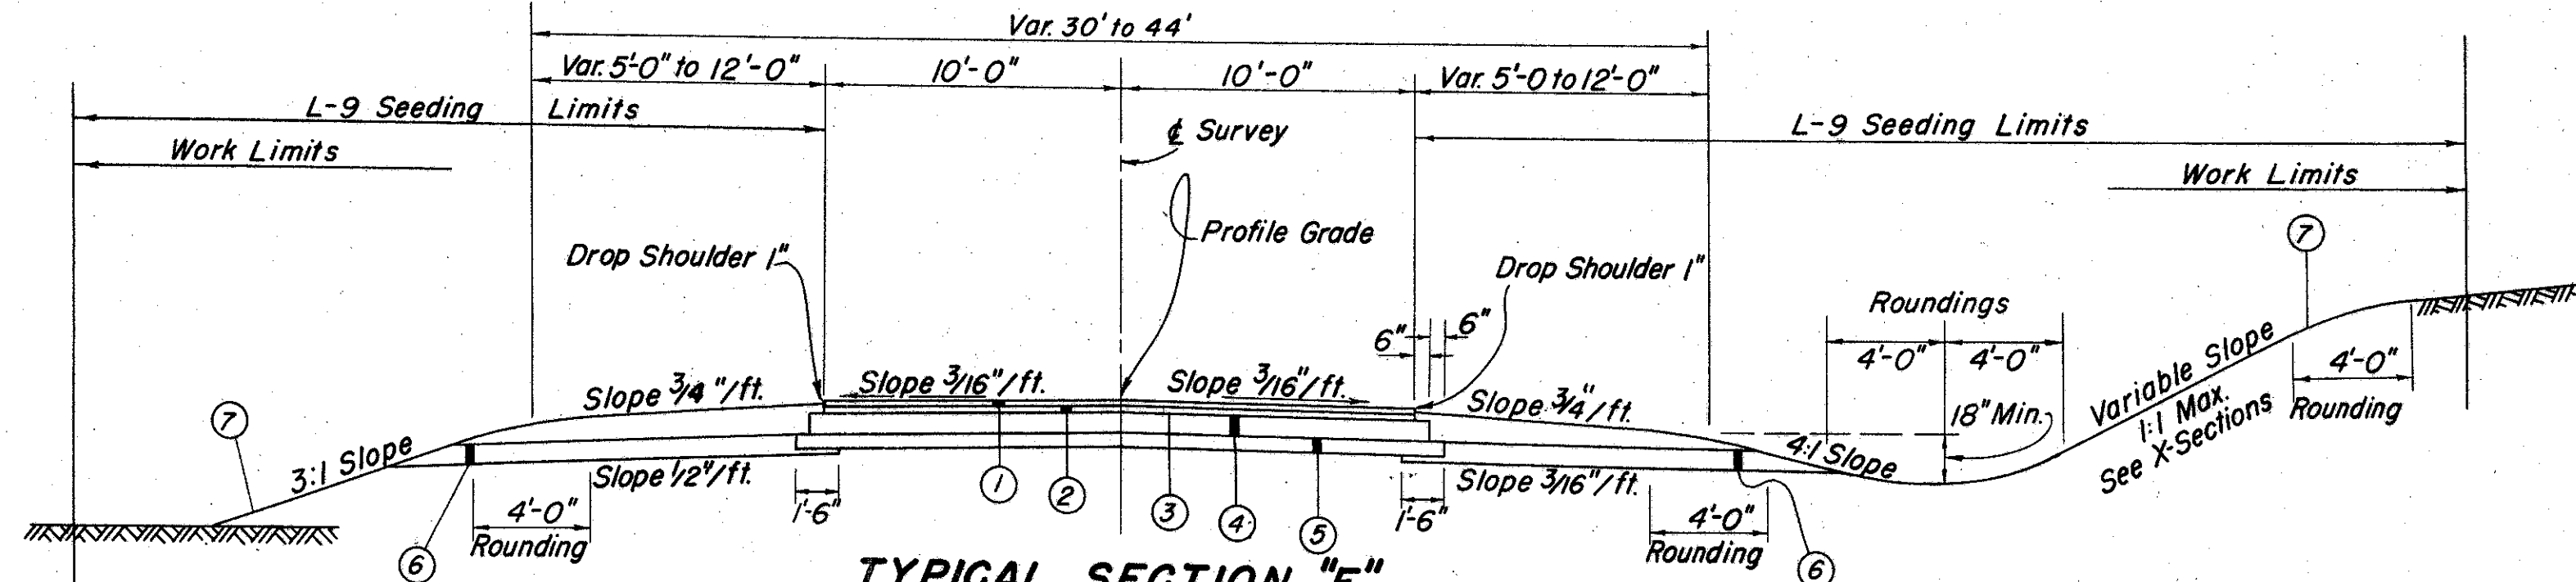


TYPICAL SECTION "E"
KIRTLAND ROAD
Limiting Stations
Sta. 5+95 to Sta. 12+73.63 = 678.63 Lin. Ft.
483.38 Lin. Ft.
Deduct for Bridge
Total 195.25 Lin. Ft.


NOTE: All Slopes Typical Unless otherwise shown on Cross Sections.

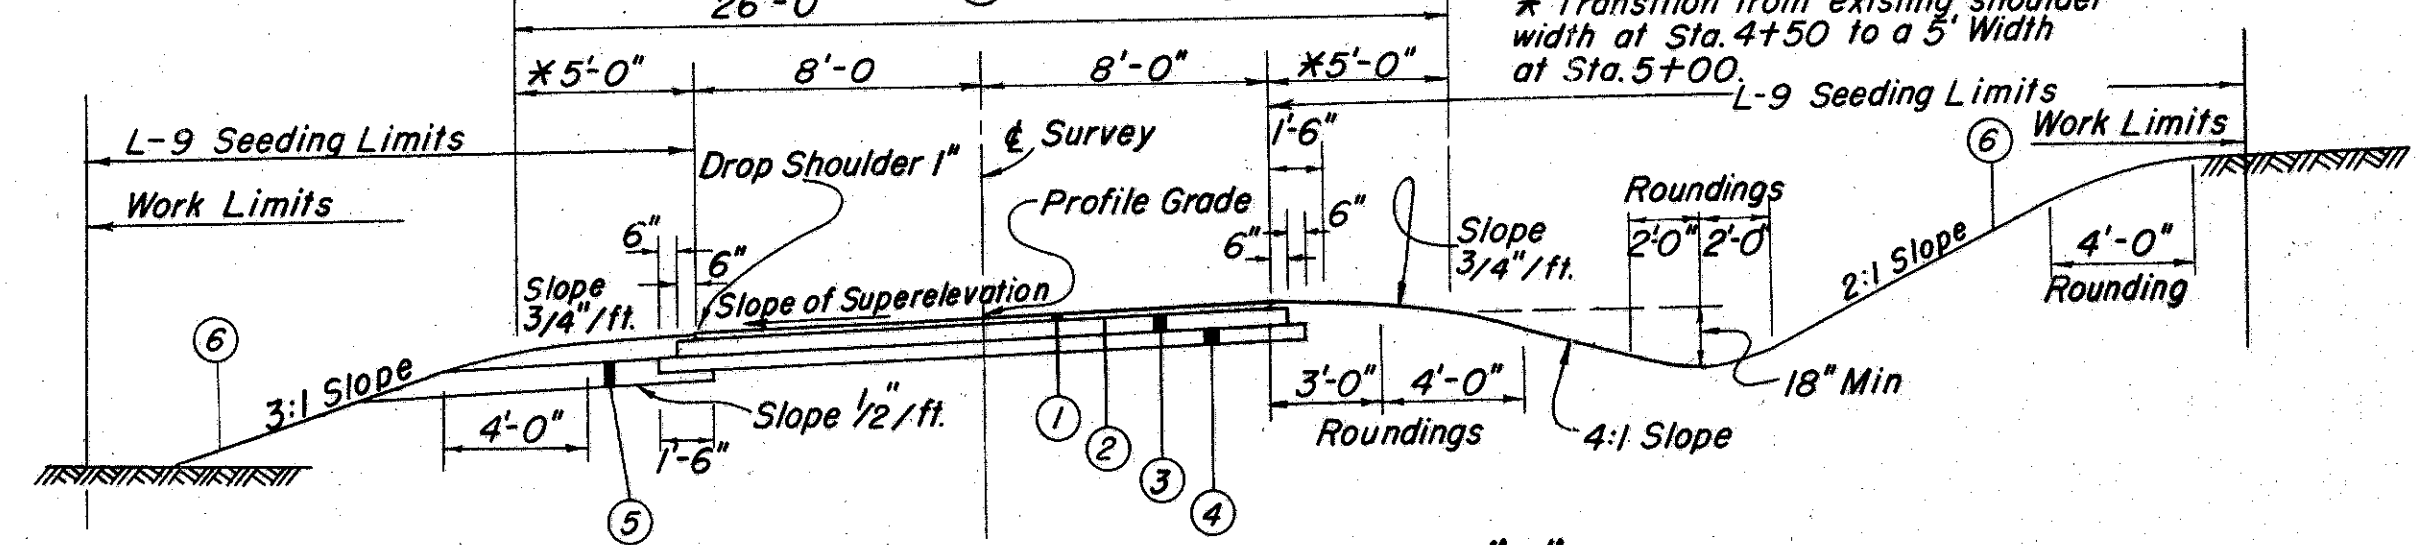

TYPICAL SUPERELEVATED SECTION "G"
RANDALL ROAD RELOCATION
Limiting Stations
Sta. 4+50 to Sta. 6+25 = 175.00 Lin. Ft.

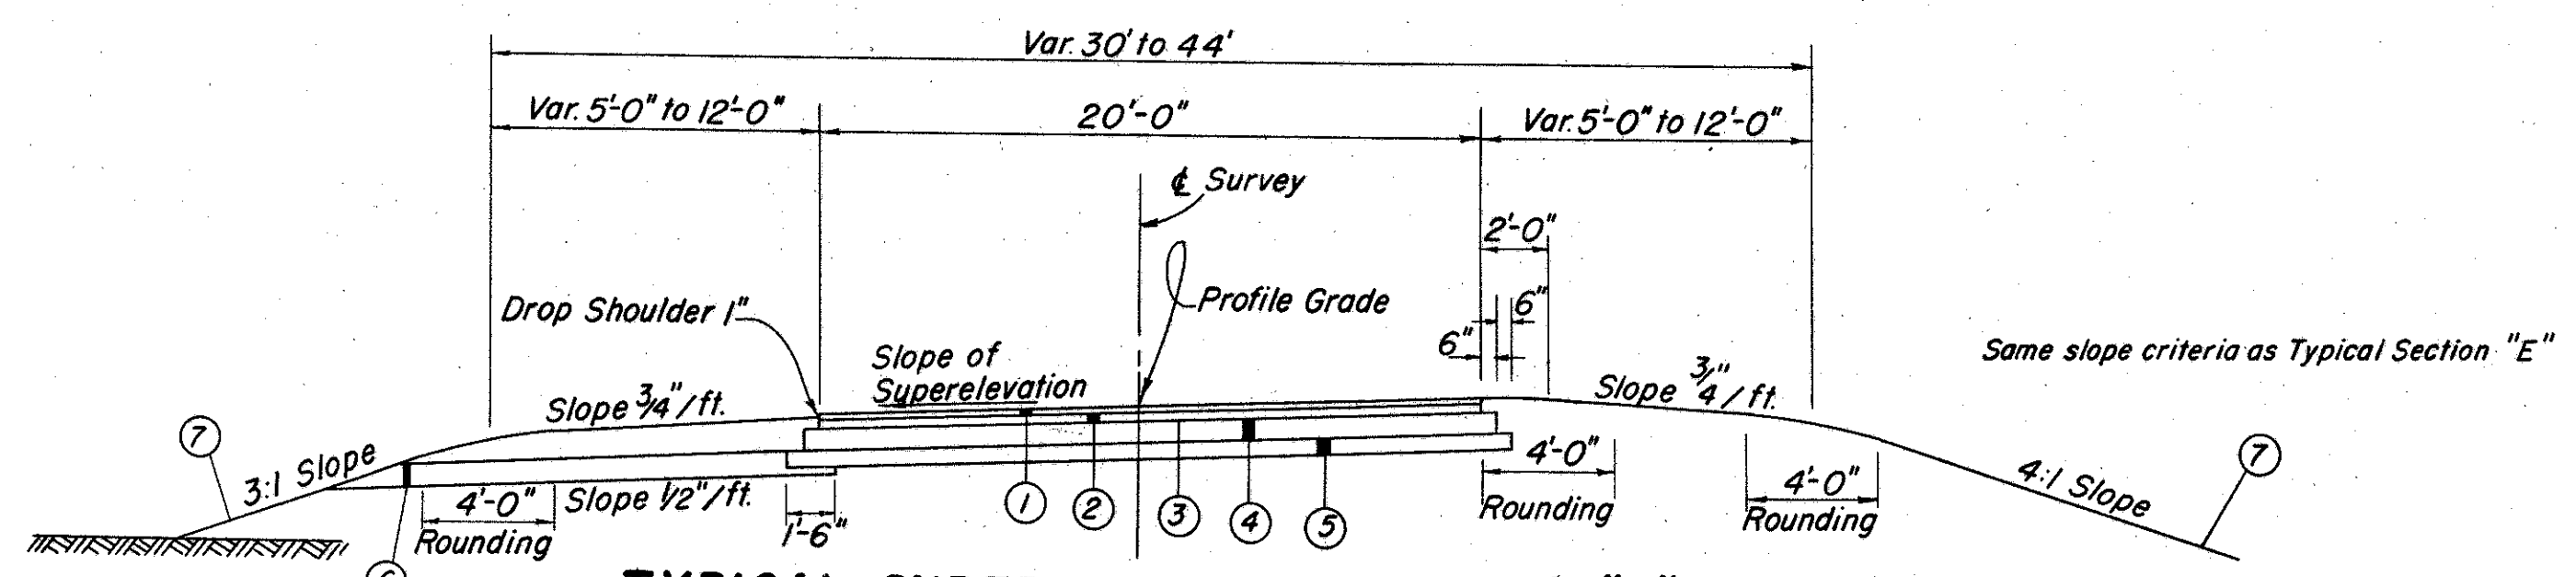

TYPICAL SUPERELEVATED SECTION "F"
KIRTLAND ROAD
Limiting Stations
Sta. 12+73.63 to Sta. 15+23.63 = 250.00 Lin. Ft.

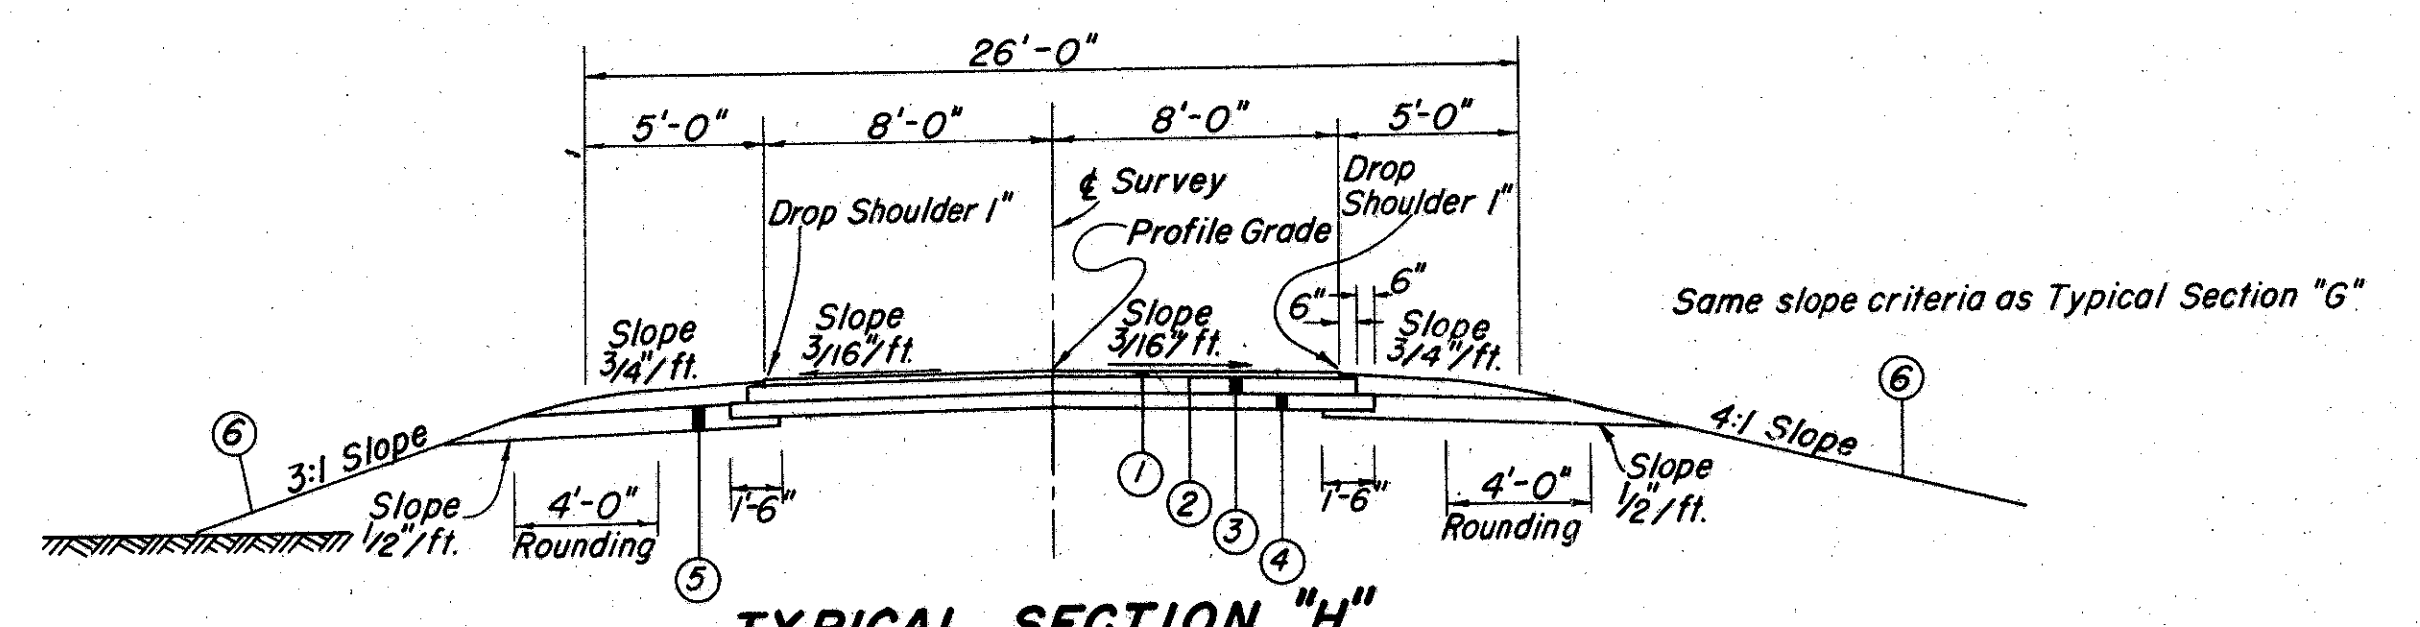

TYPICAL SECTION "H"
RANDALL ROAD RELOCATION
Limiting Stations
Sta. 6+25 to Sta. 9+55.39 = 330.39 Lin. Ft.

- LEGEND—
- ① T-35 1/2" Asphaltic Concrete Surface Course Type "A" or "C" (70-85)
 - ② B-35 2 3/4" Asphaltic Concrete Base Course. (70-85)
 - ③ T-30 Bituminous Prime Coat, Sec. M-5.7, RT-2 or RT-3 or Sec. M-5.3, MC O-1 Applied at the Rate of 0.35 Gal. per Sq. Yd.
 - ④ B-20 8" Waterbound Macadam Base Course using Size No. 2 Course Aggregate.
 - ⑤ I-22 6" Subbase, Grading A or B, as per Plan
 - ⑥ I-9 Stone Underdrain (No. 2) Staggered at 50' Intervals as Directed by Engineer.
 - ⑦ L-9 Seeding & Protecting Roadway Areas, as per Plan.

- LEGEND—
- ① T-32 Bituminous Road Mix, Method "B" & "C" Using .056 Cu. Yd. No. 46 Aggregate per Sq. Yd. & 0.9 Gal. Sec. M-5.7, RT-8-9, or Sec. M-5.3, MC 4-5 per Sq. Yd. Bituminous Choke & Seal Coat, Using .004 Cu. Yd. No. 6 or 9 Aggregate per Sq. Yd. for Choke, .008 Cu. Yd. No. 6 Aggregate per Sq. Yd. For Seal & 0.25 Gal. Sec. M-5.7, RT 9-10 or Sec. M-5.3, MC 4-5 per Sq. Yd. For Seal.
 - ② T-30 Bituminous Prime Coat, Sec. M-5.7, RT-2 or RT-3 or Sec. M-5.3, MC O-1 Applied at the Rate of 0.35 Gal. per Sq. Yd.
 - ③ B-19 5" Aggregate Base Course.
 - ④ I-22 4" Subbase, Grading A or B, as per Plan
 - ⑤ I-9 Stone Underdrain (No. 2) Staggered at 50' Intervals As Directed by Engineer.
 - ⑥ L-9 Seeding & Protecting Roadway Areas, as per Plan.

REVISIONS: 3-18-60 Limits on "E" due to change of Br. Cl. to 16'-4"

MICHAEL BAKER JR., CONSULTING ENGINEERS
ROCHESTER, PENNSYLVANIA

STATE OF OHIO
DEPARTMENT OF HIGHWAYS
STATE HIGHWAY NO. 1
C-44
TYPICAL SECTIONS

Designed	Drawn	Traced	Checked	Reviewed	Date	Revised
B.P.	A.G.	A.G.	E.H.			

Added 3-24-60 R.E.C.