

Seeding  
End  
Width  
Sq Yd


This sheet supersedes  
Sheet No. 181  
Added 3-24-00 R.E.S.

FED. RD. DIVISION	STATE	PROJECT
2	OHIO	1-1103(20)



LAKE COUNTY  
LAK-1-4.02

End Area		Volume	
Cut	Fill	Cut	Fill

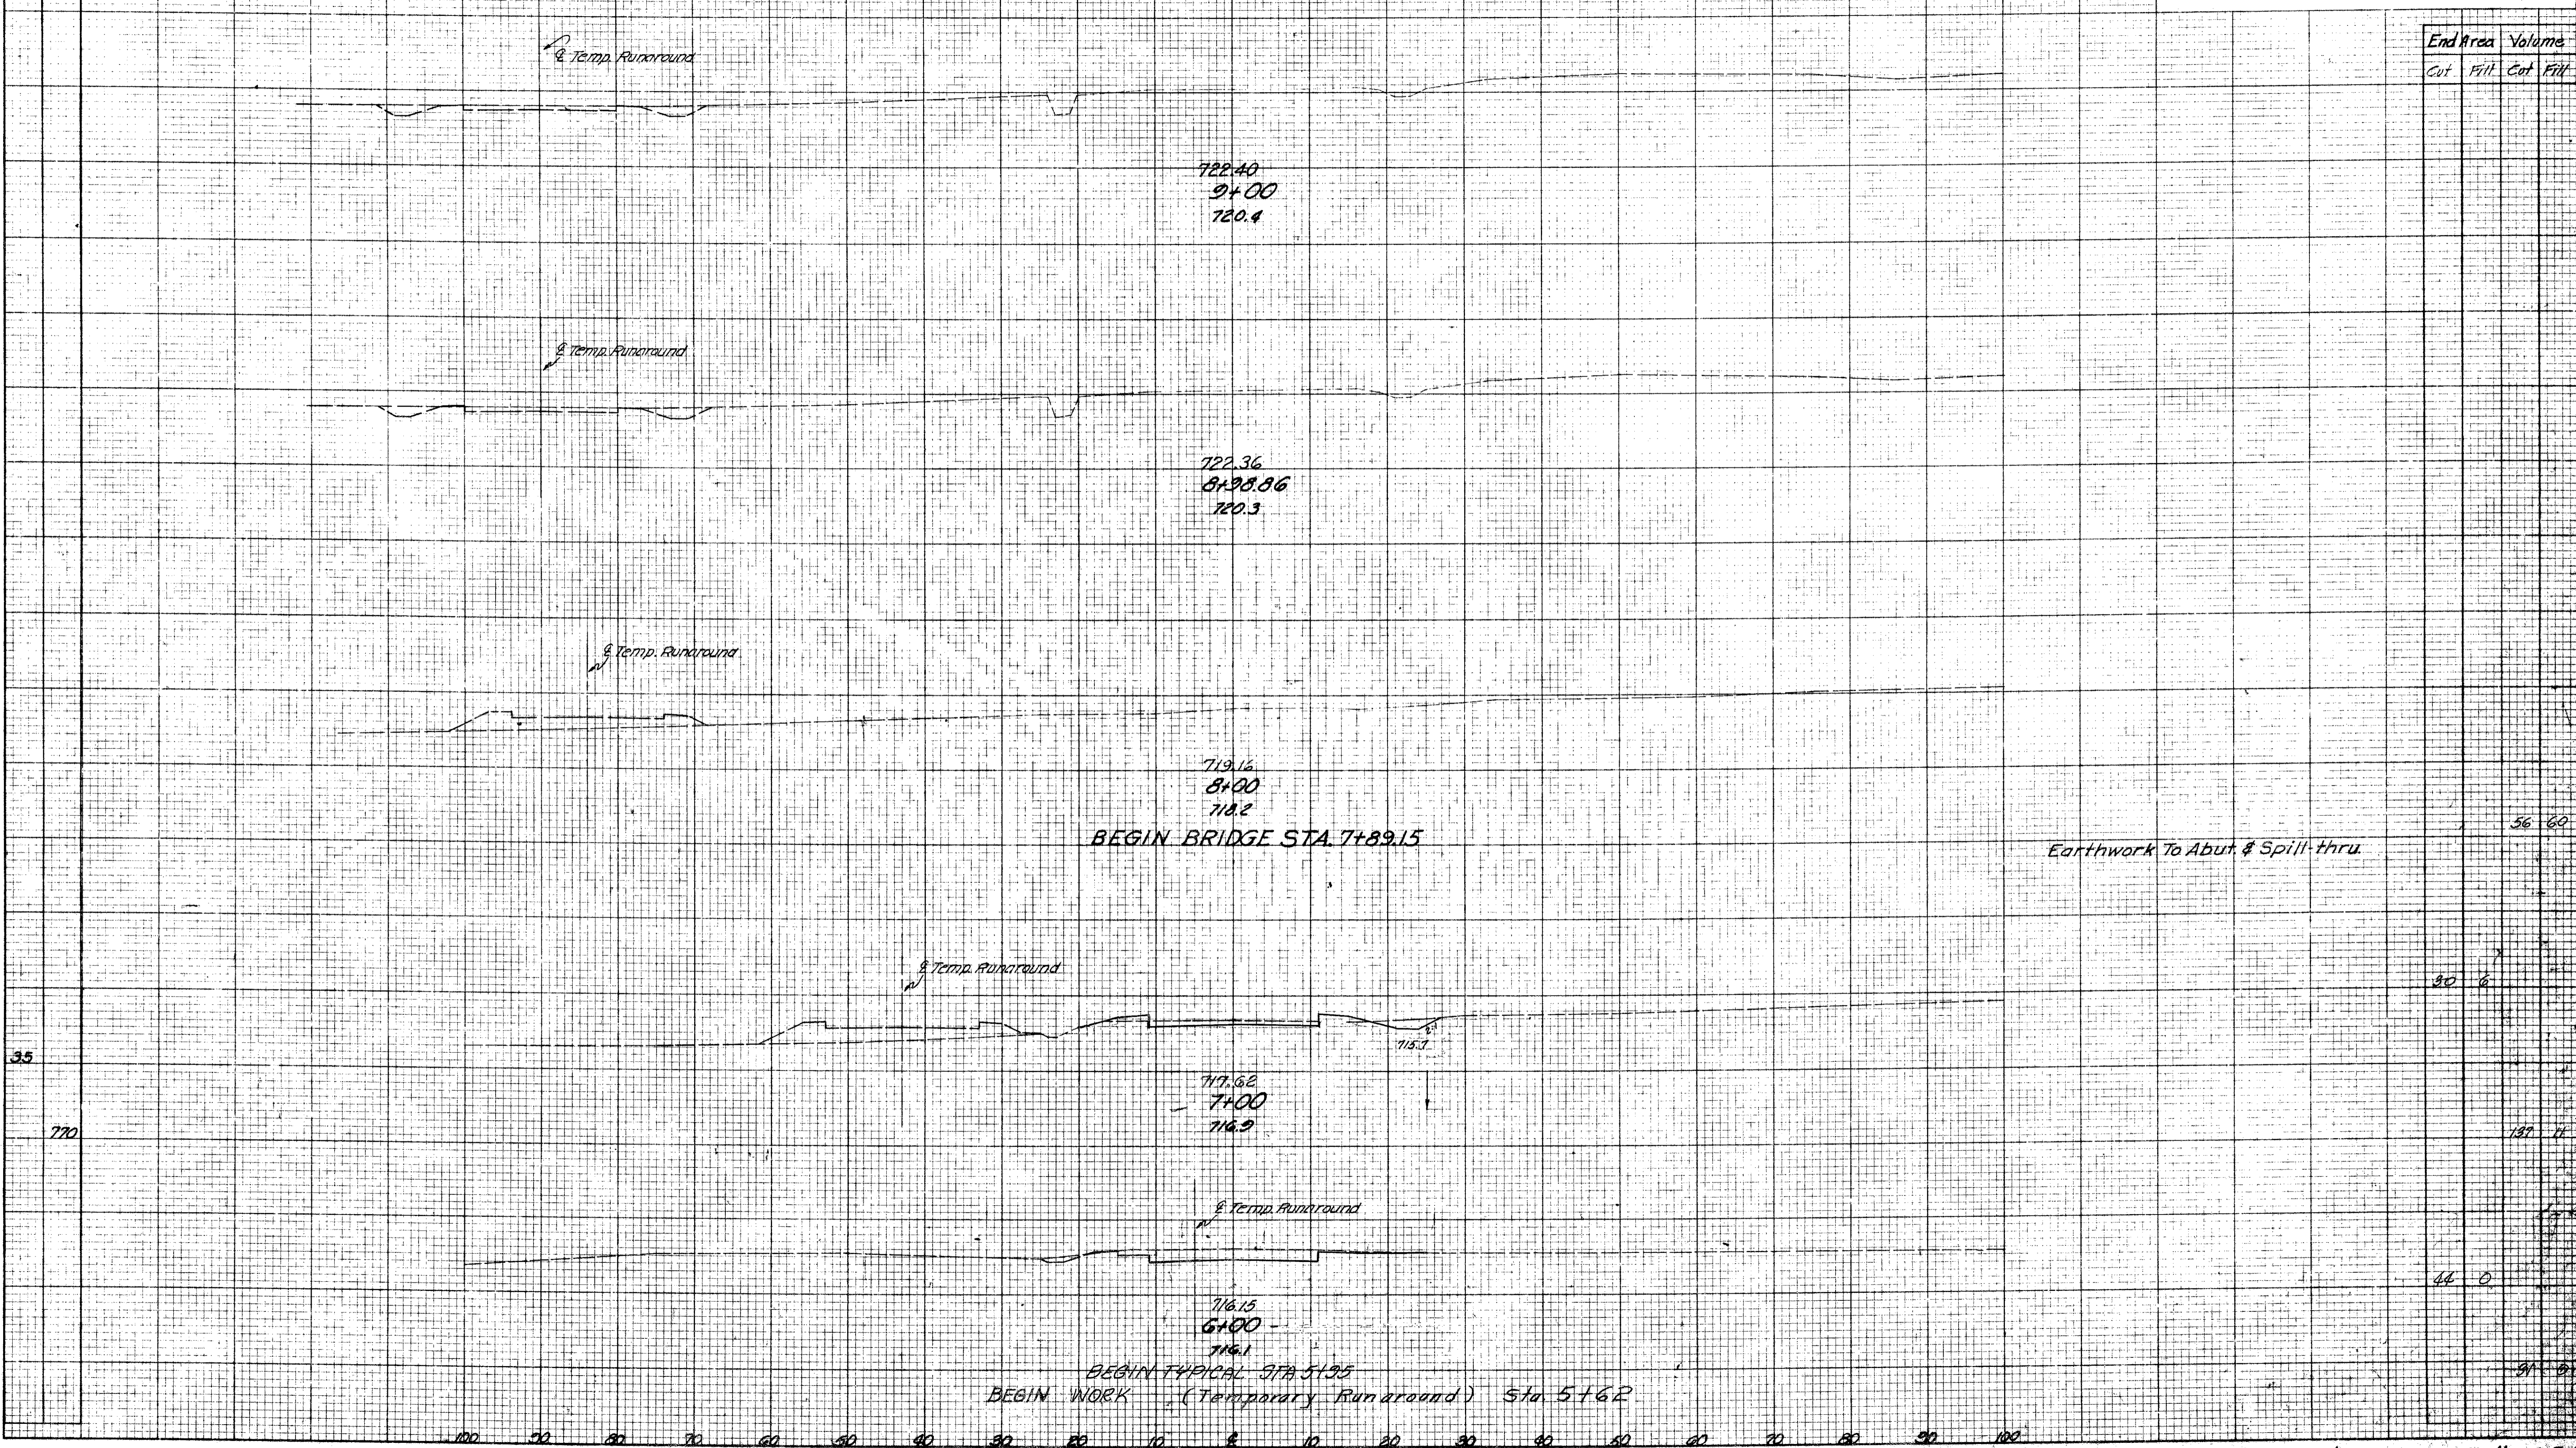

56	60		
30	6		
46	0		
91	0		

Sta. 6+00 to Sta. 9+00 Kirland Rd