

Seeding
End
Width

This sheet supersedes
Sheet No. 182
Added 3-24-60 R.E.C.

FED. RD. DIVISION	STATE	PROJECT
2	OHIO	1-1103(20)

182-5
333

LAKE COUNTY
LAK-1-4.02

44

835

53


End Area		Volume	
Cut	Fill	Cut	Fill

158 16

965 287

99 199

16 107

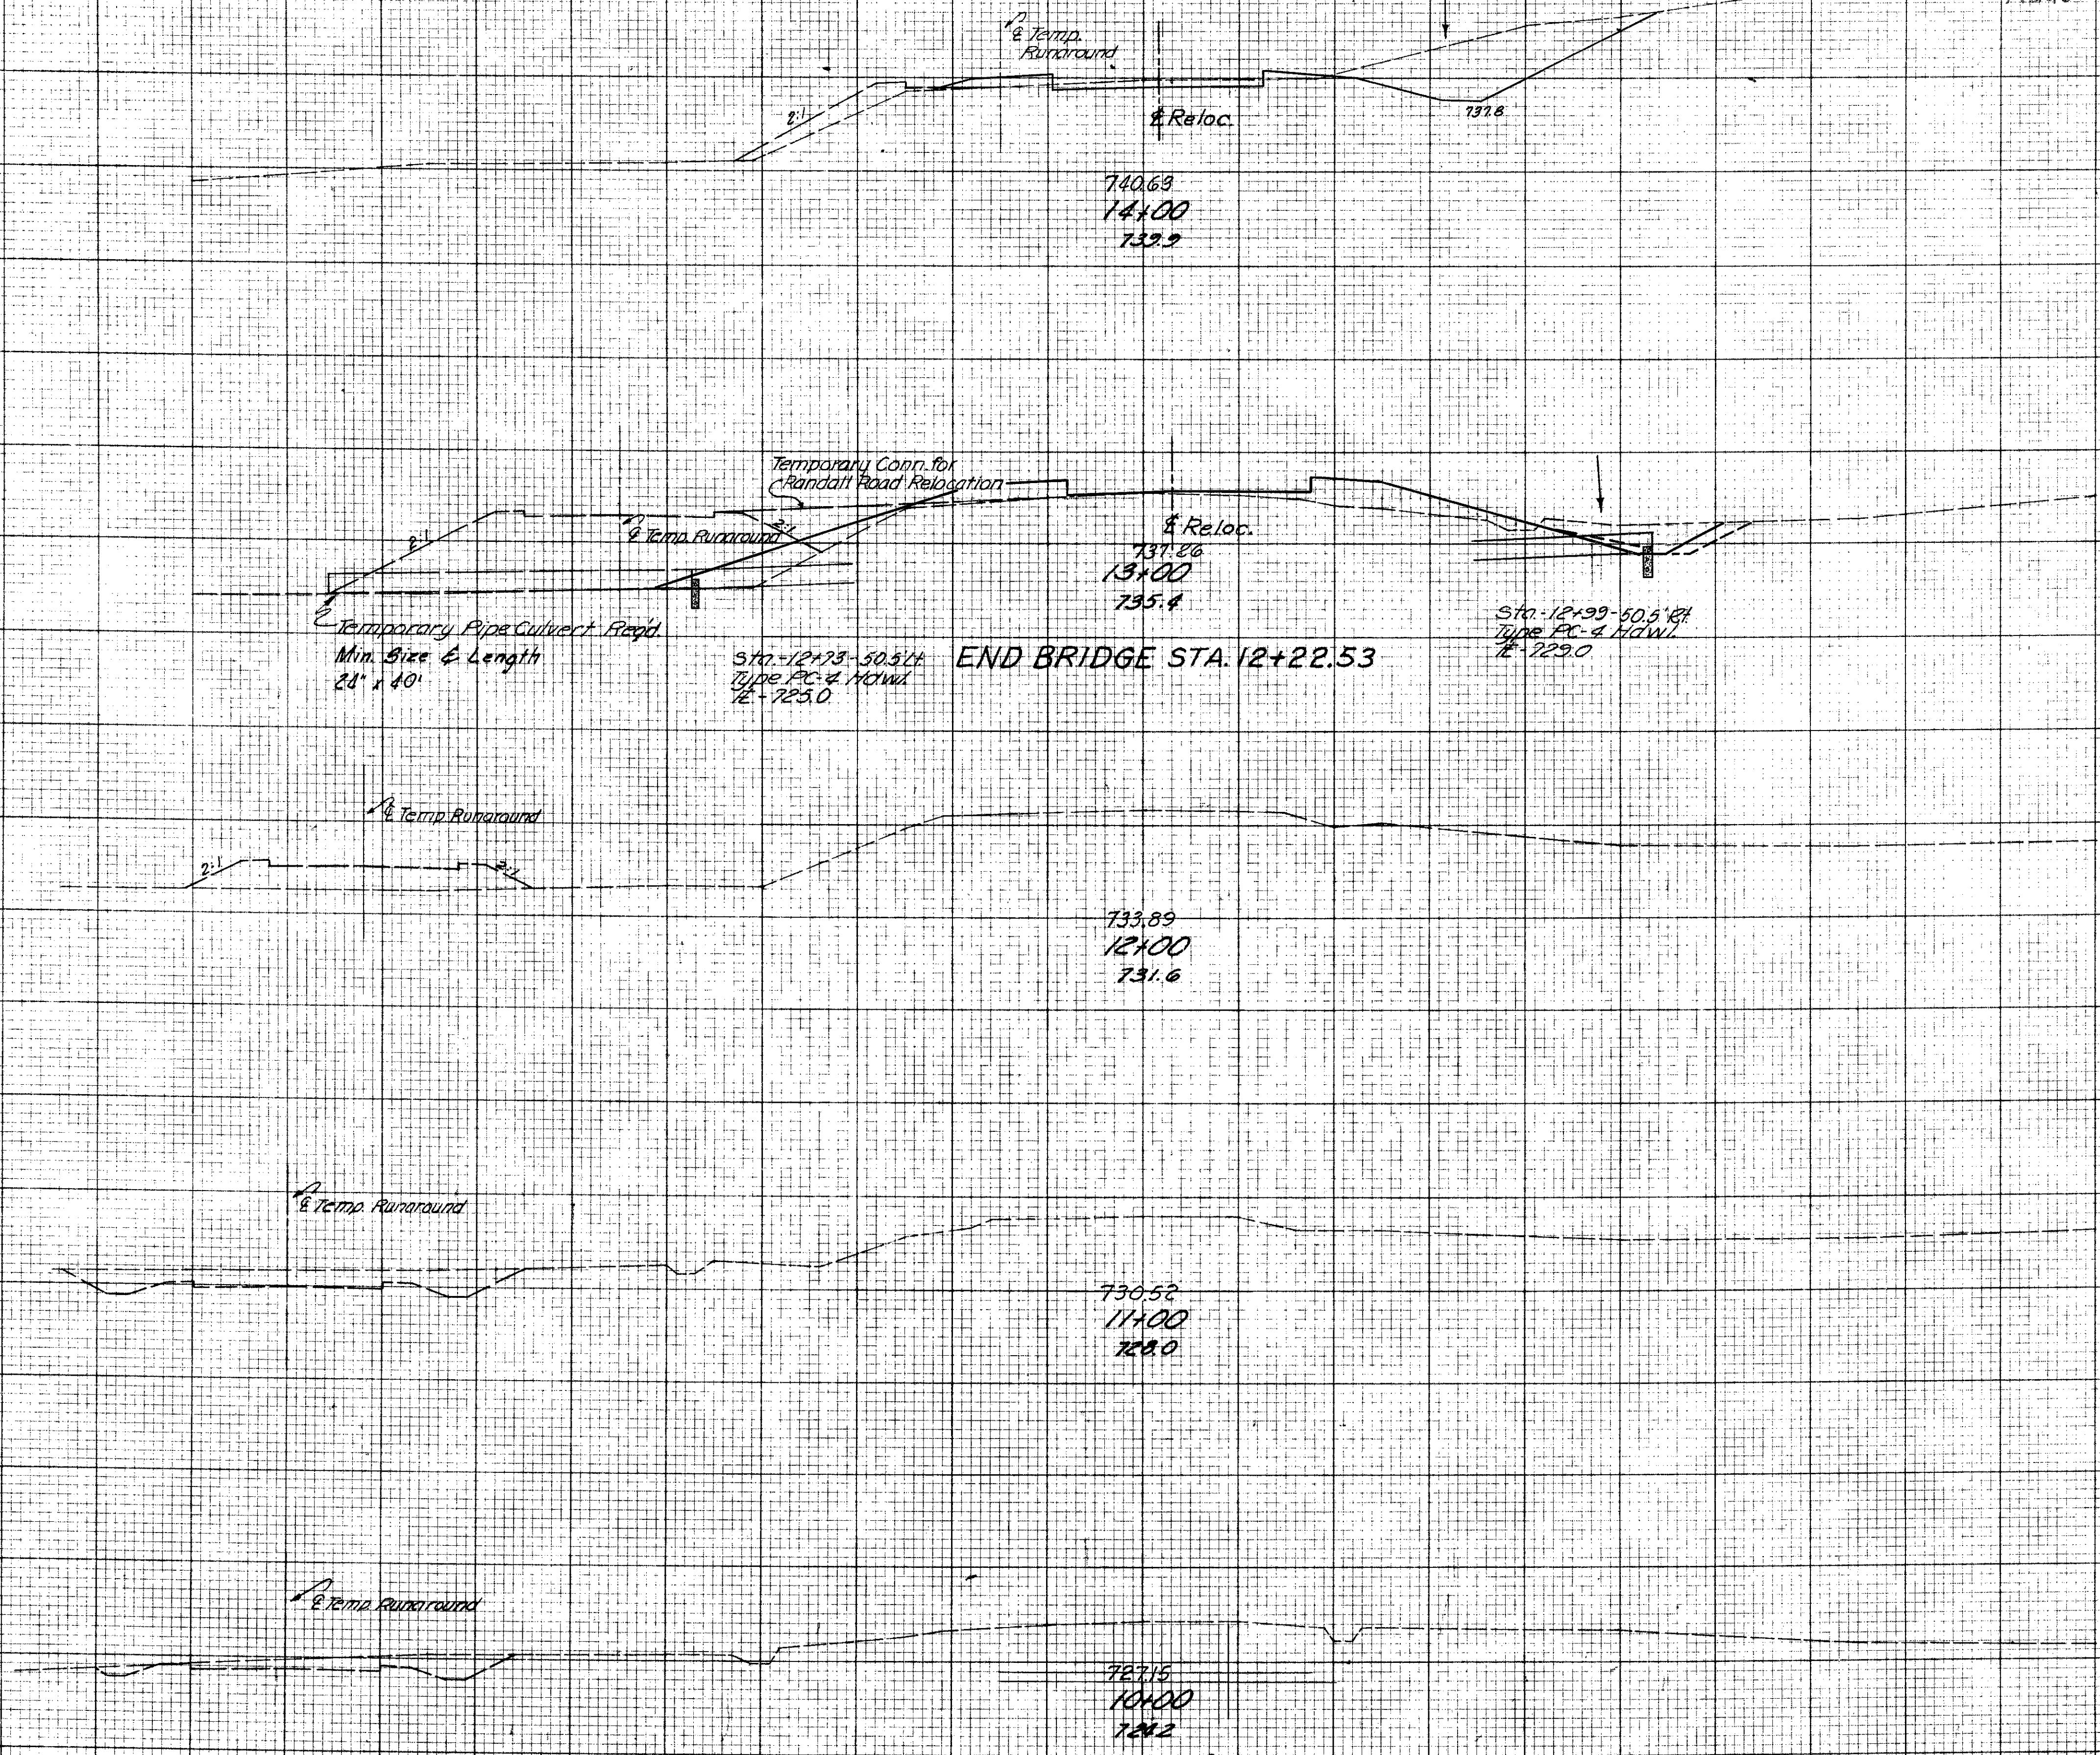

Temporary Pipe Culvert Right
Min. Size & Length
24" x 40'

Sta. 12+73-50.51
Type PC-4 HDWL
12-725.0

END BRIDGE STA. 12+22.53

Sta. 12+99-50.51
Type PC-4 HDWL
12-729.0

Earthwork To Abut. & Spill-thru.

Sta. 10+00 to Sta. 14+00 Kirlland Rd.