


Seeding  
End Area  
width

FED. RD. DIVISION	STATE	PROJECT
2	OHIO	1-1103(20)

189-S  
333

This sheet supercedes  
Sheet No. 189  
Added 3-24-60 R.E.C.

LAKE COUNTY  
LAK-1-4.02

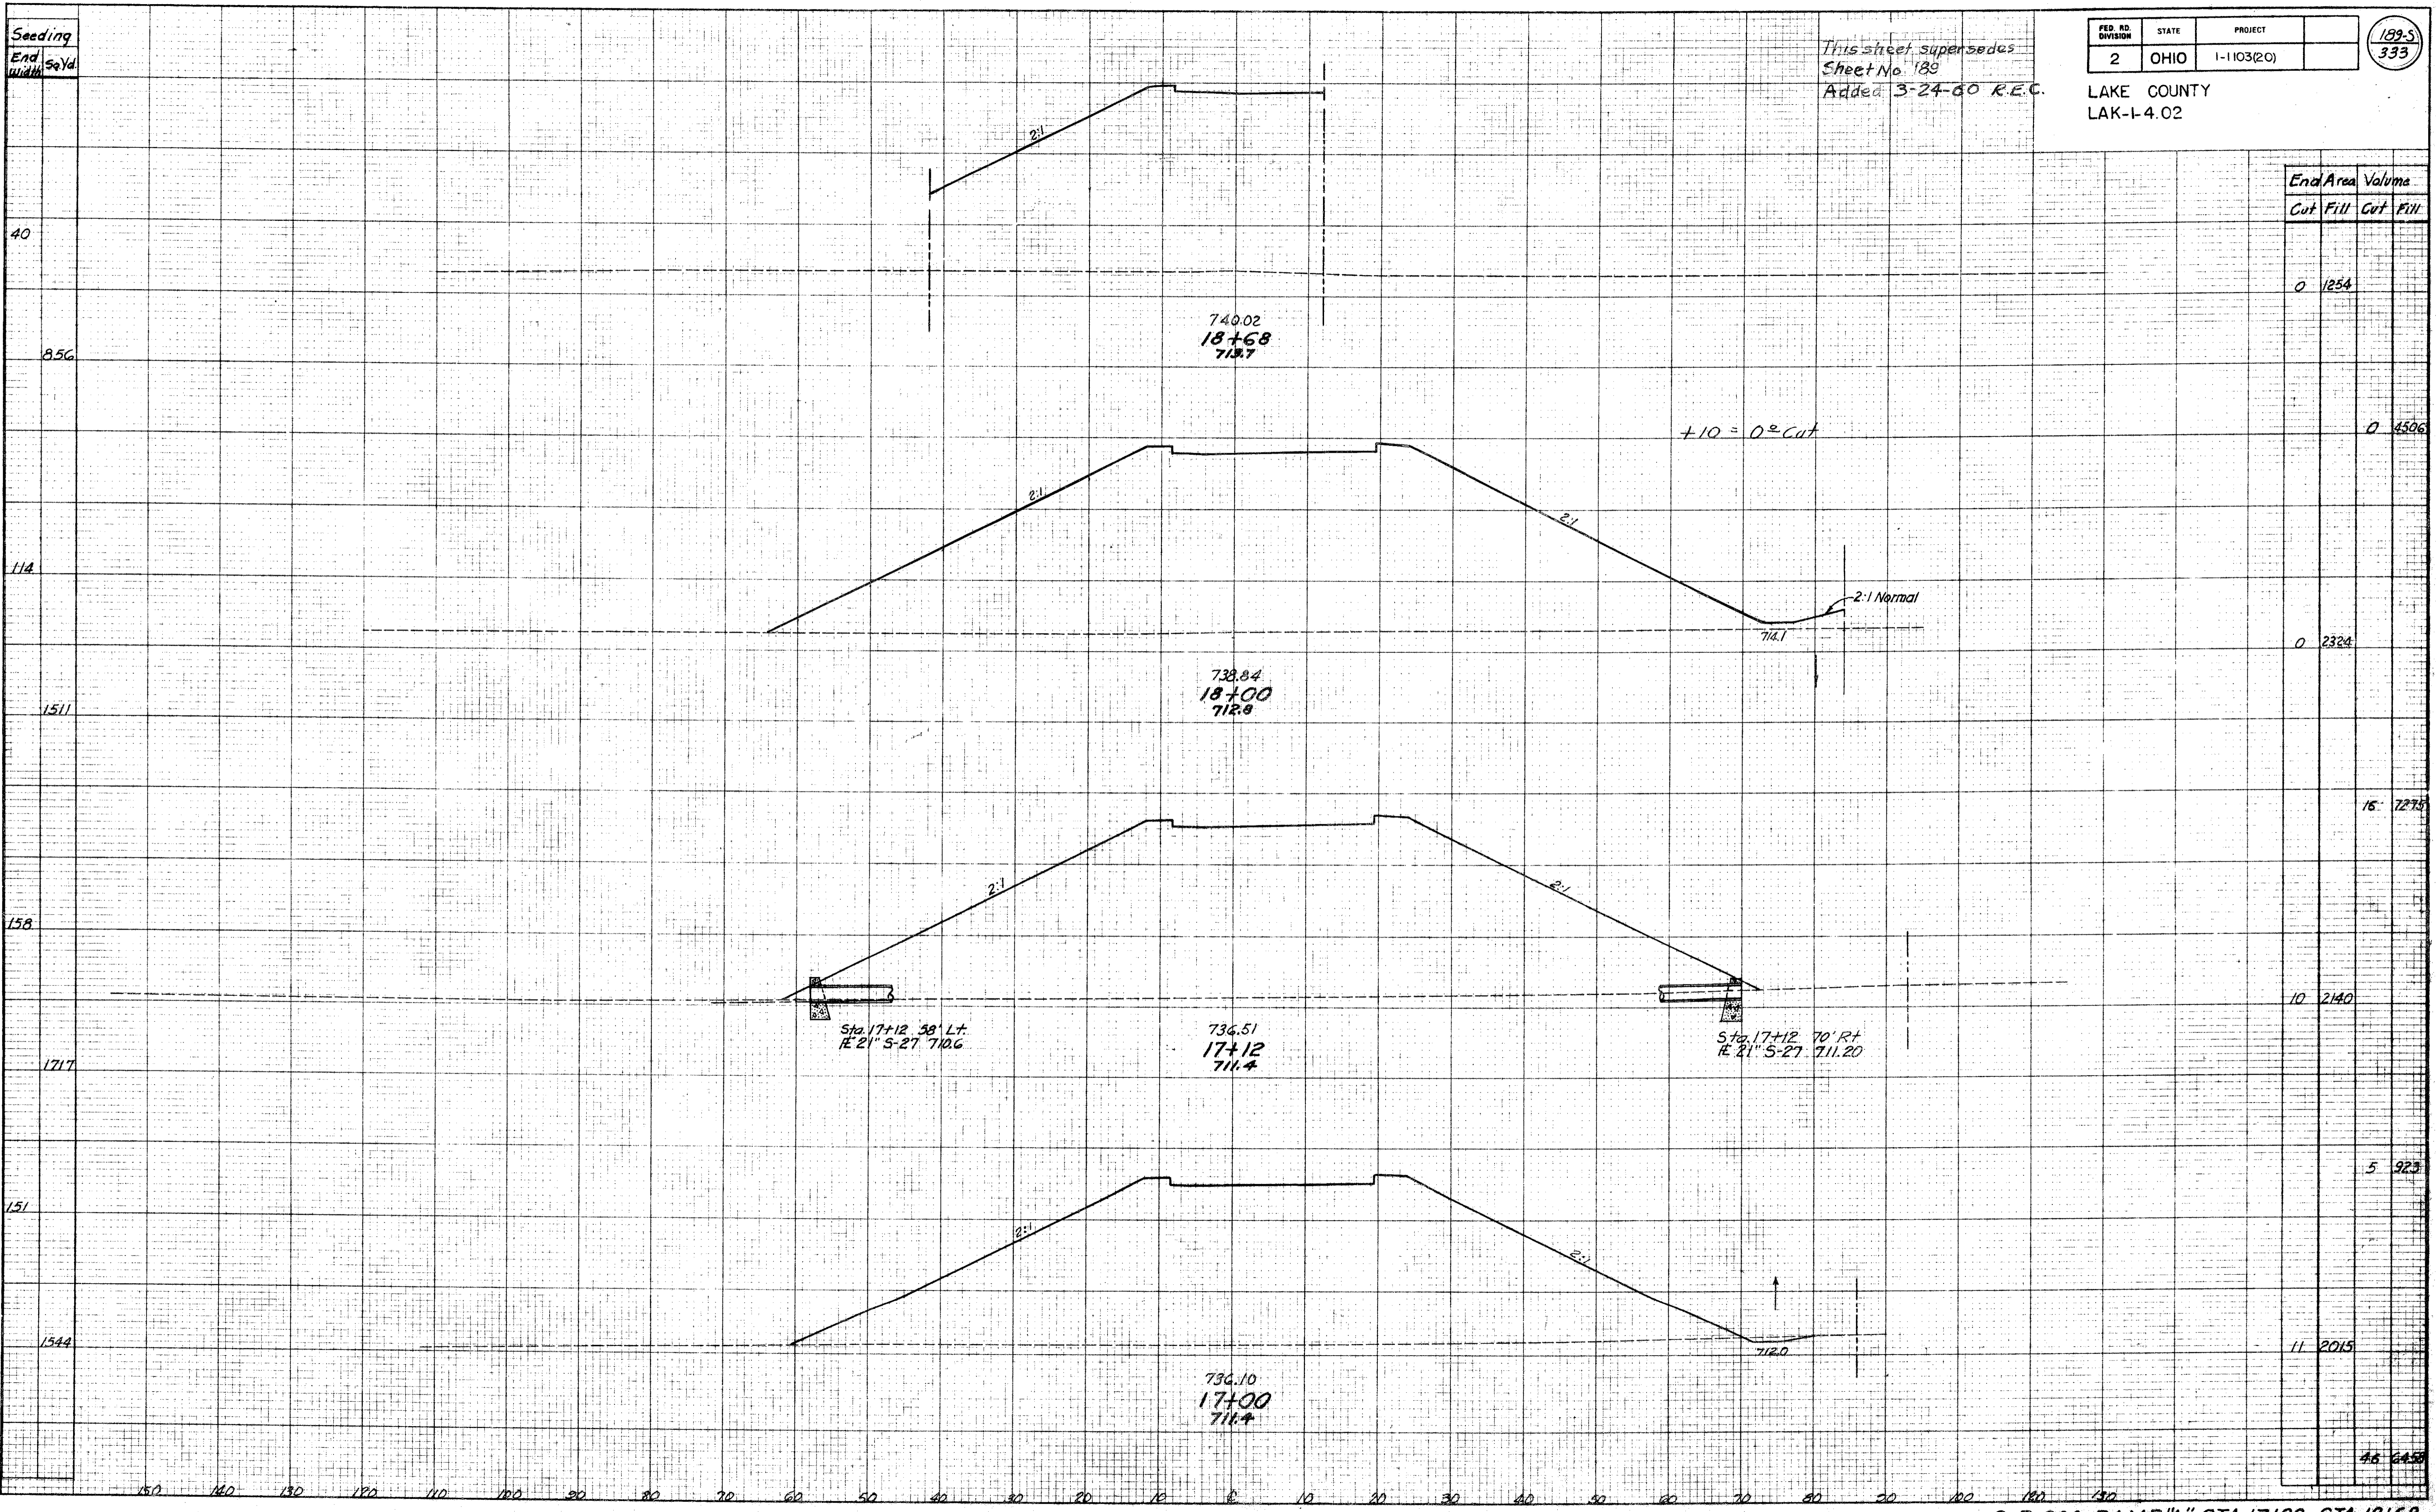

S.R. 306 RAMP 'A' STA. 17+00 - STA. 18+68