

Seeding  
End  
Width Spd.


This sheet superseded  
Sheet No 191  
Added 3-24-60 R.E.C.

FED. RD. DIVISION	STATE	PROJECT
2	OHIC	1-1103(20)

191-S  
333

LAKE COUNTY  
LAK-1-4.02

End Area		Volume	
Cut	Fill	Cut	Fill

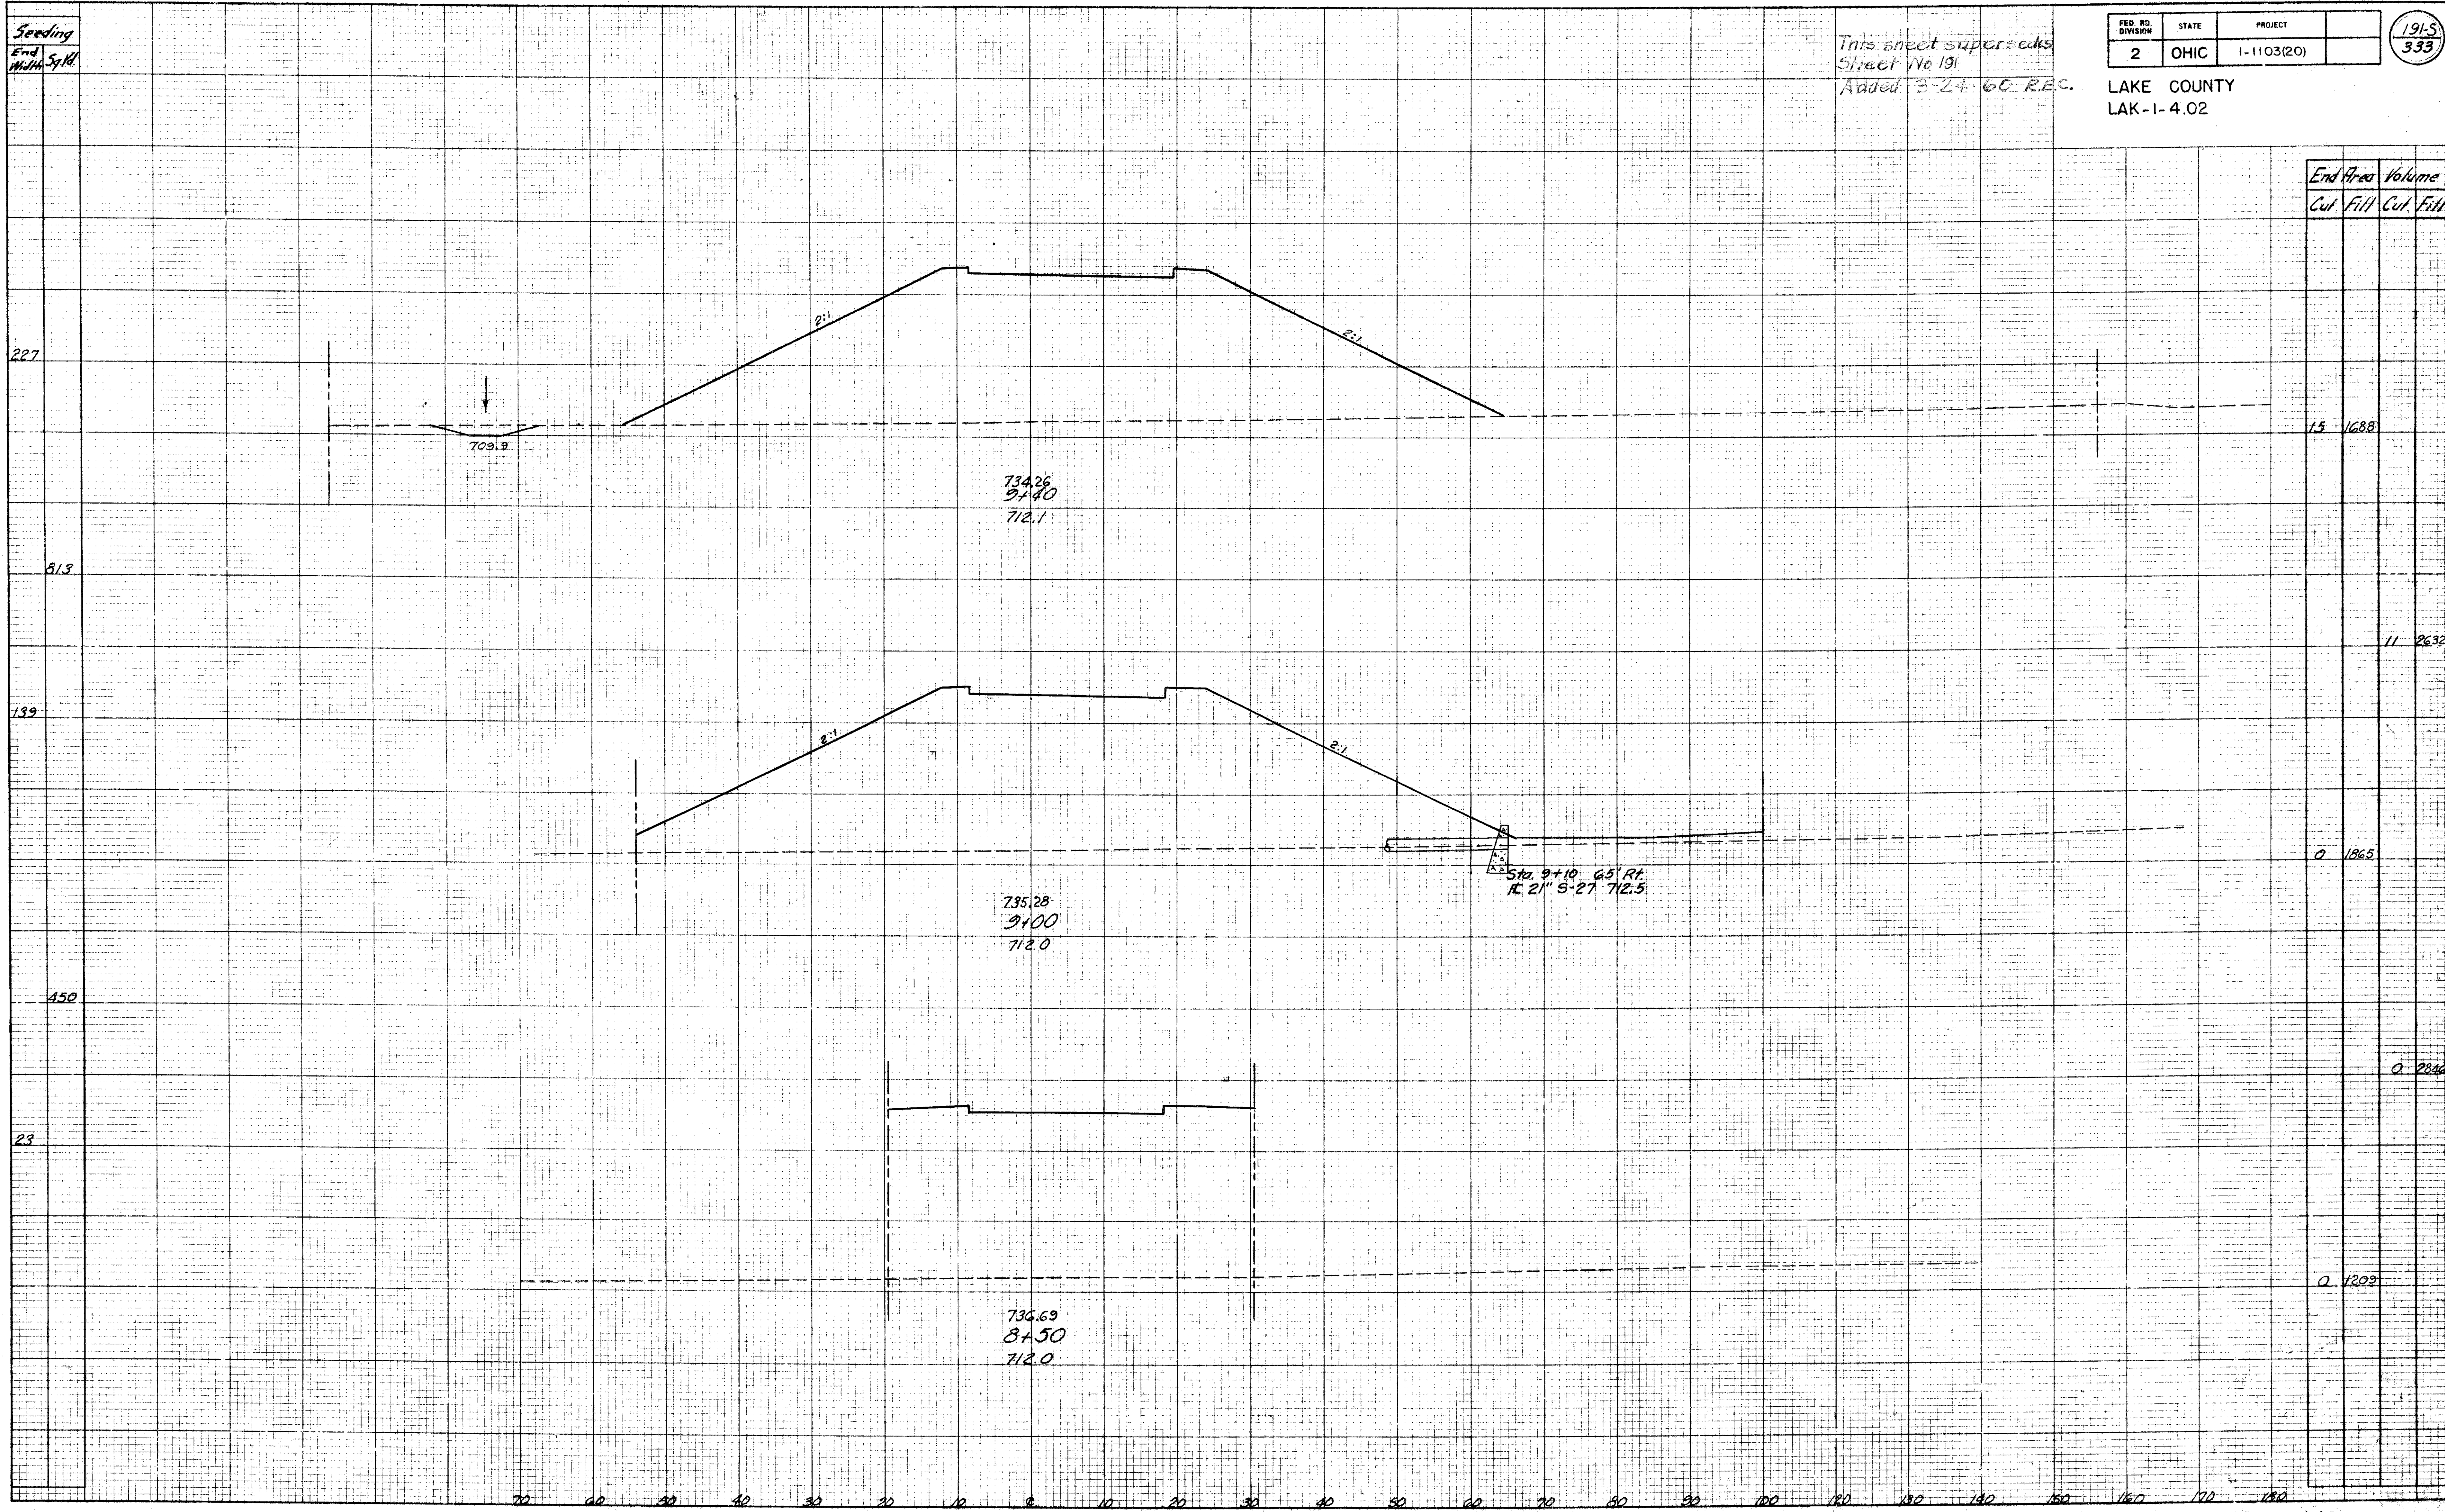

734.26  
9+40  
712.1

735.28  
9+00  
712.0

736.69  
8+50  
712.0

Sta. 9+10 65' RA.  
K 2" S-27 712.5

15 1688

11 2632

0 1865

0 2846

0 1202