


Seeding	End Width	Sq. Ft.
	152	
	1856	
	182	
	2150	
	205	
	2328	
	214	
	1470	

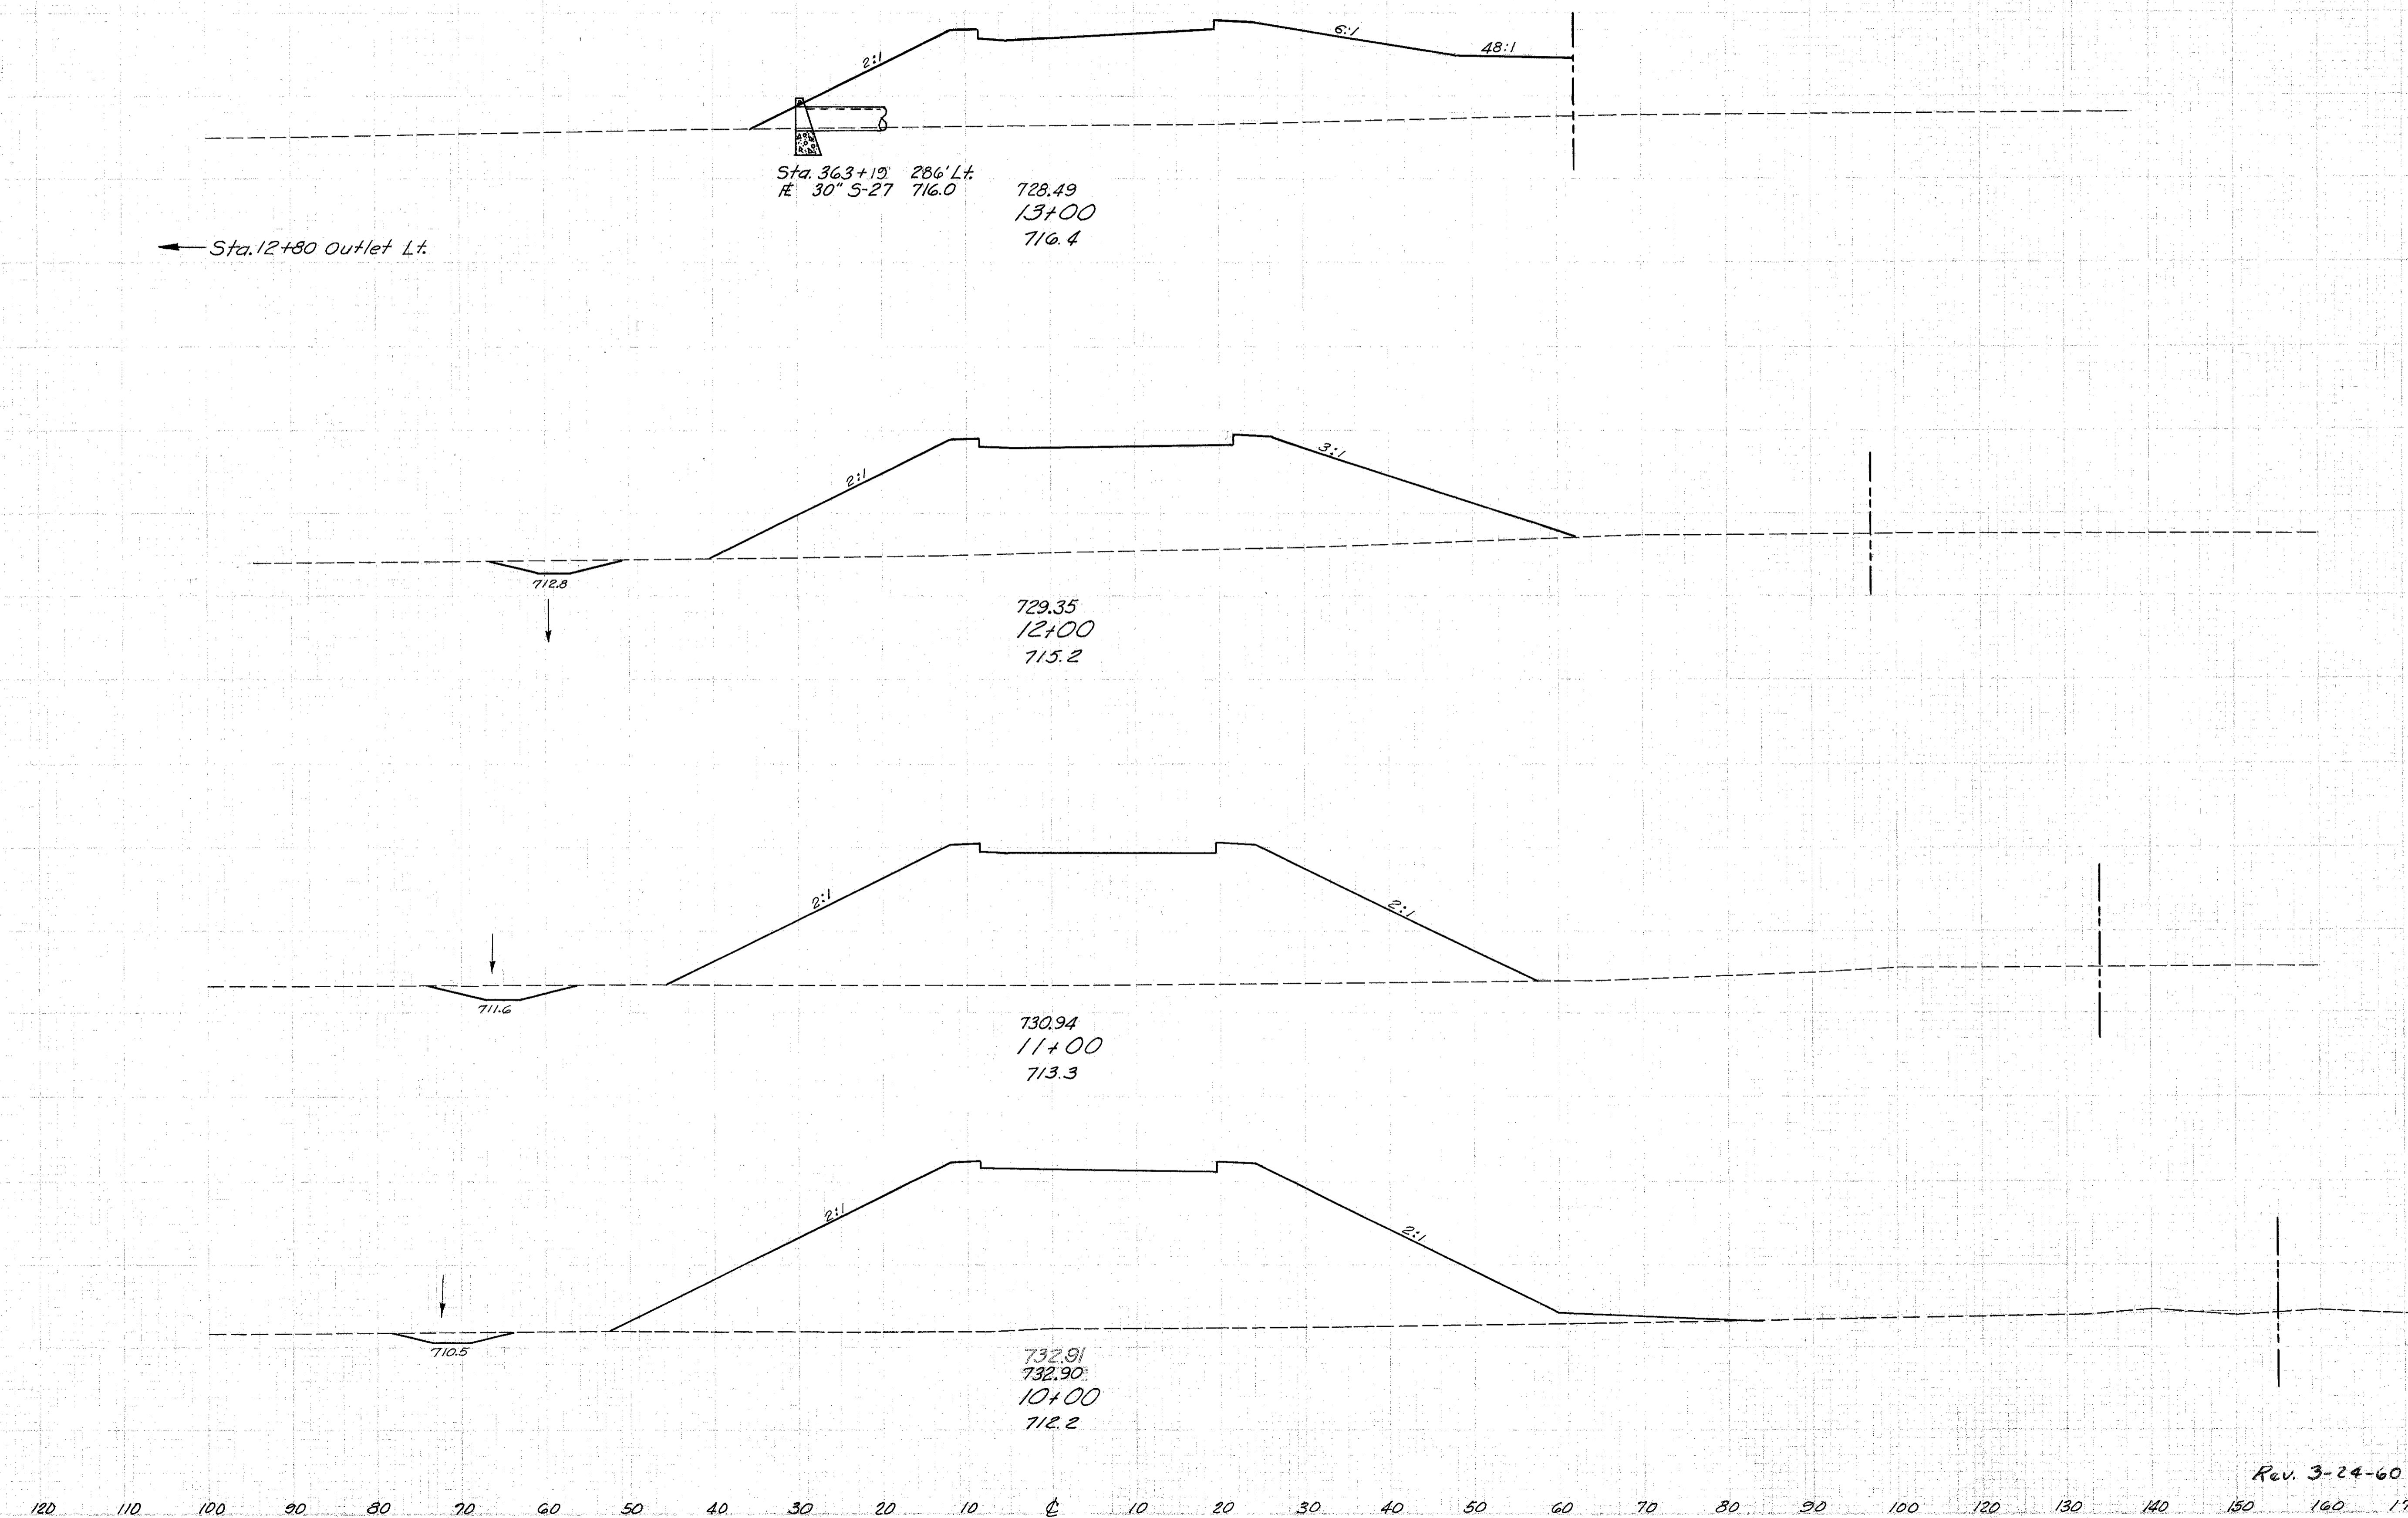

End Area		Volume	
Cut	Fill	Cut	Fill
0	929		
16	934	30	3450
19	1169	65	3895
12	1517	57	4975
		30	3561
		30	3334

Rev. 3-24-60 R.E.C.

S.R. 306 RAMP "B" 10+00-13+00