


Seeding	
End	Sp. 16
Width	
95	
981	
89	
1189	
124	
1533	

2	0-10	1-1103(20)
---	------	------------

193
333

LAKE COUNTY
LAK-I-4.02

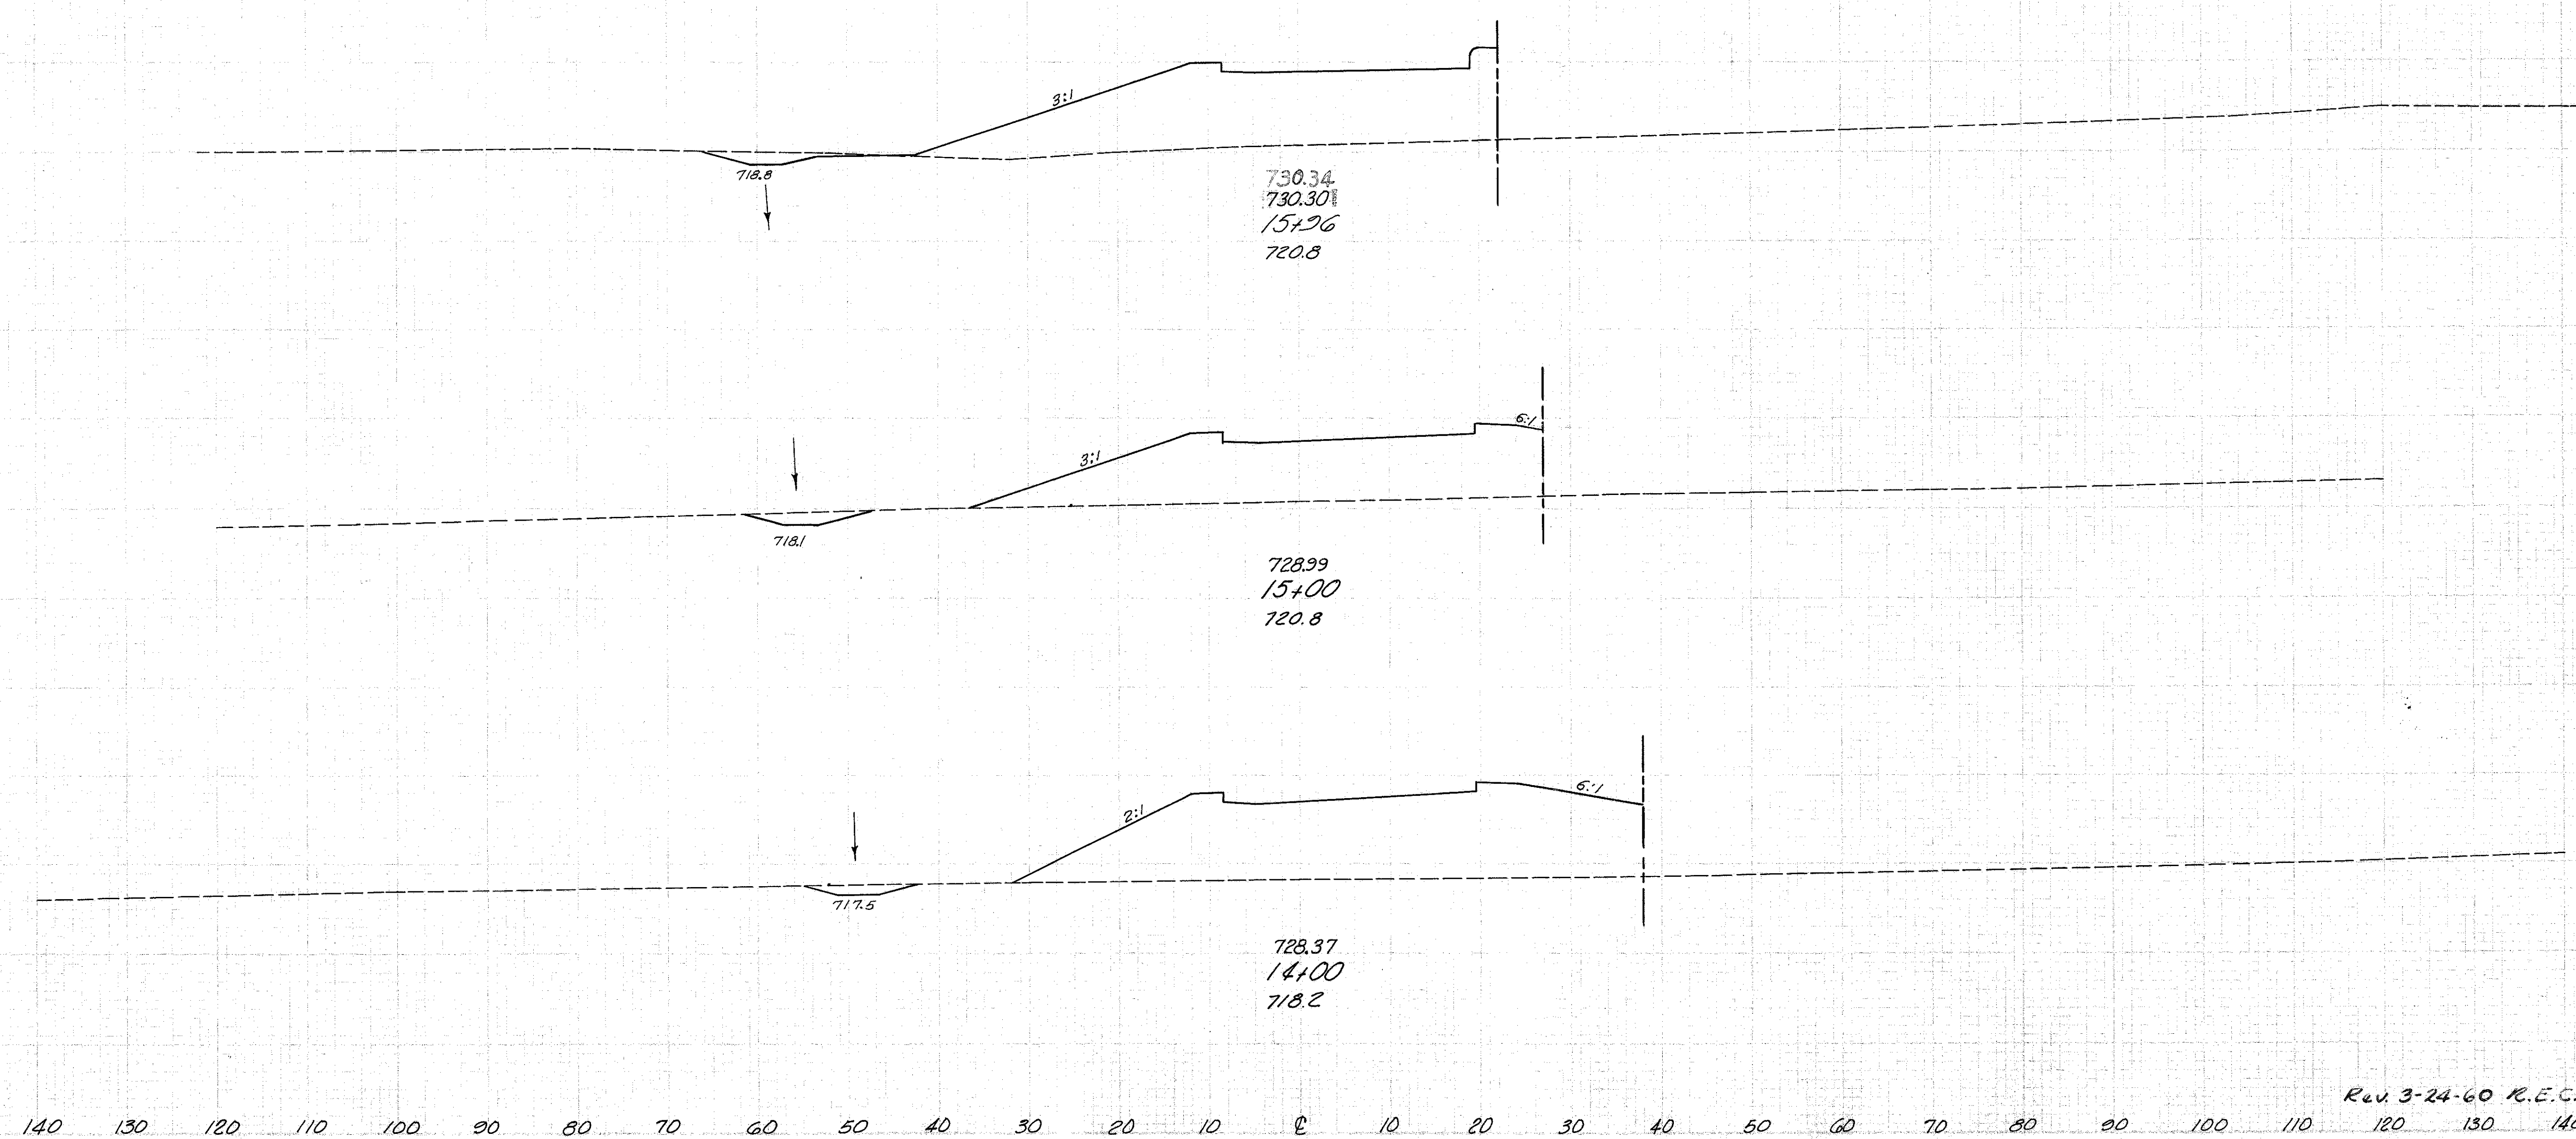

End Area		Volume	
Cut	Fill	Cut	Fill
16	514	53	1687
14	435	45	1965
11	626	20	2880