


Seeding
End
Width Sp. 1/2

This sheet supersedes
Sheet No. 139
Added 3-24-60 R.E.C.

FED. RD. DIVISION	STATE	PROJECT
2	OHIO	1-1103(20)

199.5
333

LAKE COUNTY
LAK -1-4.02

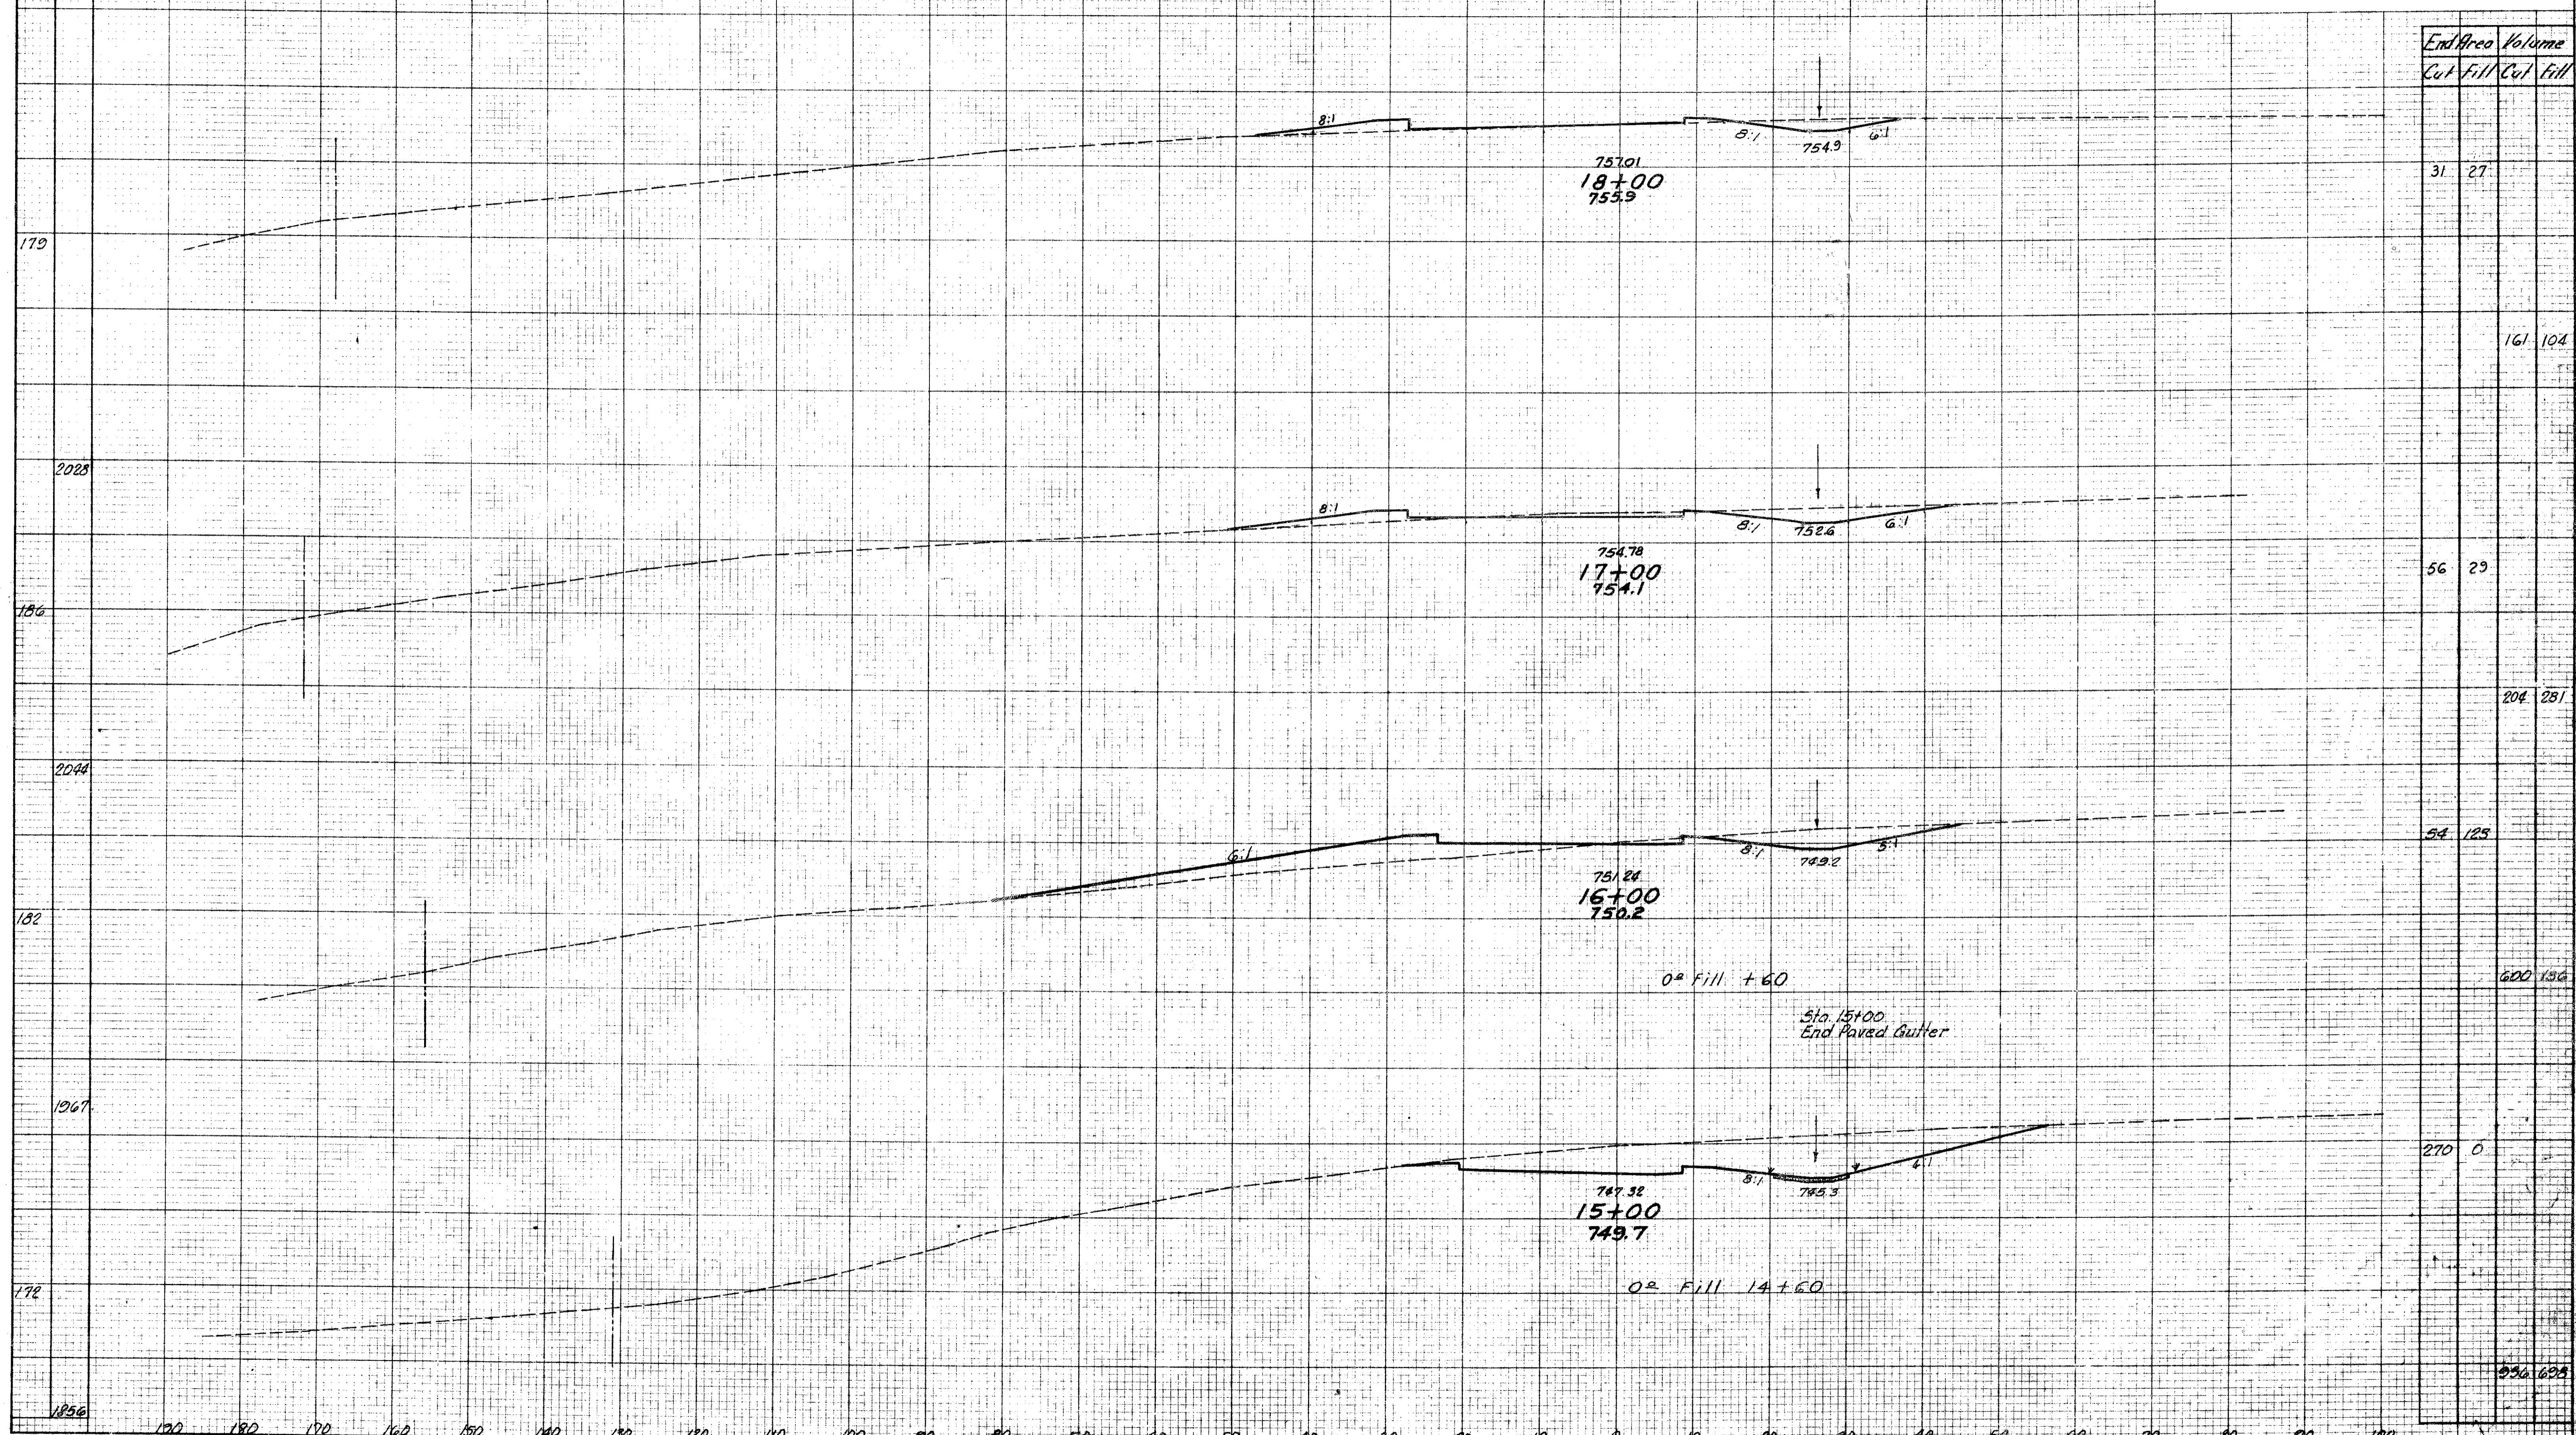

End Area		Volume	
Cut	Fill	Cut	Fill

		31	27
		161	104
		56	29
		204	231
		54	123
		600	136
		270	0
		556	629