

Seeding  
End  
Width Spd.


This sheet supervised  
Sheet No. 200  
Added 3-24-60 R.E.C.

FED. RD. DIVISION	STATE	PROJECT
2	OHIO	I-1103(20)

2005  
333

LAKE COUNTY  
LAK-I-4.02

End Area		Volume	
Cut	Fill	Cut	Fill

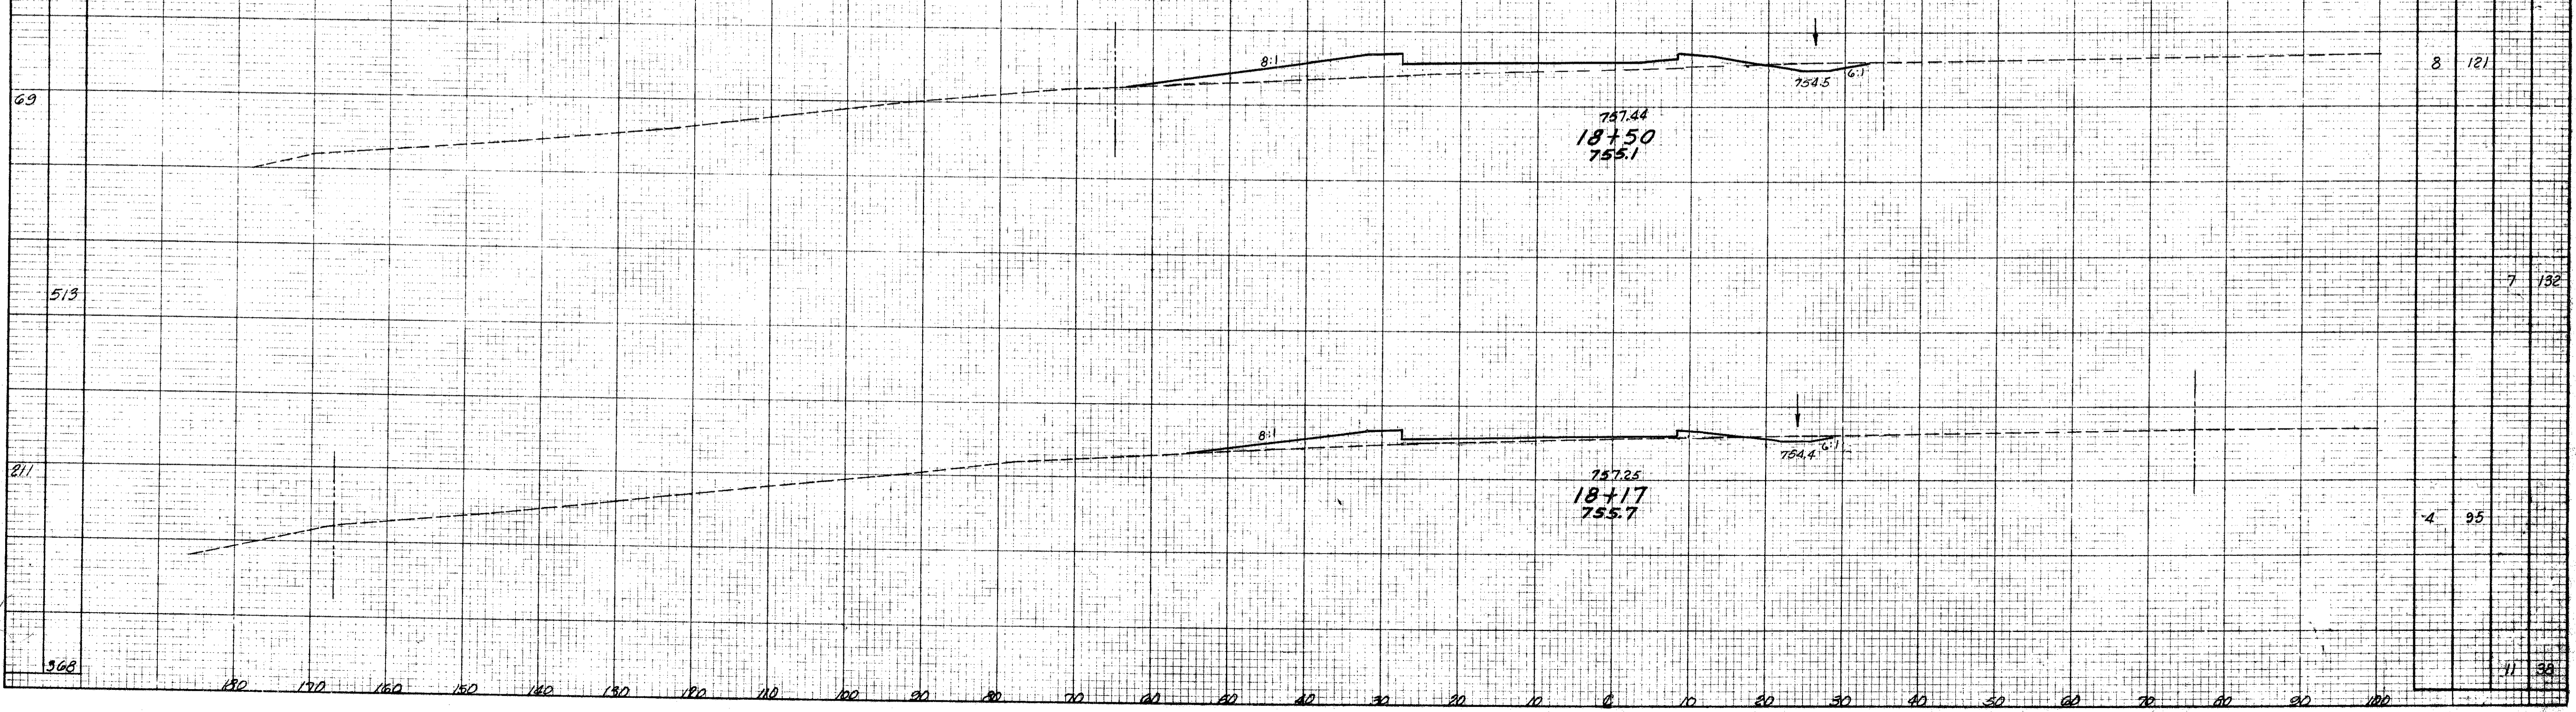

8	121		
7	132		
4	95		
11	38		

SR 306 RAMP "C" STA. 18+17- STA. 18+50