


Seeding  
Erod  
Width Sp. N.

This sheet superseded  
Sheet No. 205  
Added 3-24-00 R.E.C.

FED. RD. DIVISION	STATE	PROJECT
2	OHIO	1-1103(20)

203-5  
333

LAKE COUNTY  
LAK-1-4.02

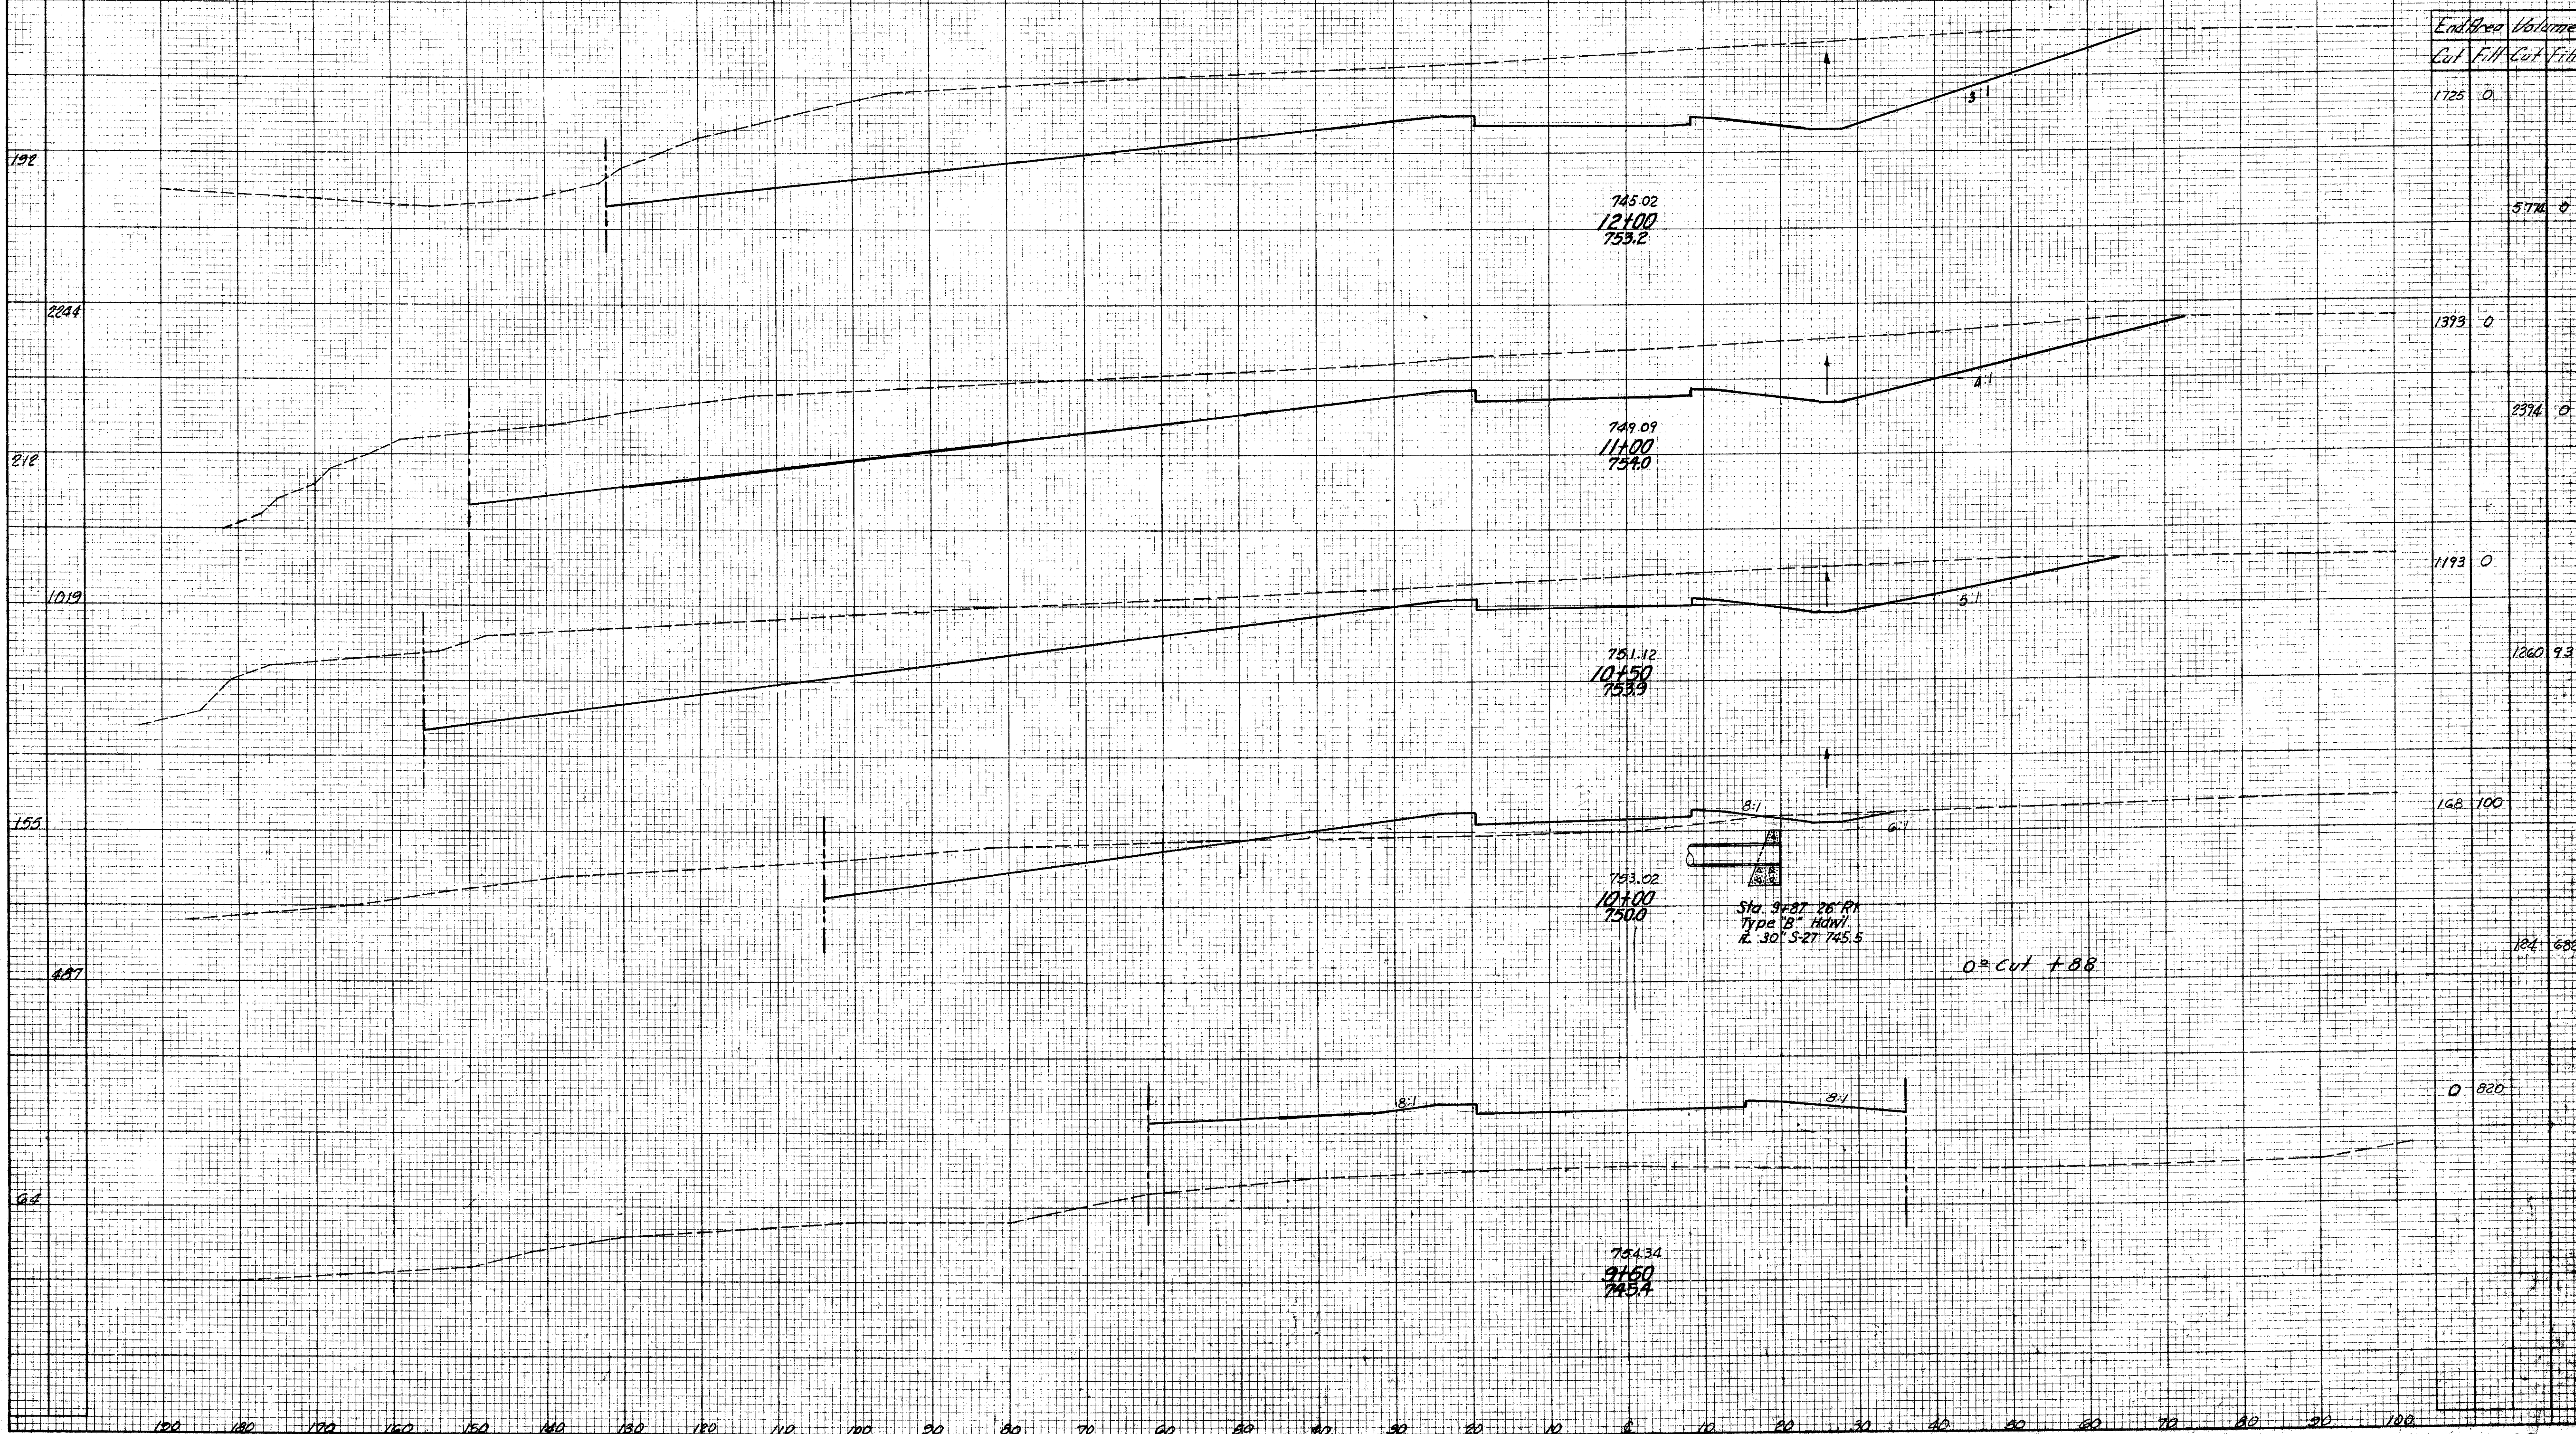

745.02  
12+00  
753.2

749.09  
11+00  
754.0

751.12  
10+50  
753.9

743.02  
10+00  
750.0

744.34  
9+50  
745.4

Sta 9+87 26' RT  
Type 'B' Hdwy  
R. 30' S 27' 745.5

0+ Cut + 88