


Feeding
End
Width Spd.

This sheet supersedes
Sheet No. 204
Added 3-24-60 R.E.C.

FED. RD. DIVISION	STATE	PROJECT
2	OHIO	1-1103 (20)

2045
333

LAKE COUNTY
LAK-1-4.02

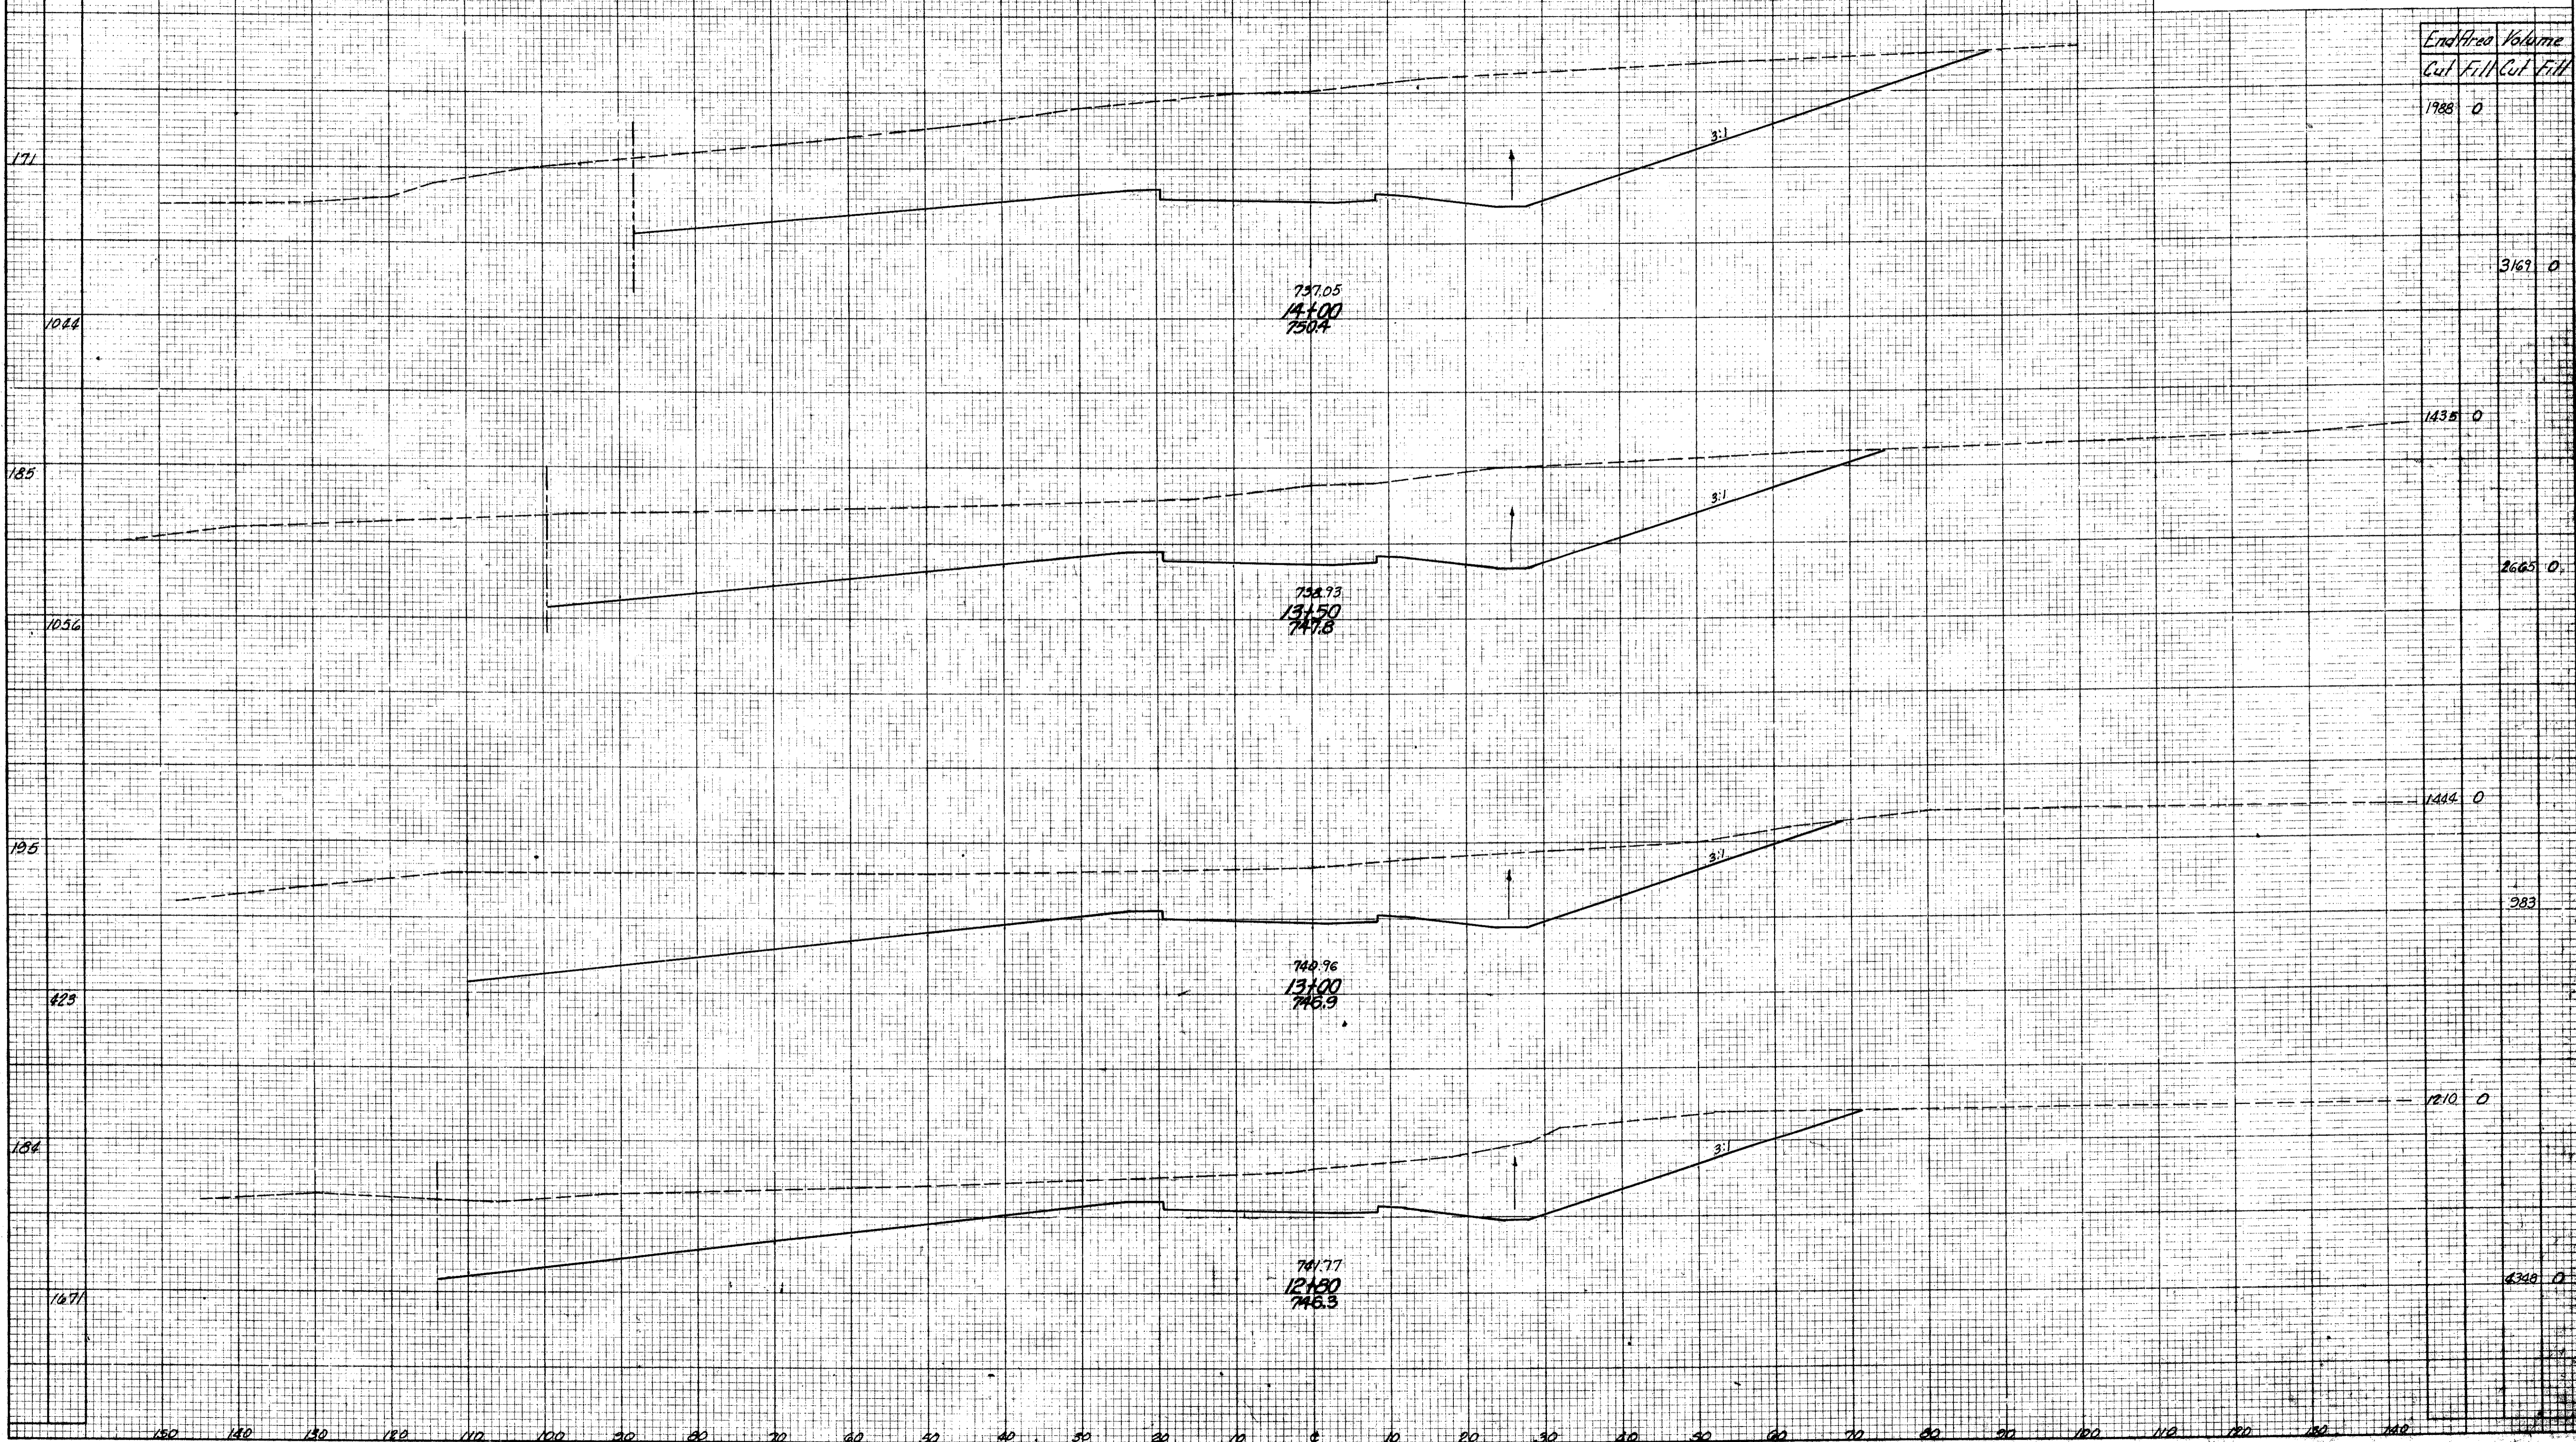

End Area	Volume
Cut	Fill

1988	0
3169	0
1435	0
2665	0
1444	0
283	0
1210	0
4240	0