


Seeding	
End	Sp. No.
63	
700	
63	
711	
65	
667	
55	
667	

LAKE COUNTY
LAK-1-4.02*

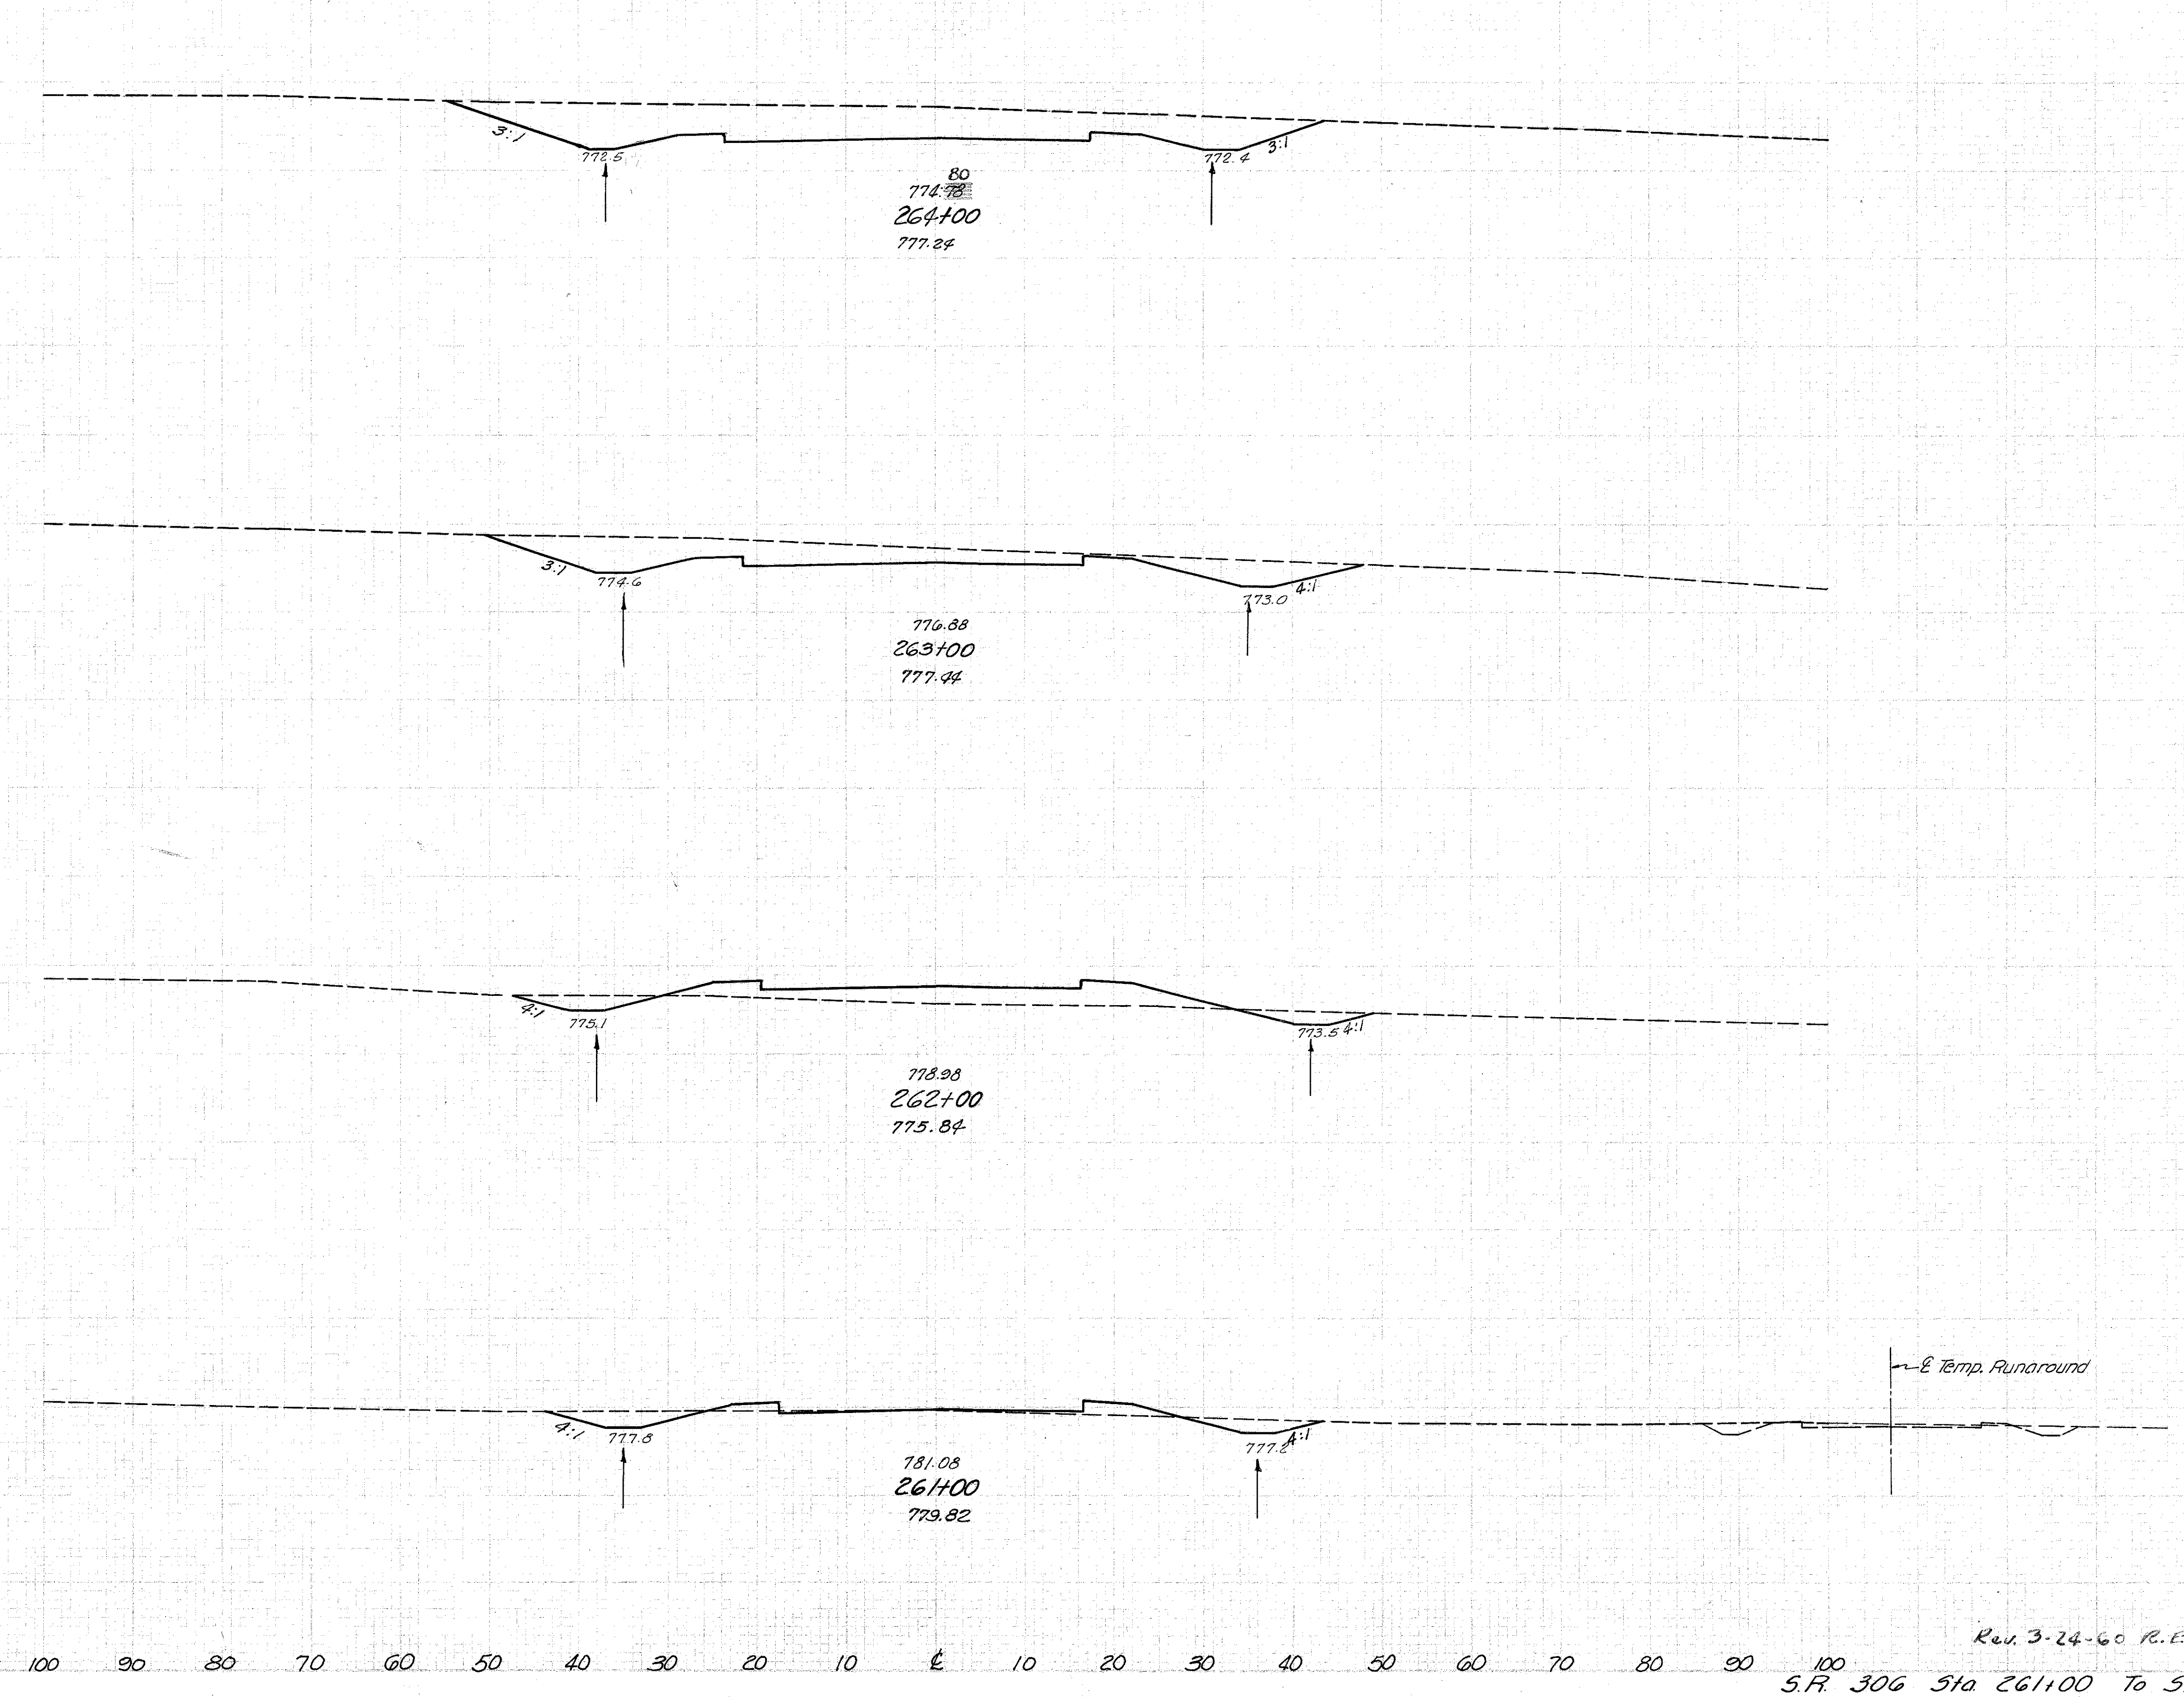

End Area		Volume	
Cut	Fill	Cut	Fill
532	0		
		975	0
194	0		
		425	200
35	108		
		133	248
35	26		
		244	59

Rev. 3-24-60 R.E.C.

S.R. 306 Sta 261+00 To Sta 264+00