


Seeding
End
Width Sq. Ft.

This sheet supersedes
Sheet No. 219
Added 3-24-60 R.E.C.

FED. RD. DIVISION	STATE	PROJECT	219.5 333
2	OHIO	S-46(7) I-1103(20)	

LAKE COUNTY
LAK-1-4.02

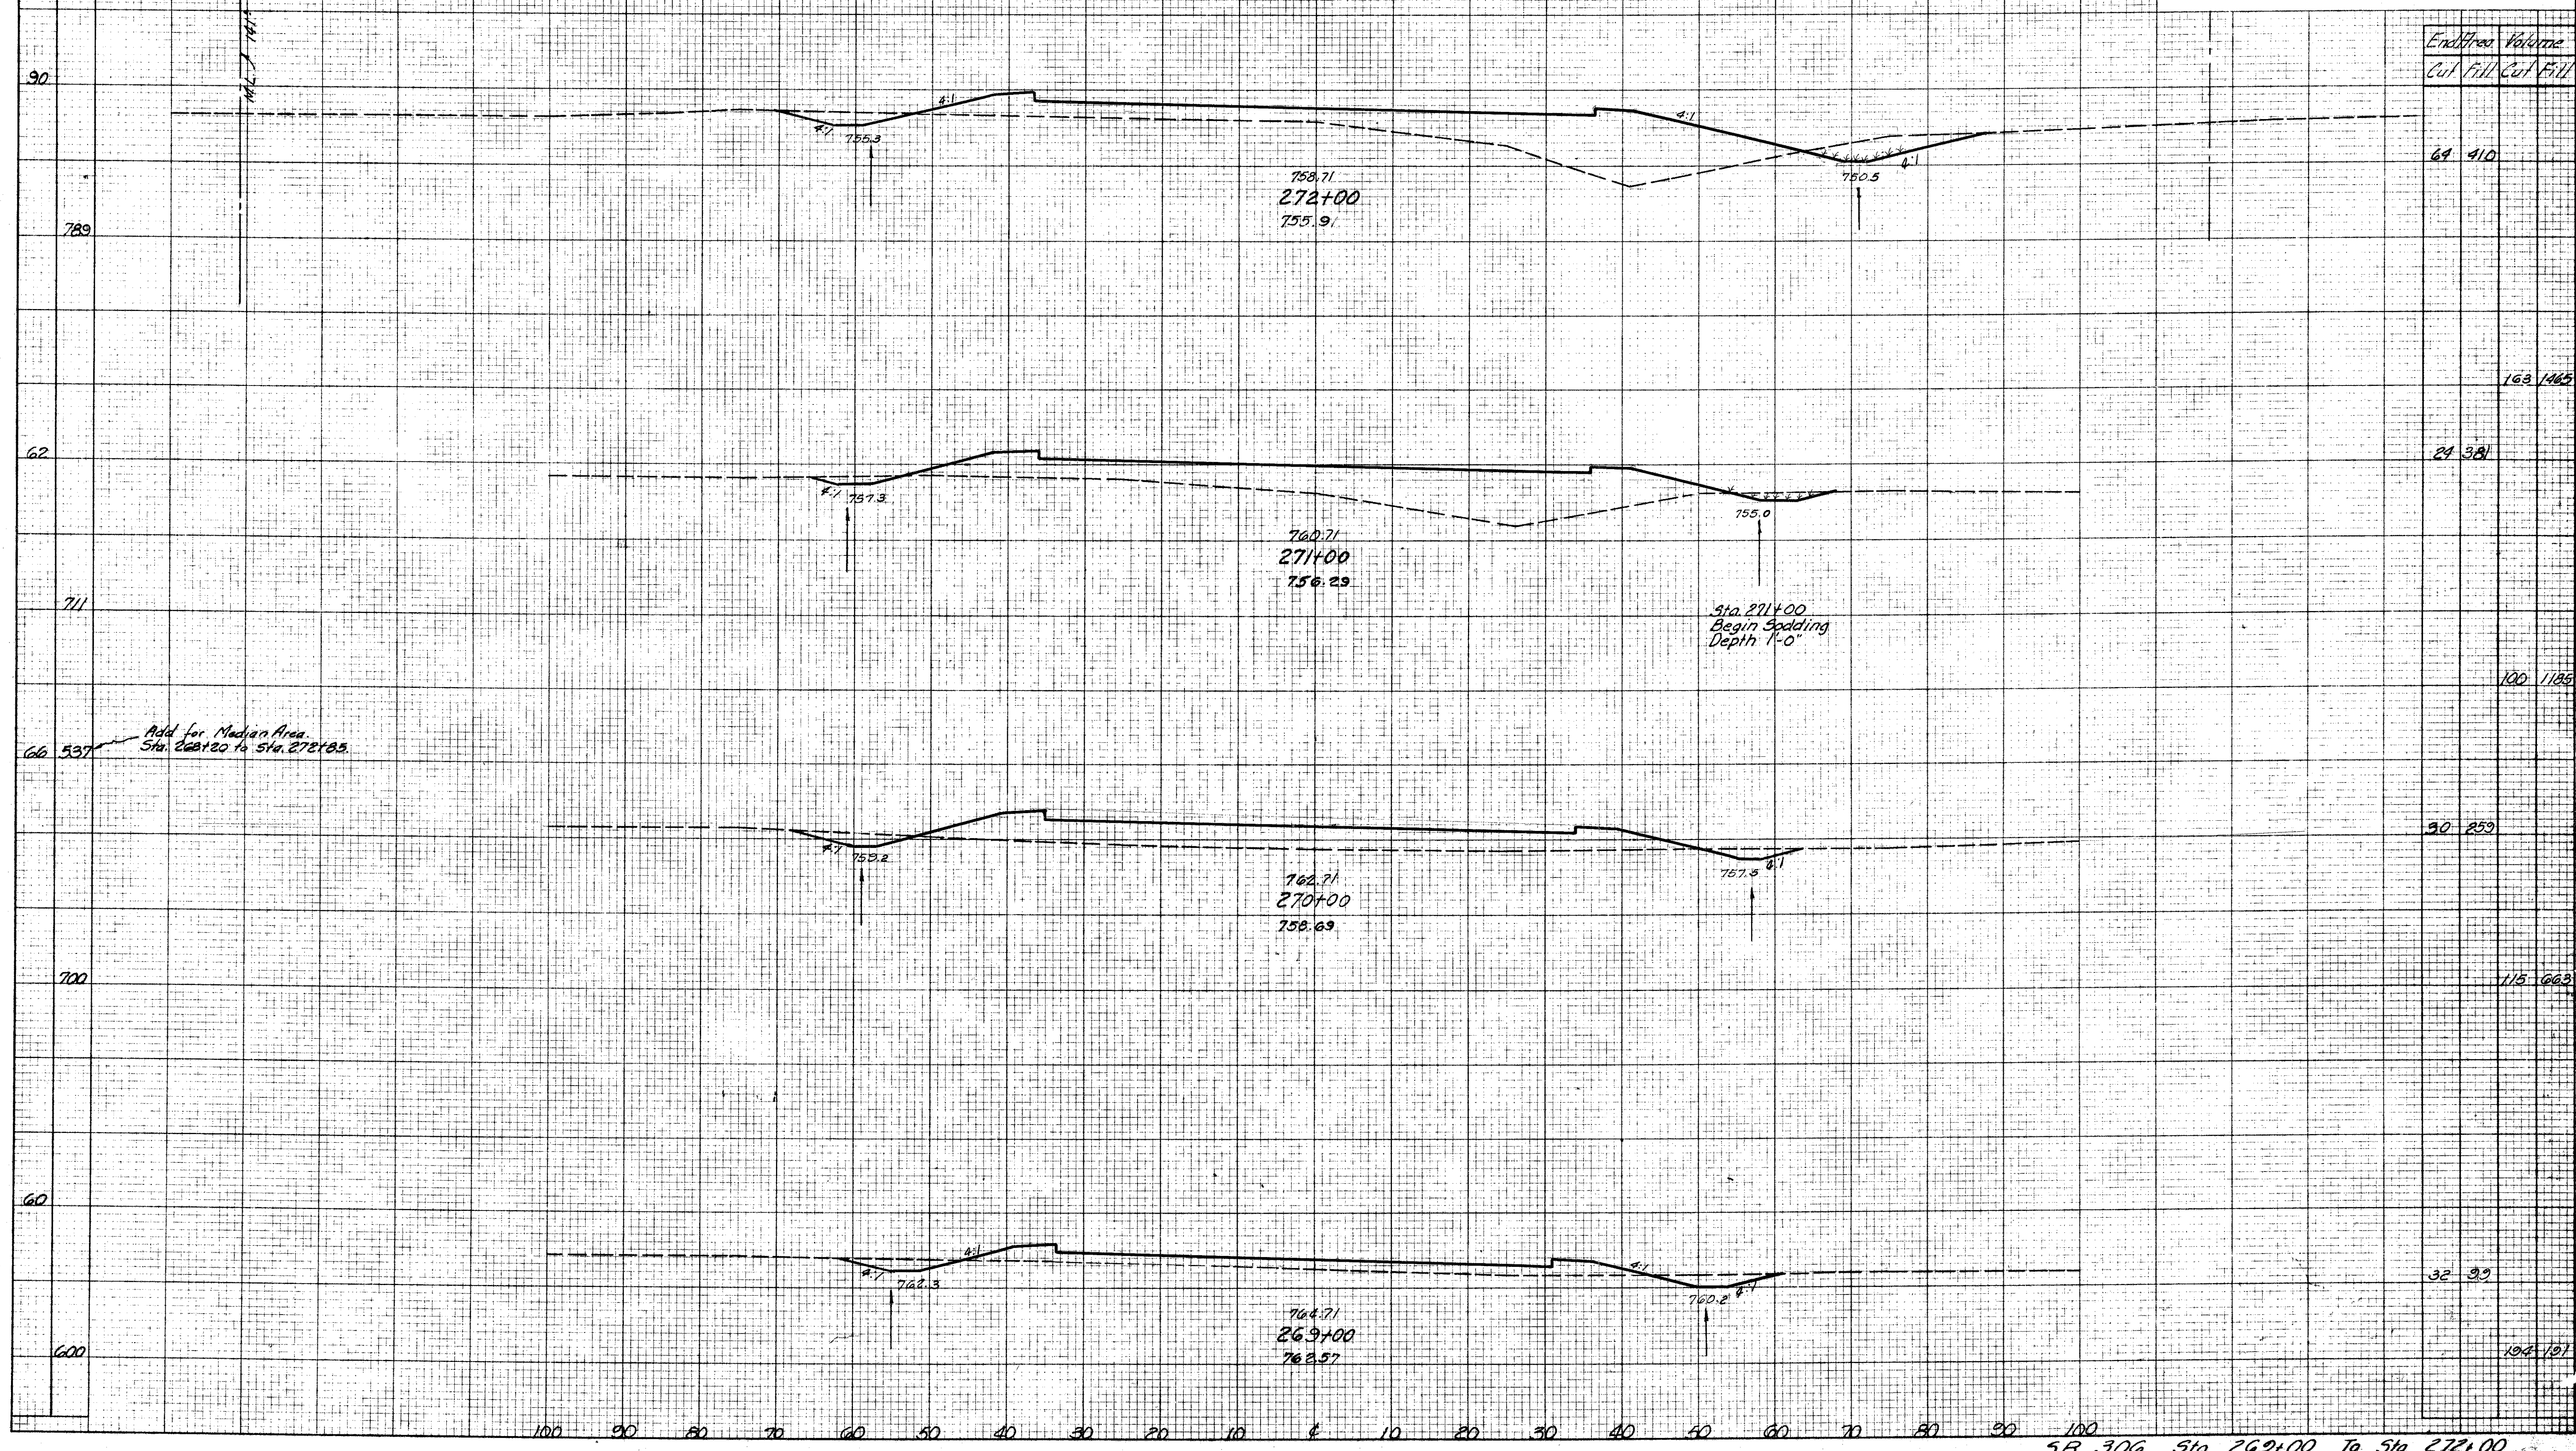

End Area	Volume
Cut	Fill

64 410

163 1465

24 381

100 1185

30 259

115 663

32 39

194 101

100 90 80 70 60 50 40 30 20 10 0 10 20 30 40 50 60 70 80 90 100
S.R. 306 Sta. 269+00 To Sta. 272+00