


Seeding  
End  
Width Sp. 1/2

This sheet supersedes  
Sheet No. 220  
Added 3-29-60 R.F.C.

FED. RD. DIVISION	STATE	PROJECT	220-S 333
2	OHIO	S-46 (7) I-1103 (20)	

LAKE COUNTY  
LAK-1-4.02

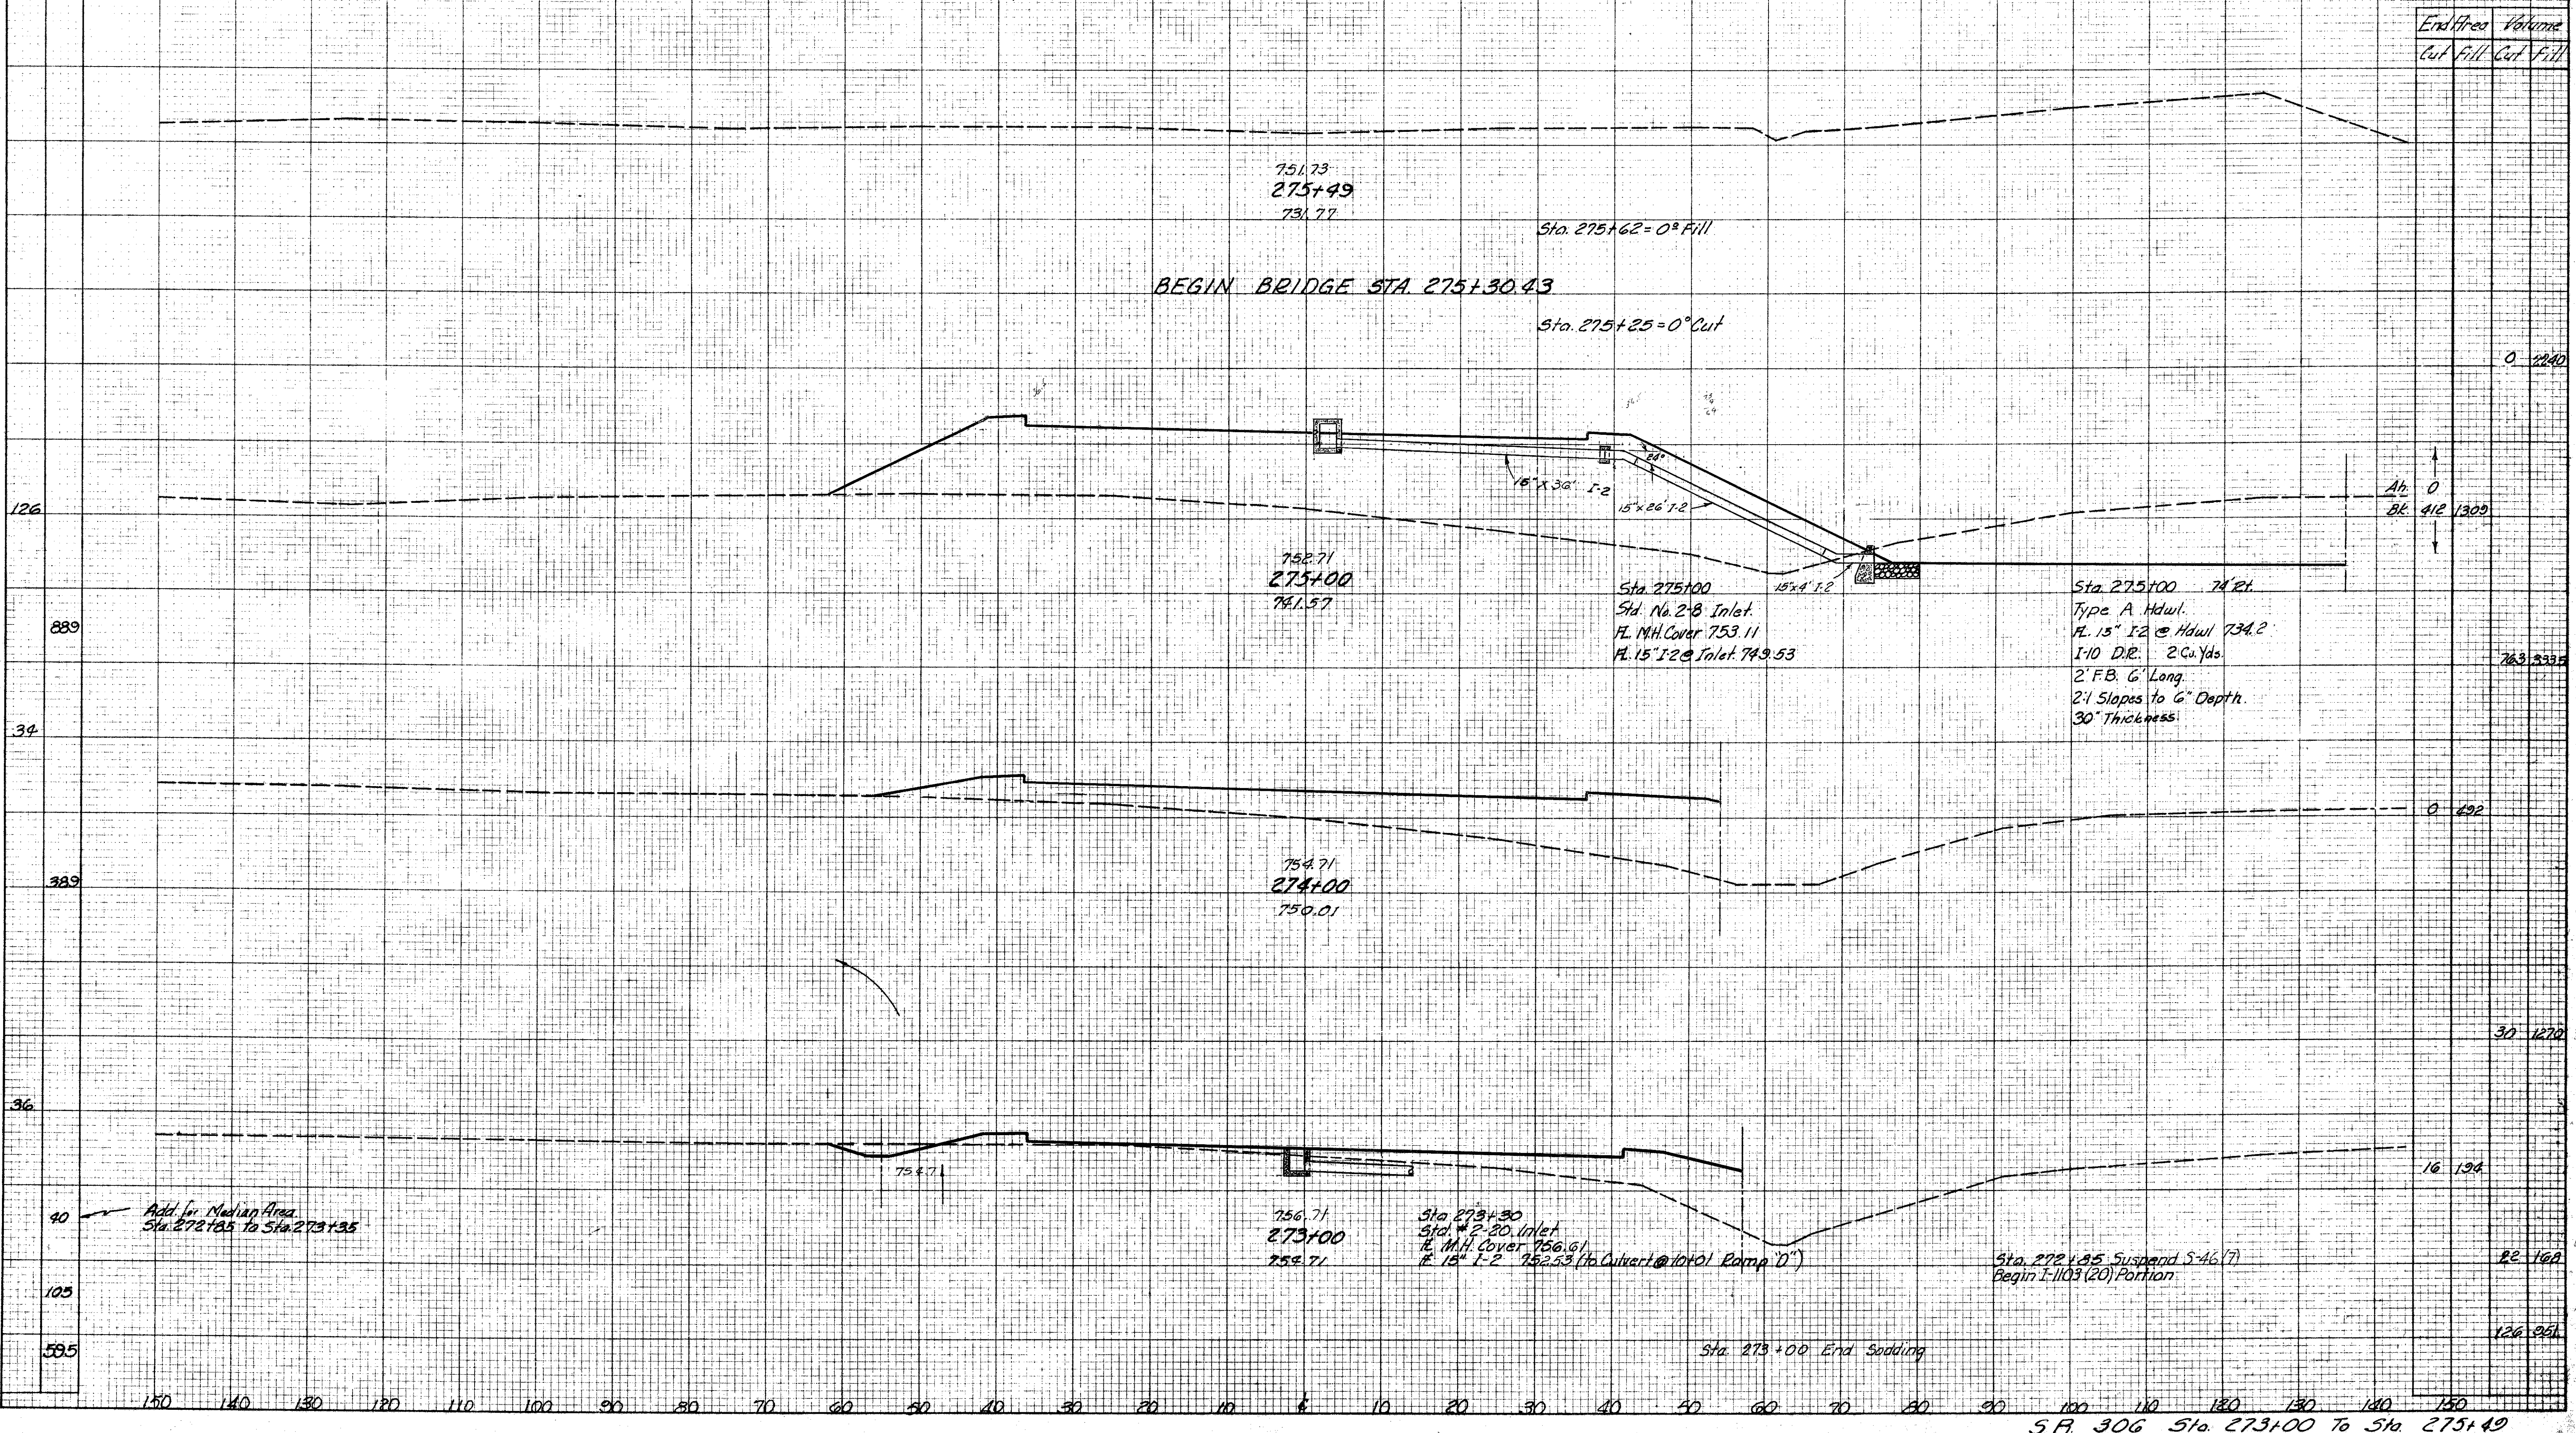

End Area	Volume	
	Cut	Fill
0	2240	
126		1309
889		263,333
34		492
389		30,1270
36		16,194
40		22,168
105		126,951
595		

Alt. 0  
Bk. 412

263,333

0 492

30 1270

16 194

22 168

126 951

S.P. 306 Sta. 273+00 To Sta. 275+49