

Seeding
Erod. Mat.
W/Grass


This sheet supersedes
Sheet No. 222
Added 3-24-60 R.E.C.

FED. RD. DIVISION	STATE	PROJECT
2	OHIO	S-46 (7) I-1103 (20)

222-3
333

LAKE COUNTY
LAK-1-4.02

End Area	Volume
Cut	Fill

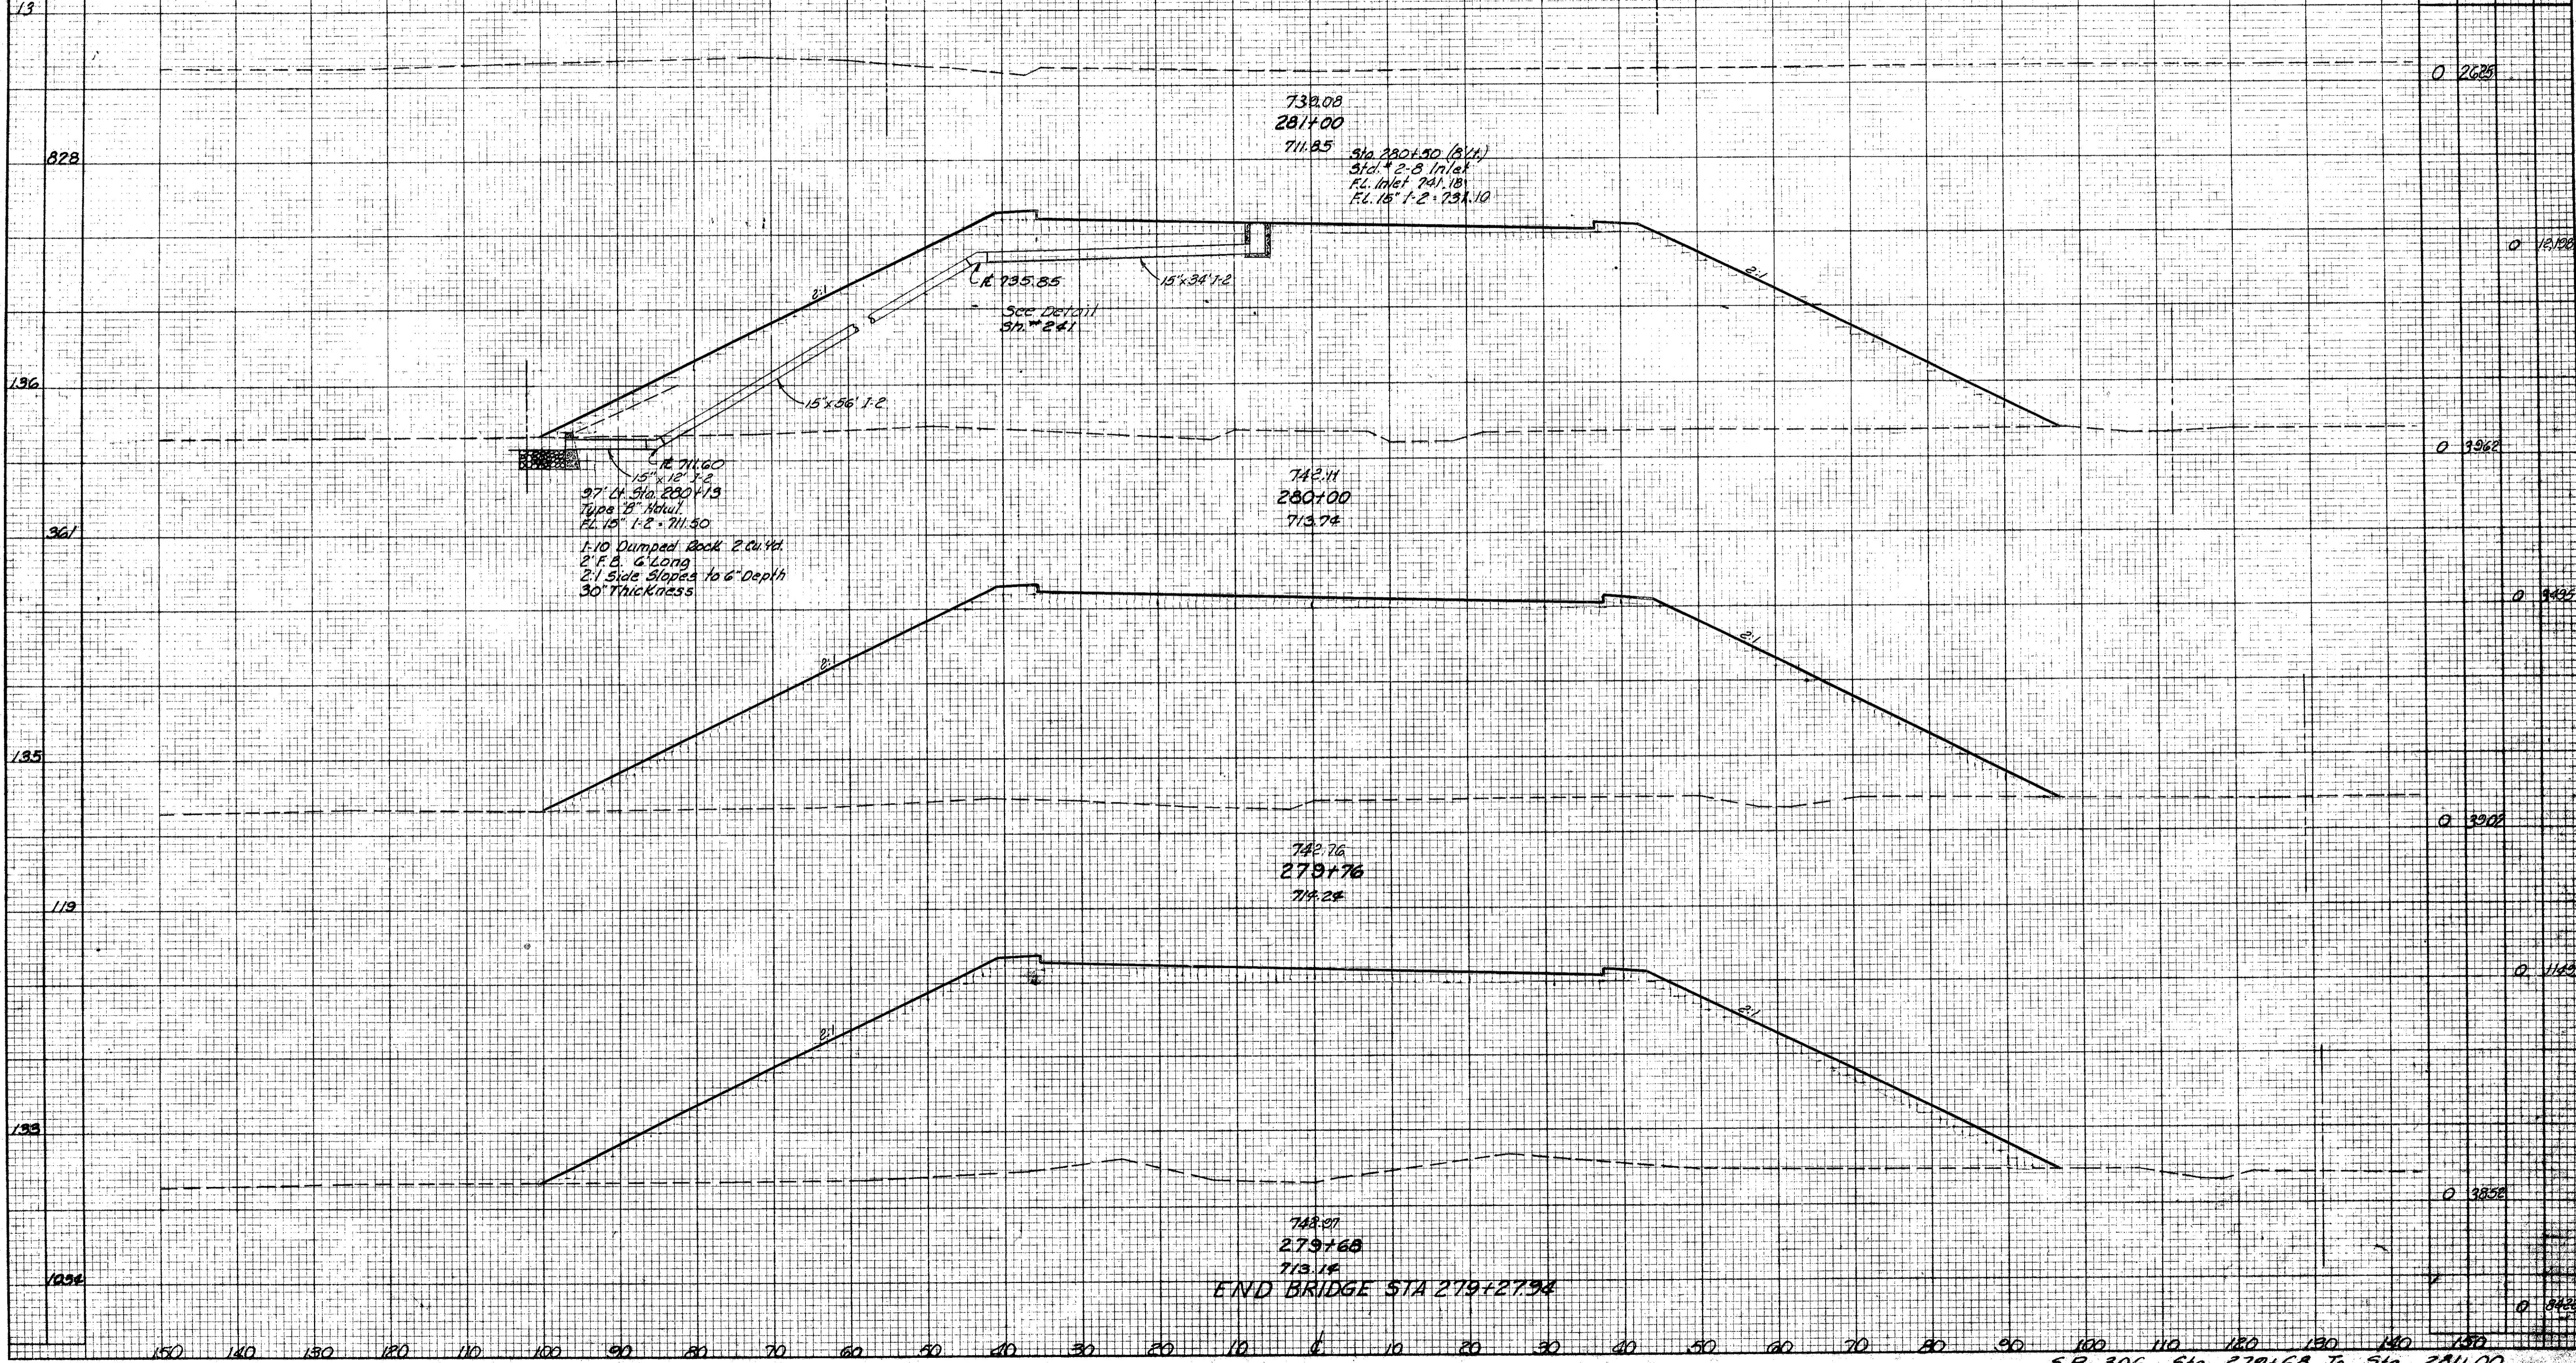

0	2625
0	15126
0	3962
0	9495
0	3902
0	1142
0	3858
0	8122

150 140 130 120 110 100 90 80 70 60 50 40 30 20 10 0 10 20 30 40 50 60 70 80 90 100 110 120 130 140 150
S.P. 306 Sta. 279+68 To Sta. 281+00