Seeding	
End Width	Sq. Yd.
50	
175	
30	Add for Median Area Sta. 287+37.85 to Sta. 281+71.85

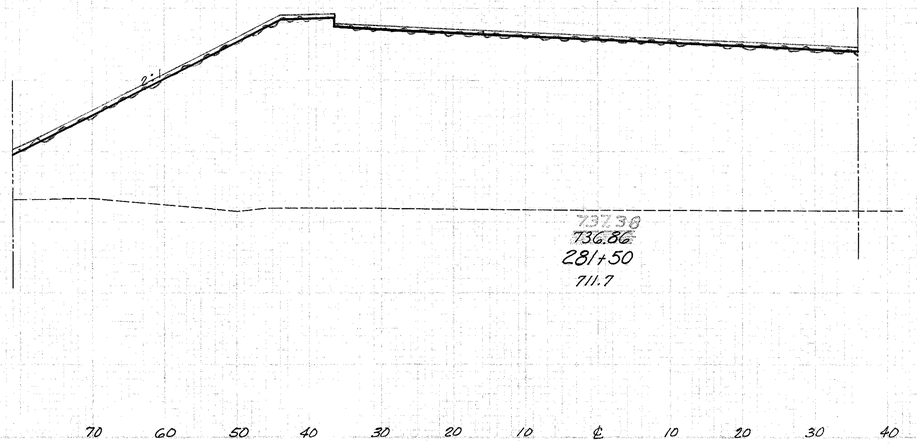

FED. AID PROJECTS	STATE	PROJECT	
2	OHIO	S-46(7) I-1103(20)	

223
333

LAKE COUNTY
LAK-I-4.02

End Area		Volume	
Cut	Fill	Cut	Fill
		21	2290
		0	2651
		0	4813

Sta. 281+71.85 End I-1103(20) Portion
Resume S-46(7)

Rev. 3-24-60 R.E.C.

S.F. 306 Sta. 281+50