


LAKE COUNTY  
LAK-1-4.02

Seeding
End Elevation
Width of Rd.
95
1161
114
1037
452
133
1078
161
330
256

Add for Median Area  
Sta. 281+71.85 to Sta. 285+53

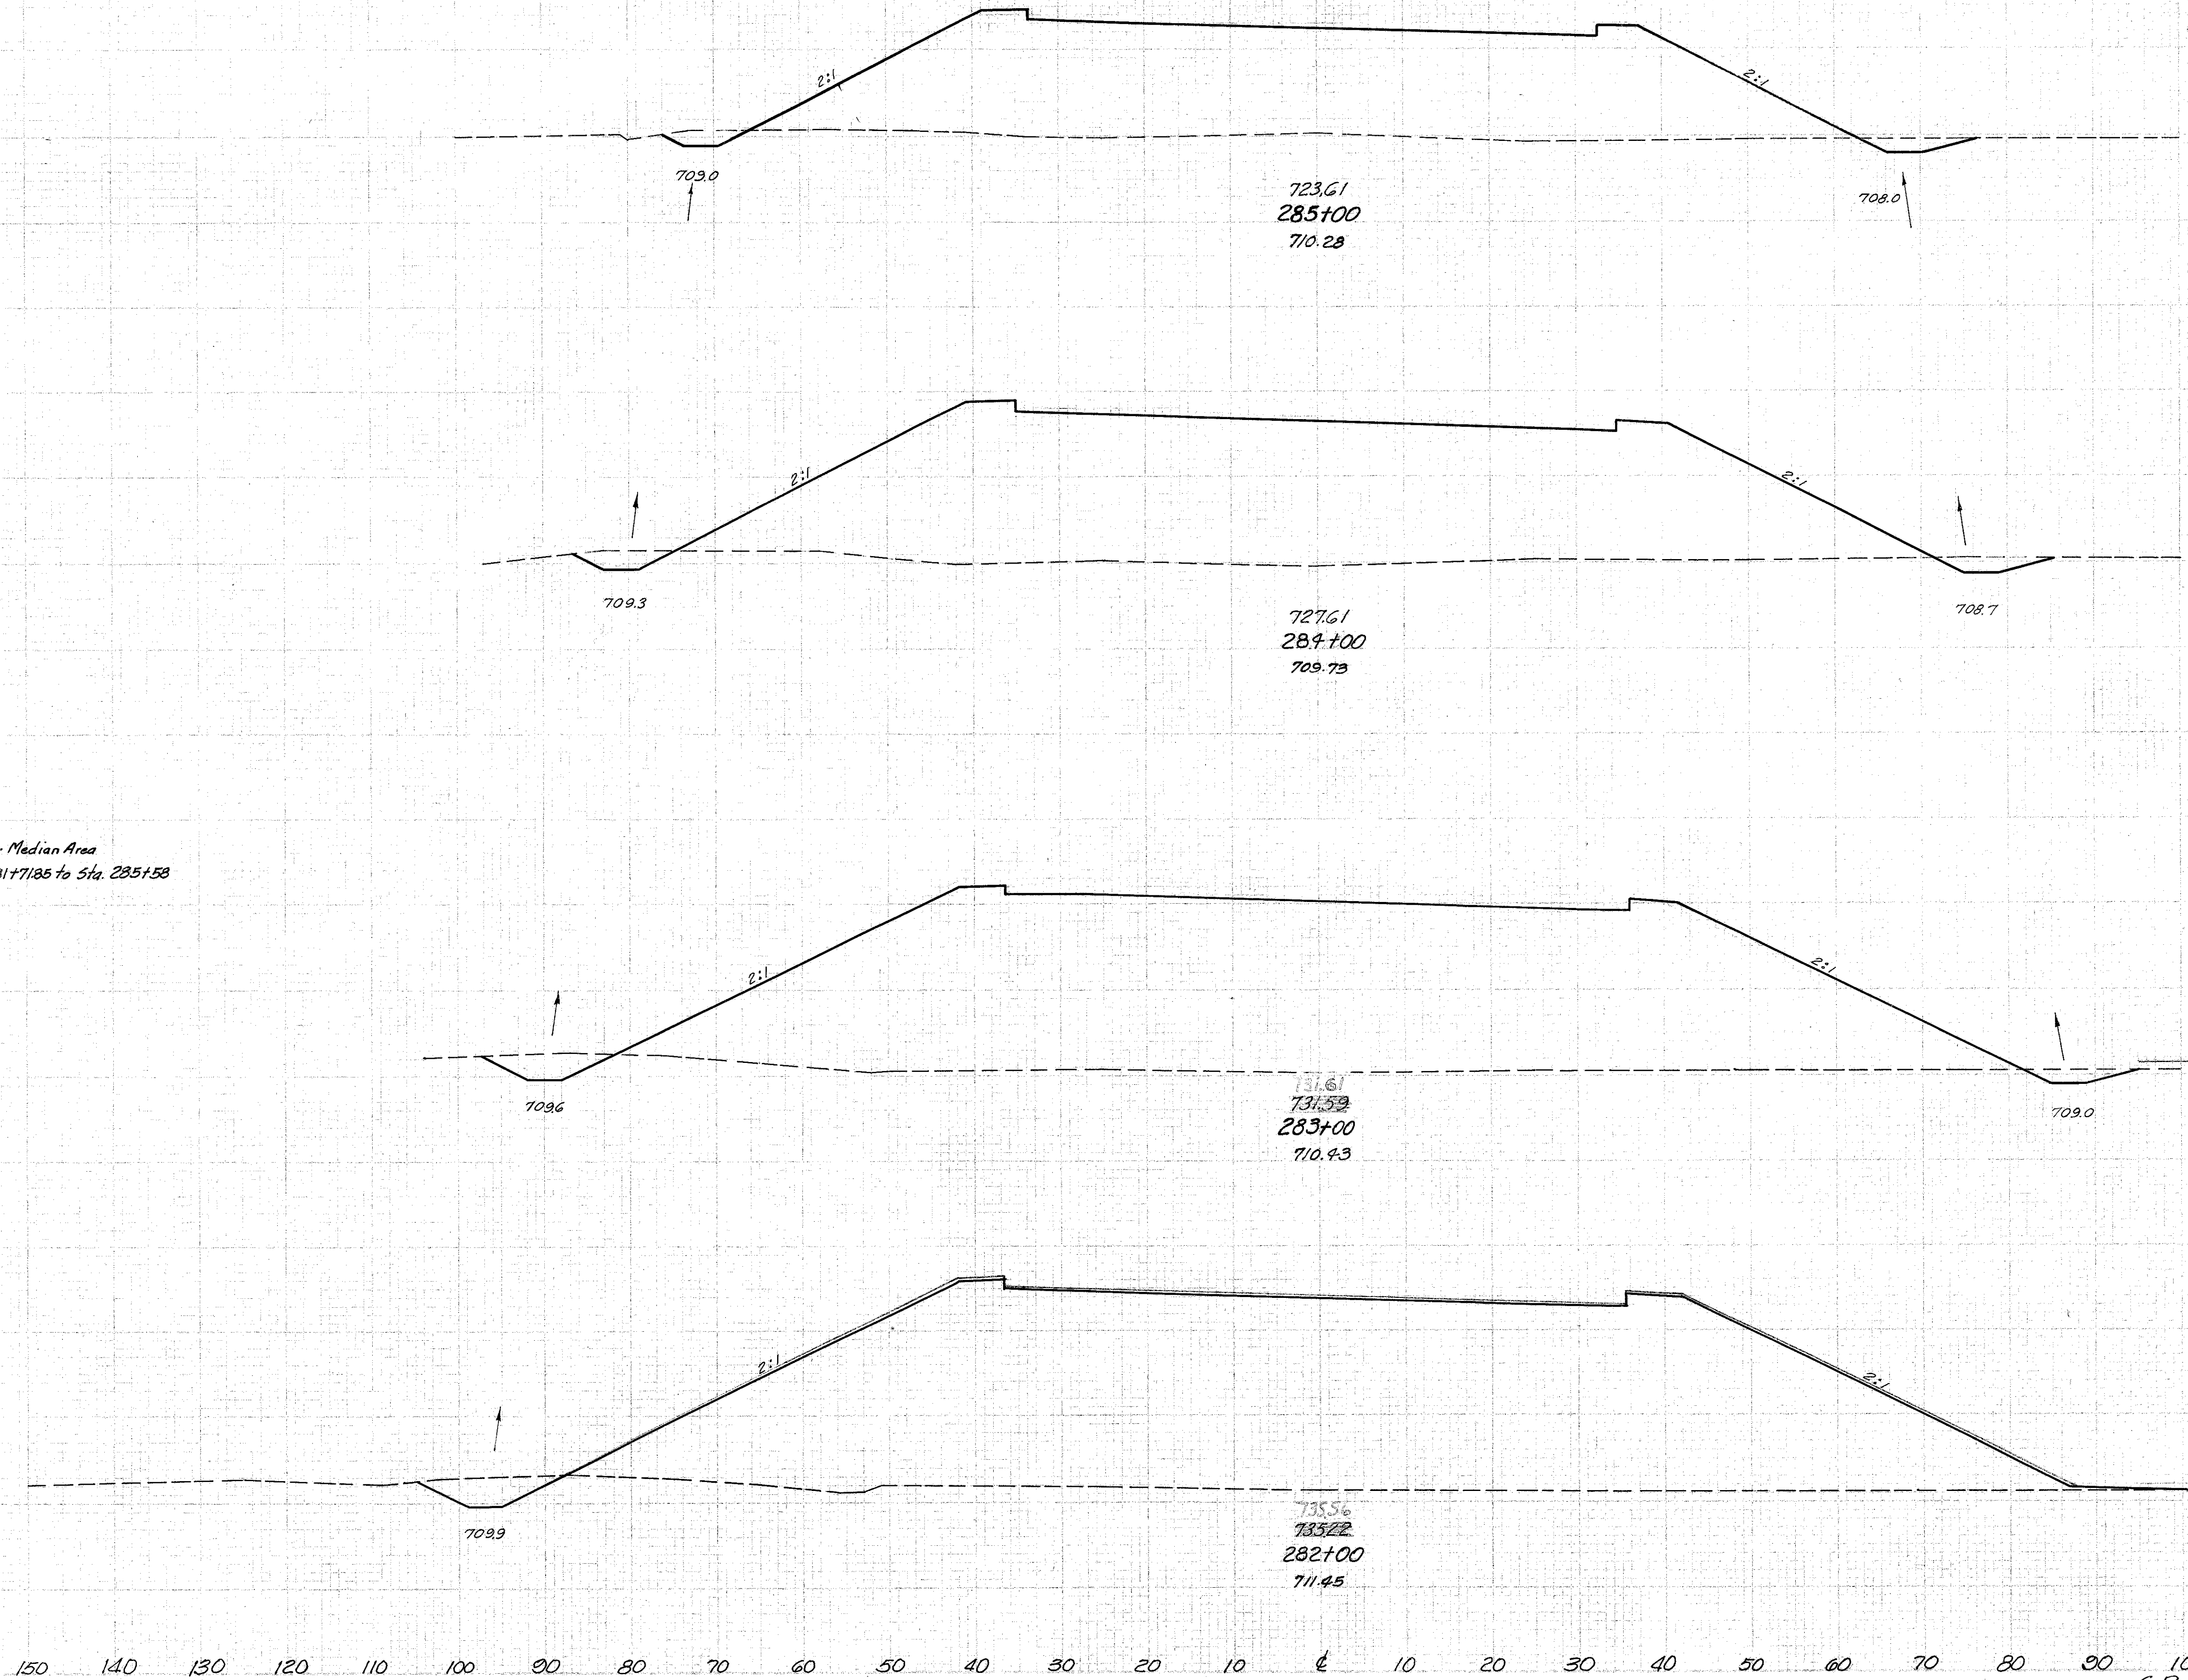

End Area		Volume	
Cut	Fill	Cut	Fill
35	1328		
		131	6022
36	1923		
		152	8162
46	2484		
		180	10175
51	2978		
		26	2997
		57	3105