
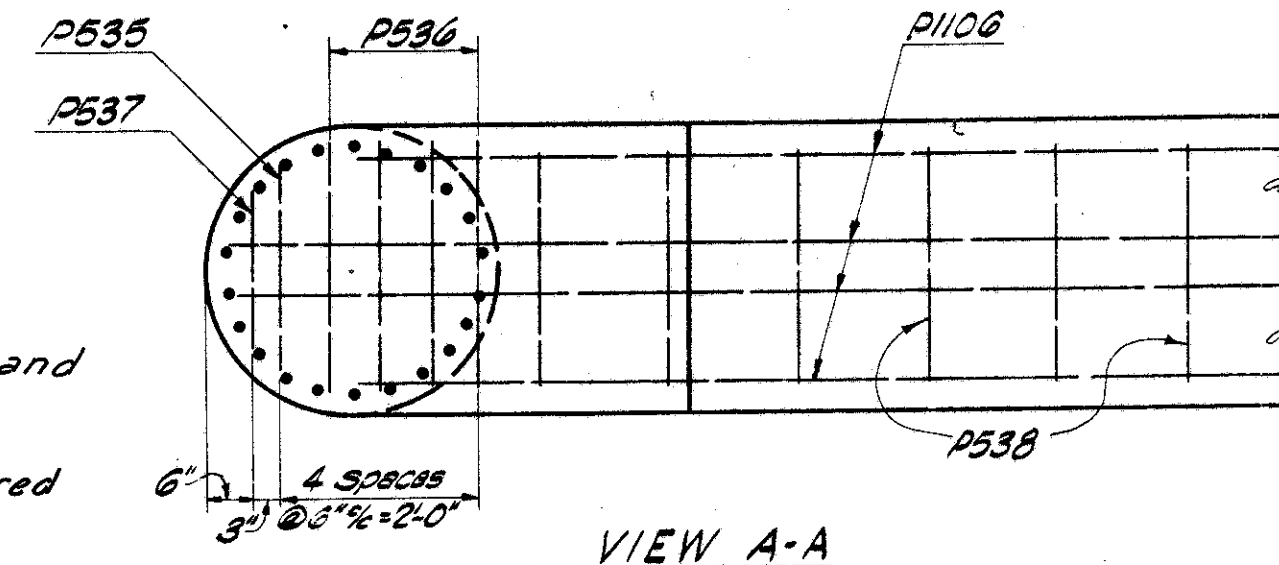


NOTE:
For Pier Layout see General Plan and Elevation.


NOTE:
The downward leg of P1106 to be placed in the periphery of the vertical column bars.

NOTE:
For revised Pier height provide 440-#7x3-7" long and 110-#11x4-9" long Reinforcing Bars to lap with vertical column bars. The length of Spiral bars to be increased to required change in height.


For mark numbers of column bars see Elevation.

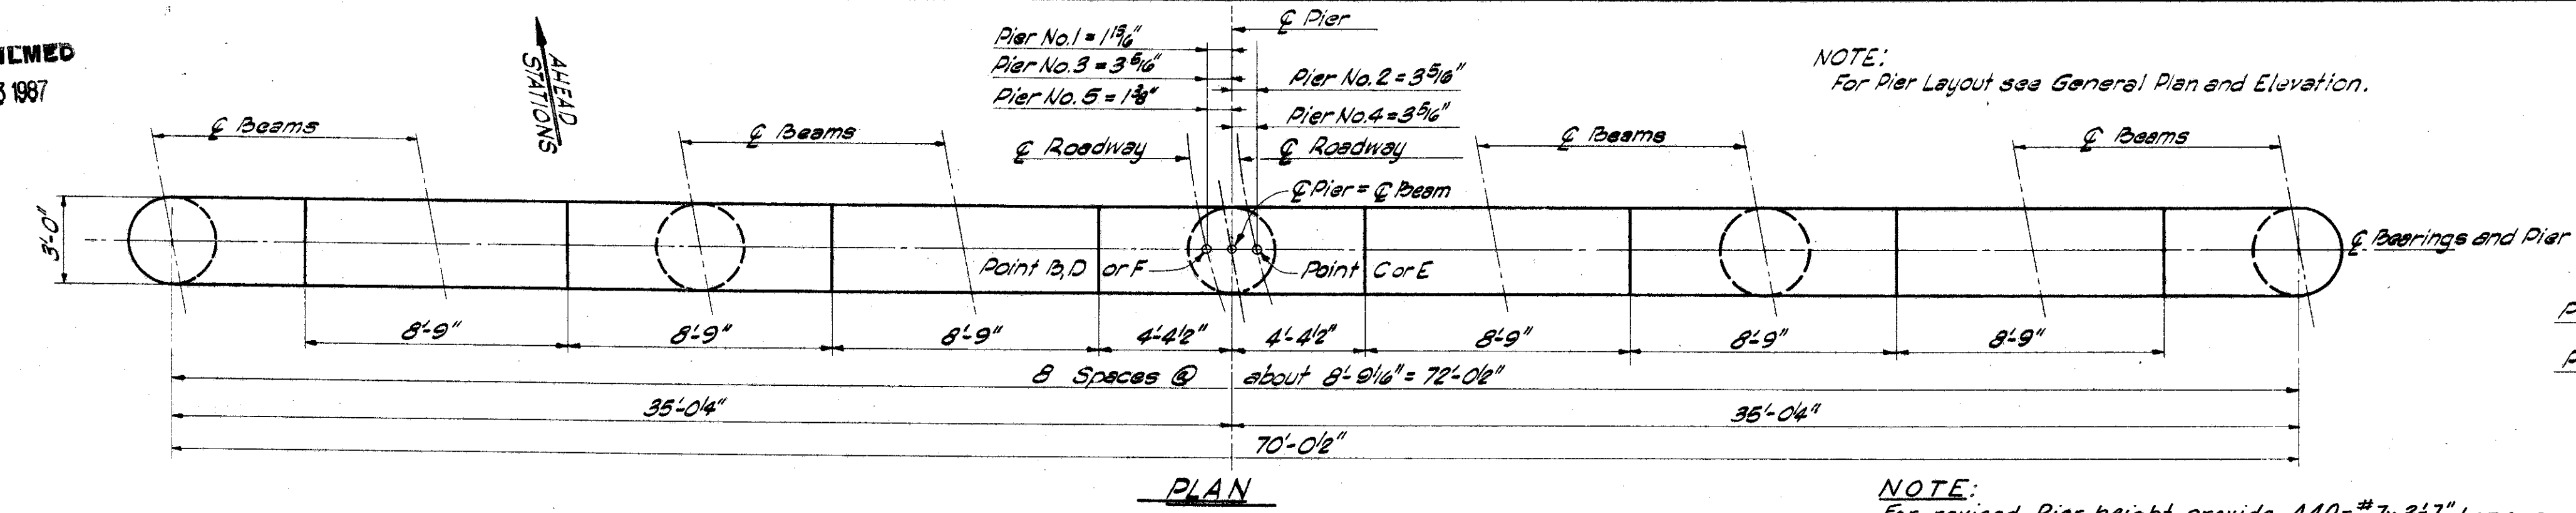


SECTION C-C

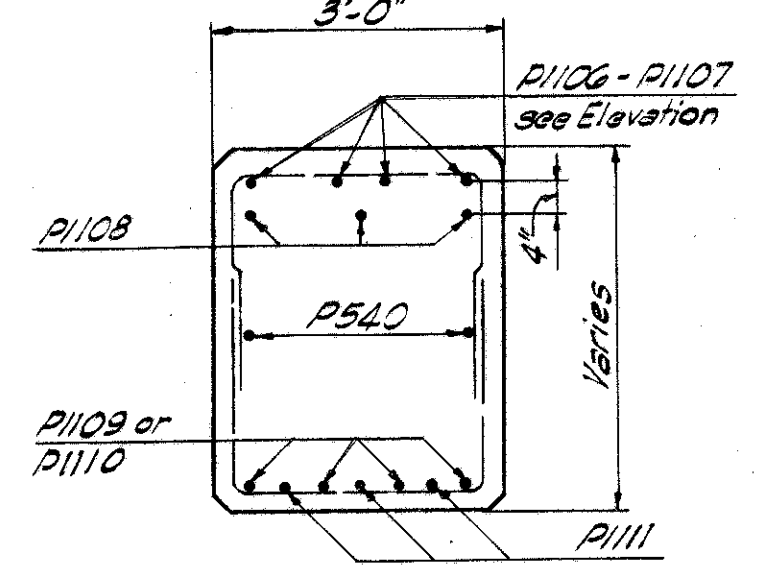

SECTION D-D

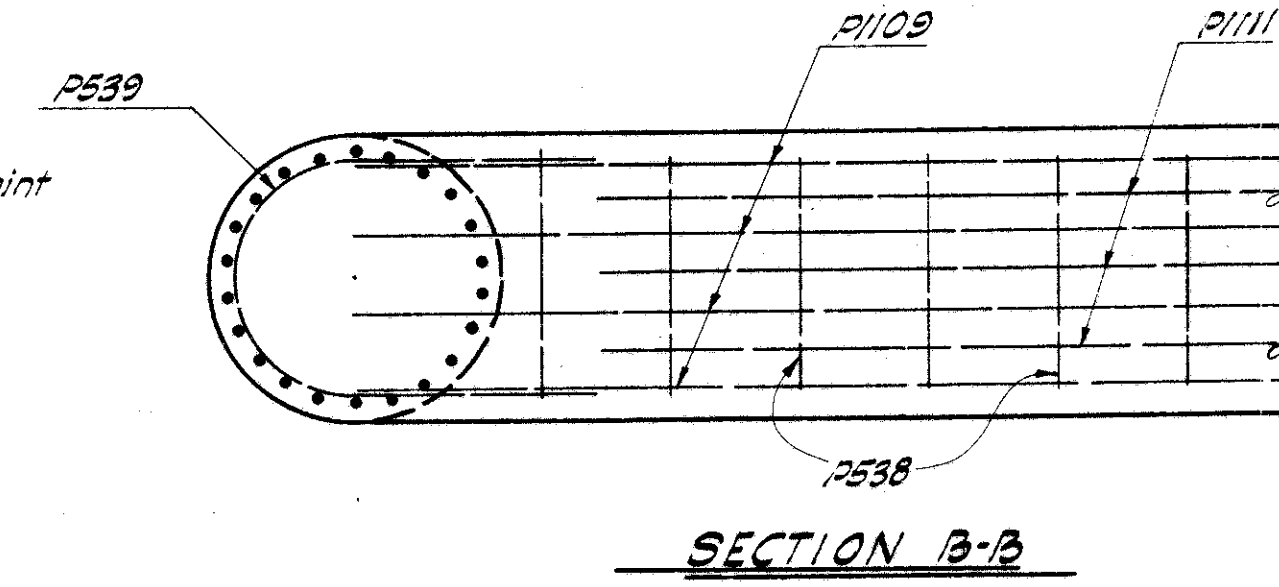


SECTION B-B

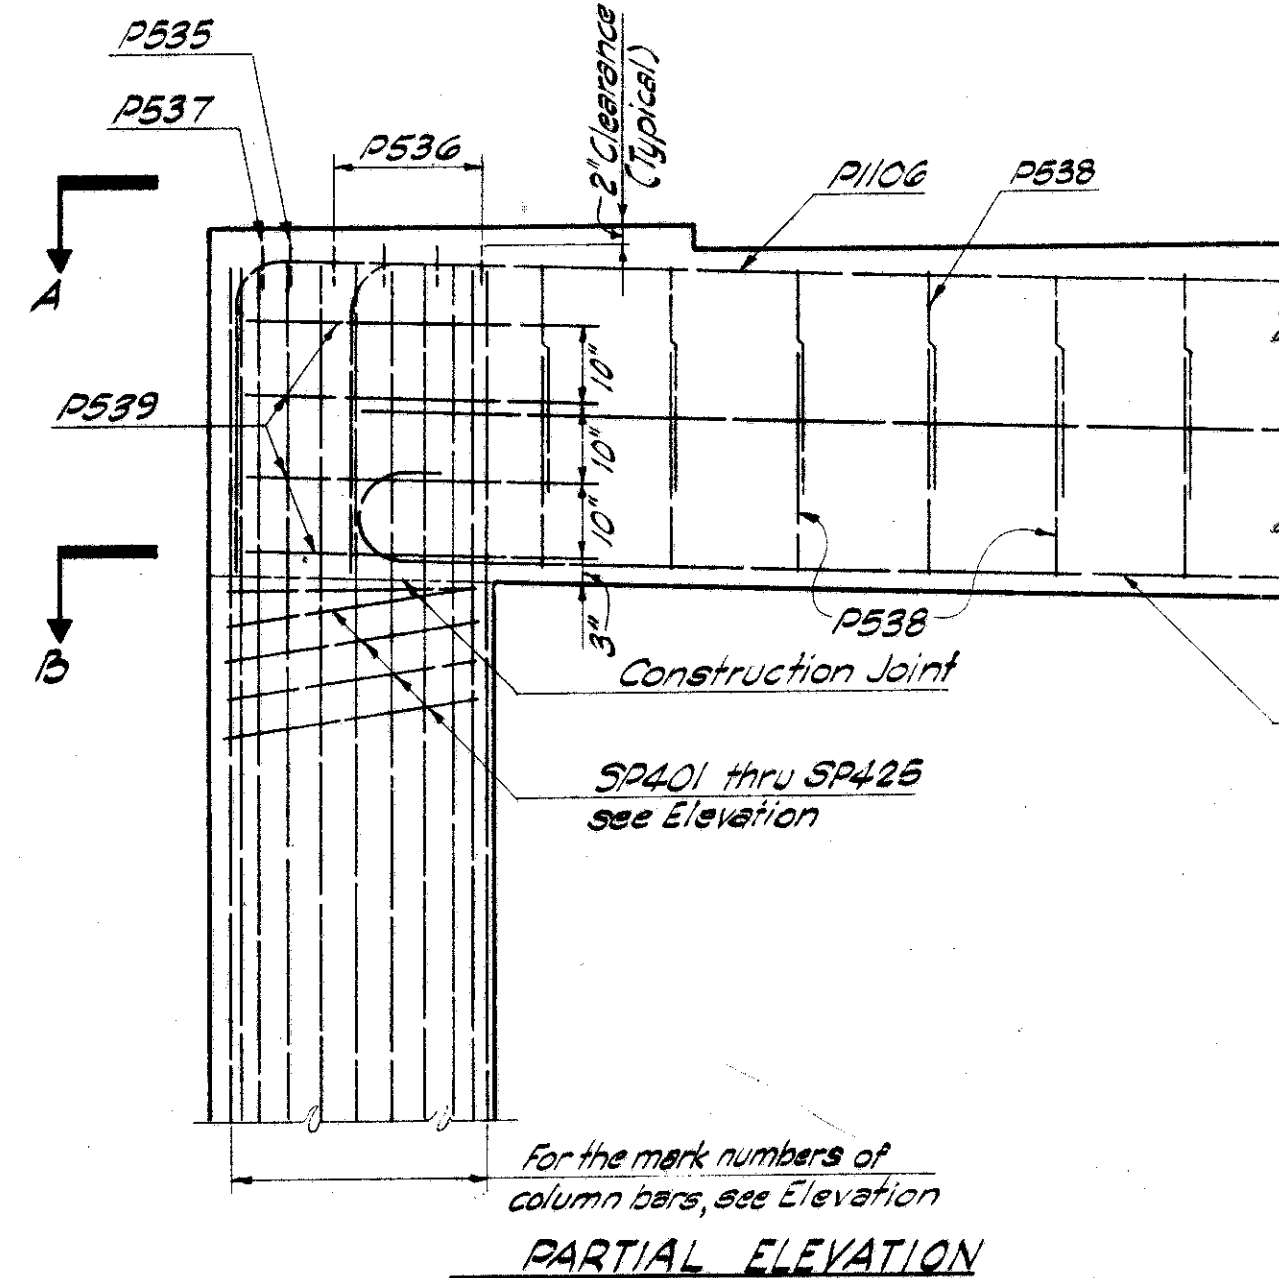




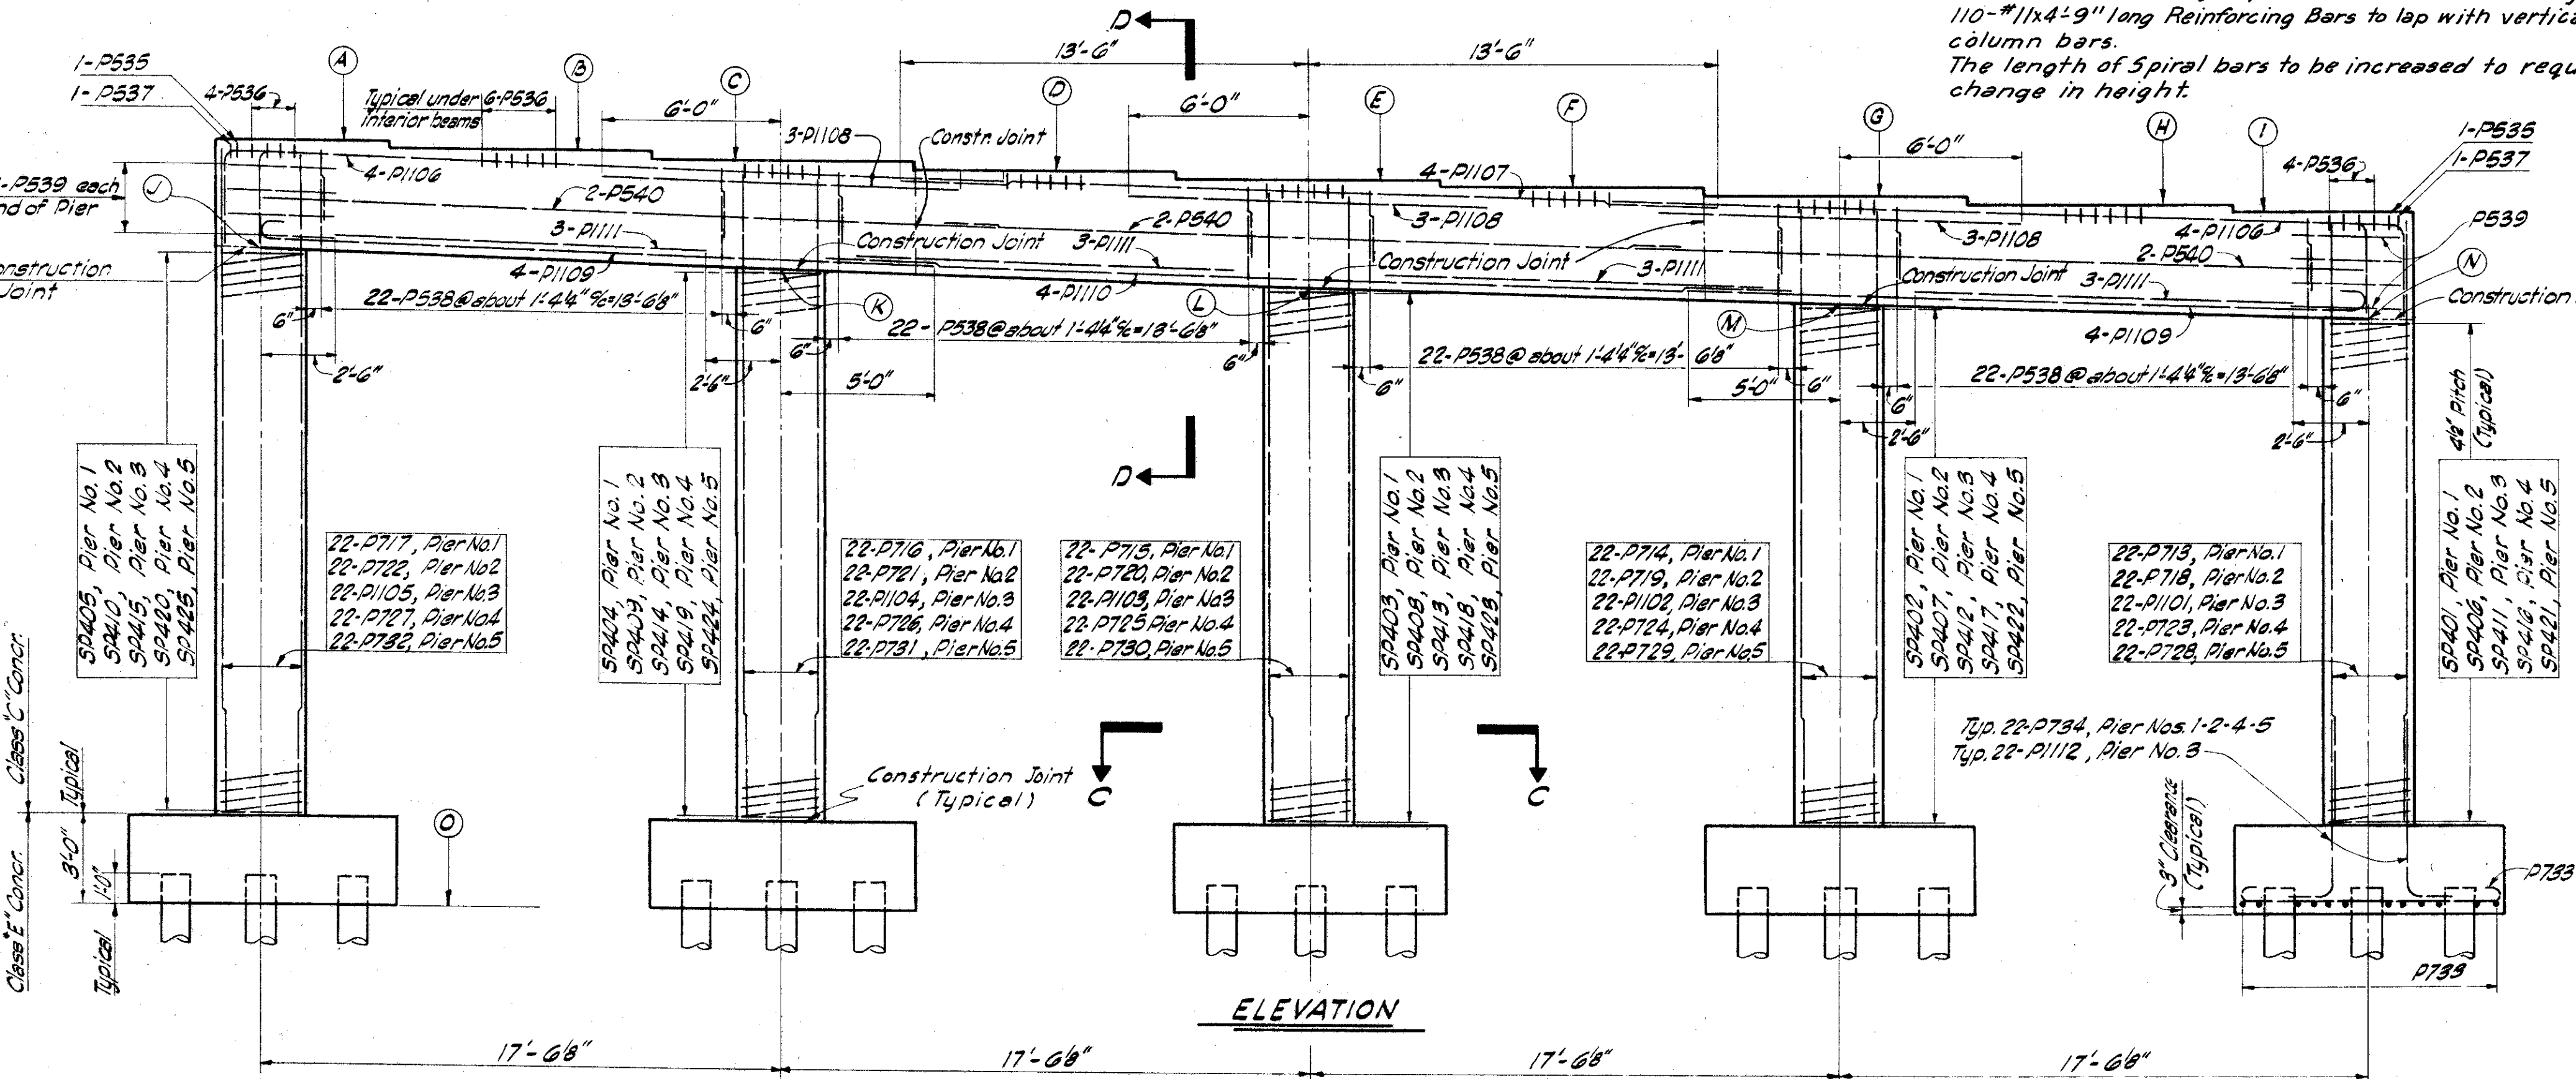

ELEVATION

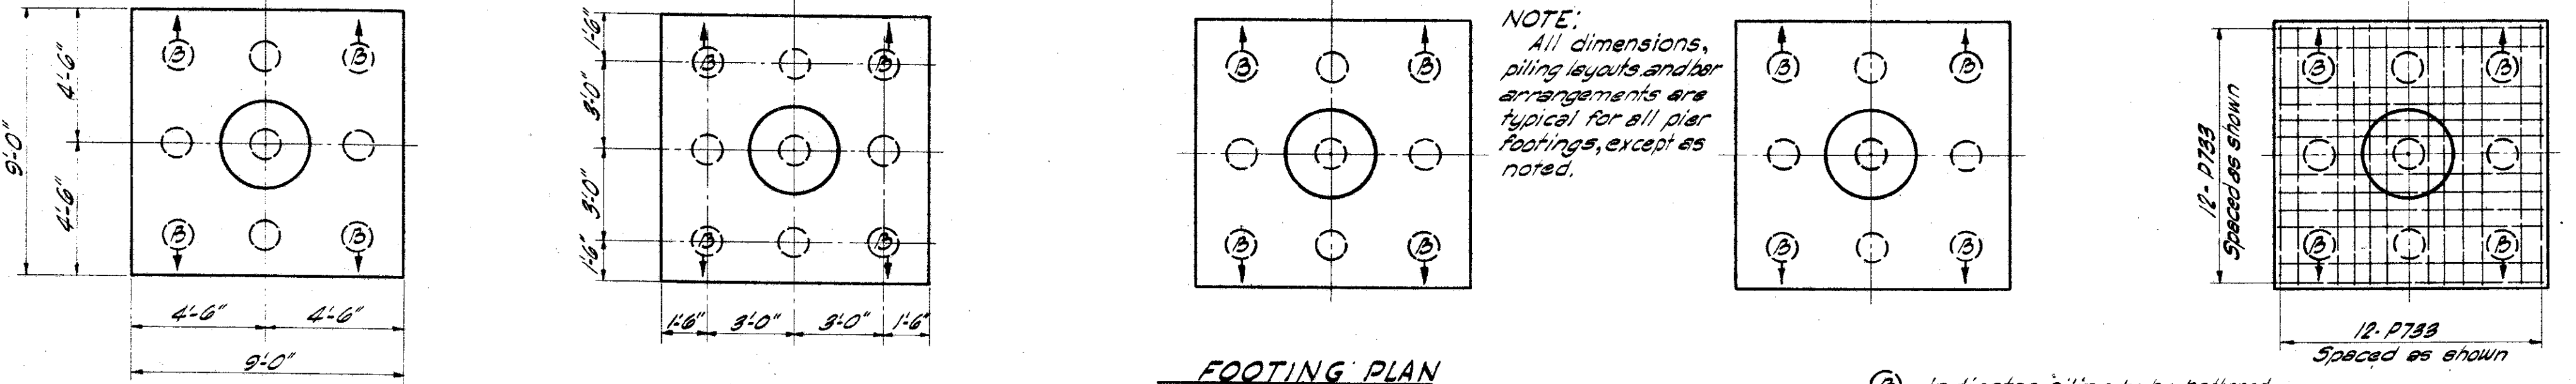


FOOTING PLAN

NOTE:
All dimensions, piling layouts and bar arrangements are typical for all pier footings, except as noted.

(B) Indicates piling to be battered @ 2:12 in direction indicated. (For Pier No. 3 only)

LOCATION	A	B	C	D	E	F	G	H	I	J	K	L	M	N	O
Pier No. 1	746.68	746.43	746.18	745.93	745.68	745.43	745.18	744.93	744.68	742.80	742.30	741.80	741.30	740.80	719.50
Pier No. 2	745.23	744.98	744.73	744.48	744.22	743.97	743.72	743.47	743.21	741.35	740.84	740.34	739.83	739.33	718.50
Pier No. 3	743.80	743.55	743.29	743.04	742.78	742.53	742.27	741.76	741.76	739.92	739.41	738.90	738.39	737.88	715.00
Pier No. 4	742.41	742.15	741.89	741.63	741.36	741.11	740.86	740.60	740.34	738.53	738.01	737.49	736.97	736.45	715.50
Pier No. 5	741.00	740.74	740.48	740.22	739.96	739.70	739.44	739.18	738.92	737.11	736.59	736.07	735.55	735.03	716.00

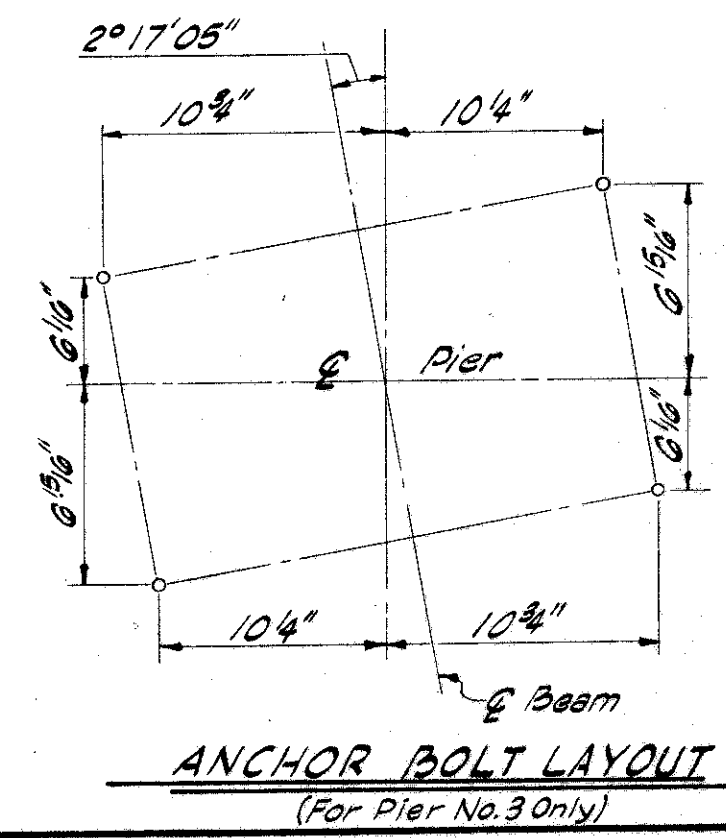

ANCHOR BOLT LAYOUT
(For Pier No. 3 Only)

This sheet supersedes sheet 310. 3-21-60.

MICHAEL BAKER JR. CONSULTING ENGINEERS
ROCHESTER, PENNSYLVANIA

PIERS
BRIDGE NO. LAK-I-0665
UNDER STATE ROUTE 306

LAKE COUNTY				STA 358+74.33	
Designed	Drawn	Traced	Checked	Reviewed-Date	Revised
P.M.J.			Y.G.	W.R.B. 4-28-58	3-14-60