


FED. RD. DIVISION	STATE	PROJECT	
2	OHIO		


269
277

LAK-1-6.97
R/W PLAN
LIMITED ACCESS

8
16

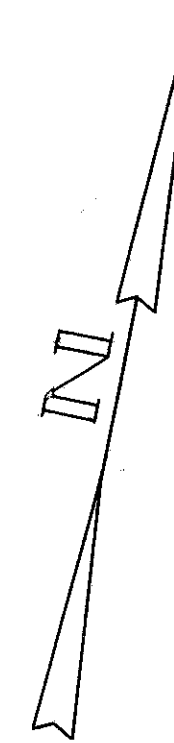

RESIDUE = 303.55 Ac. ±

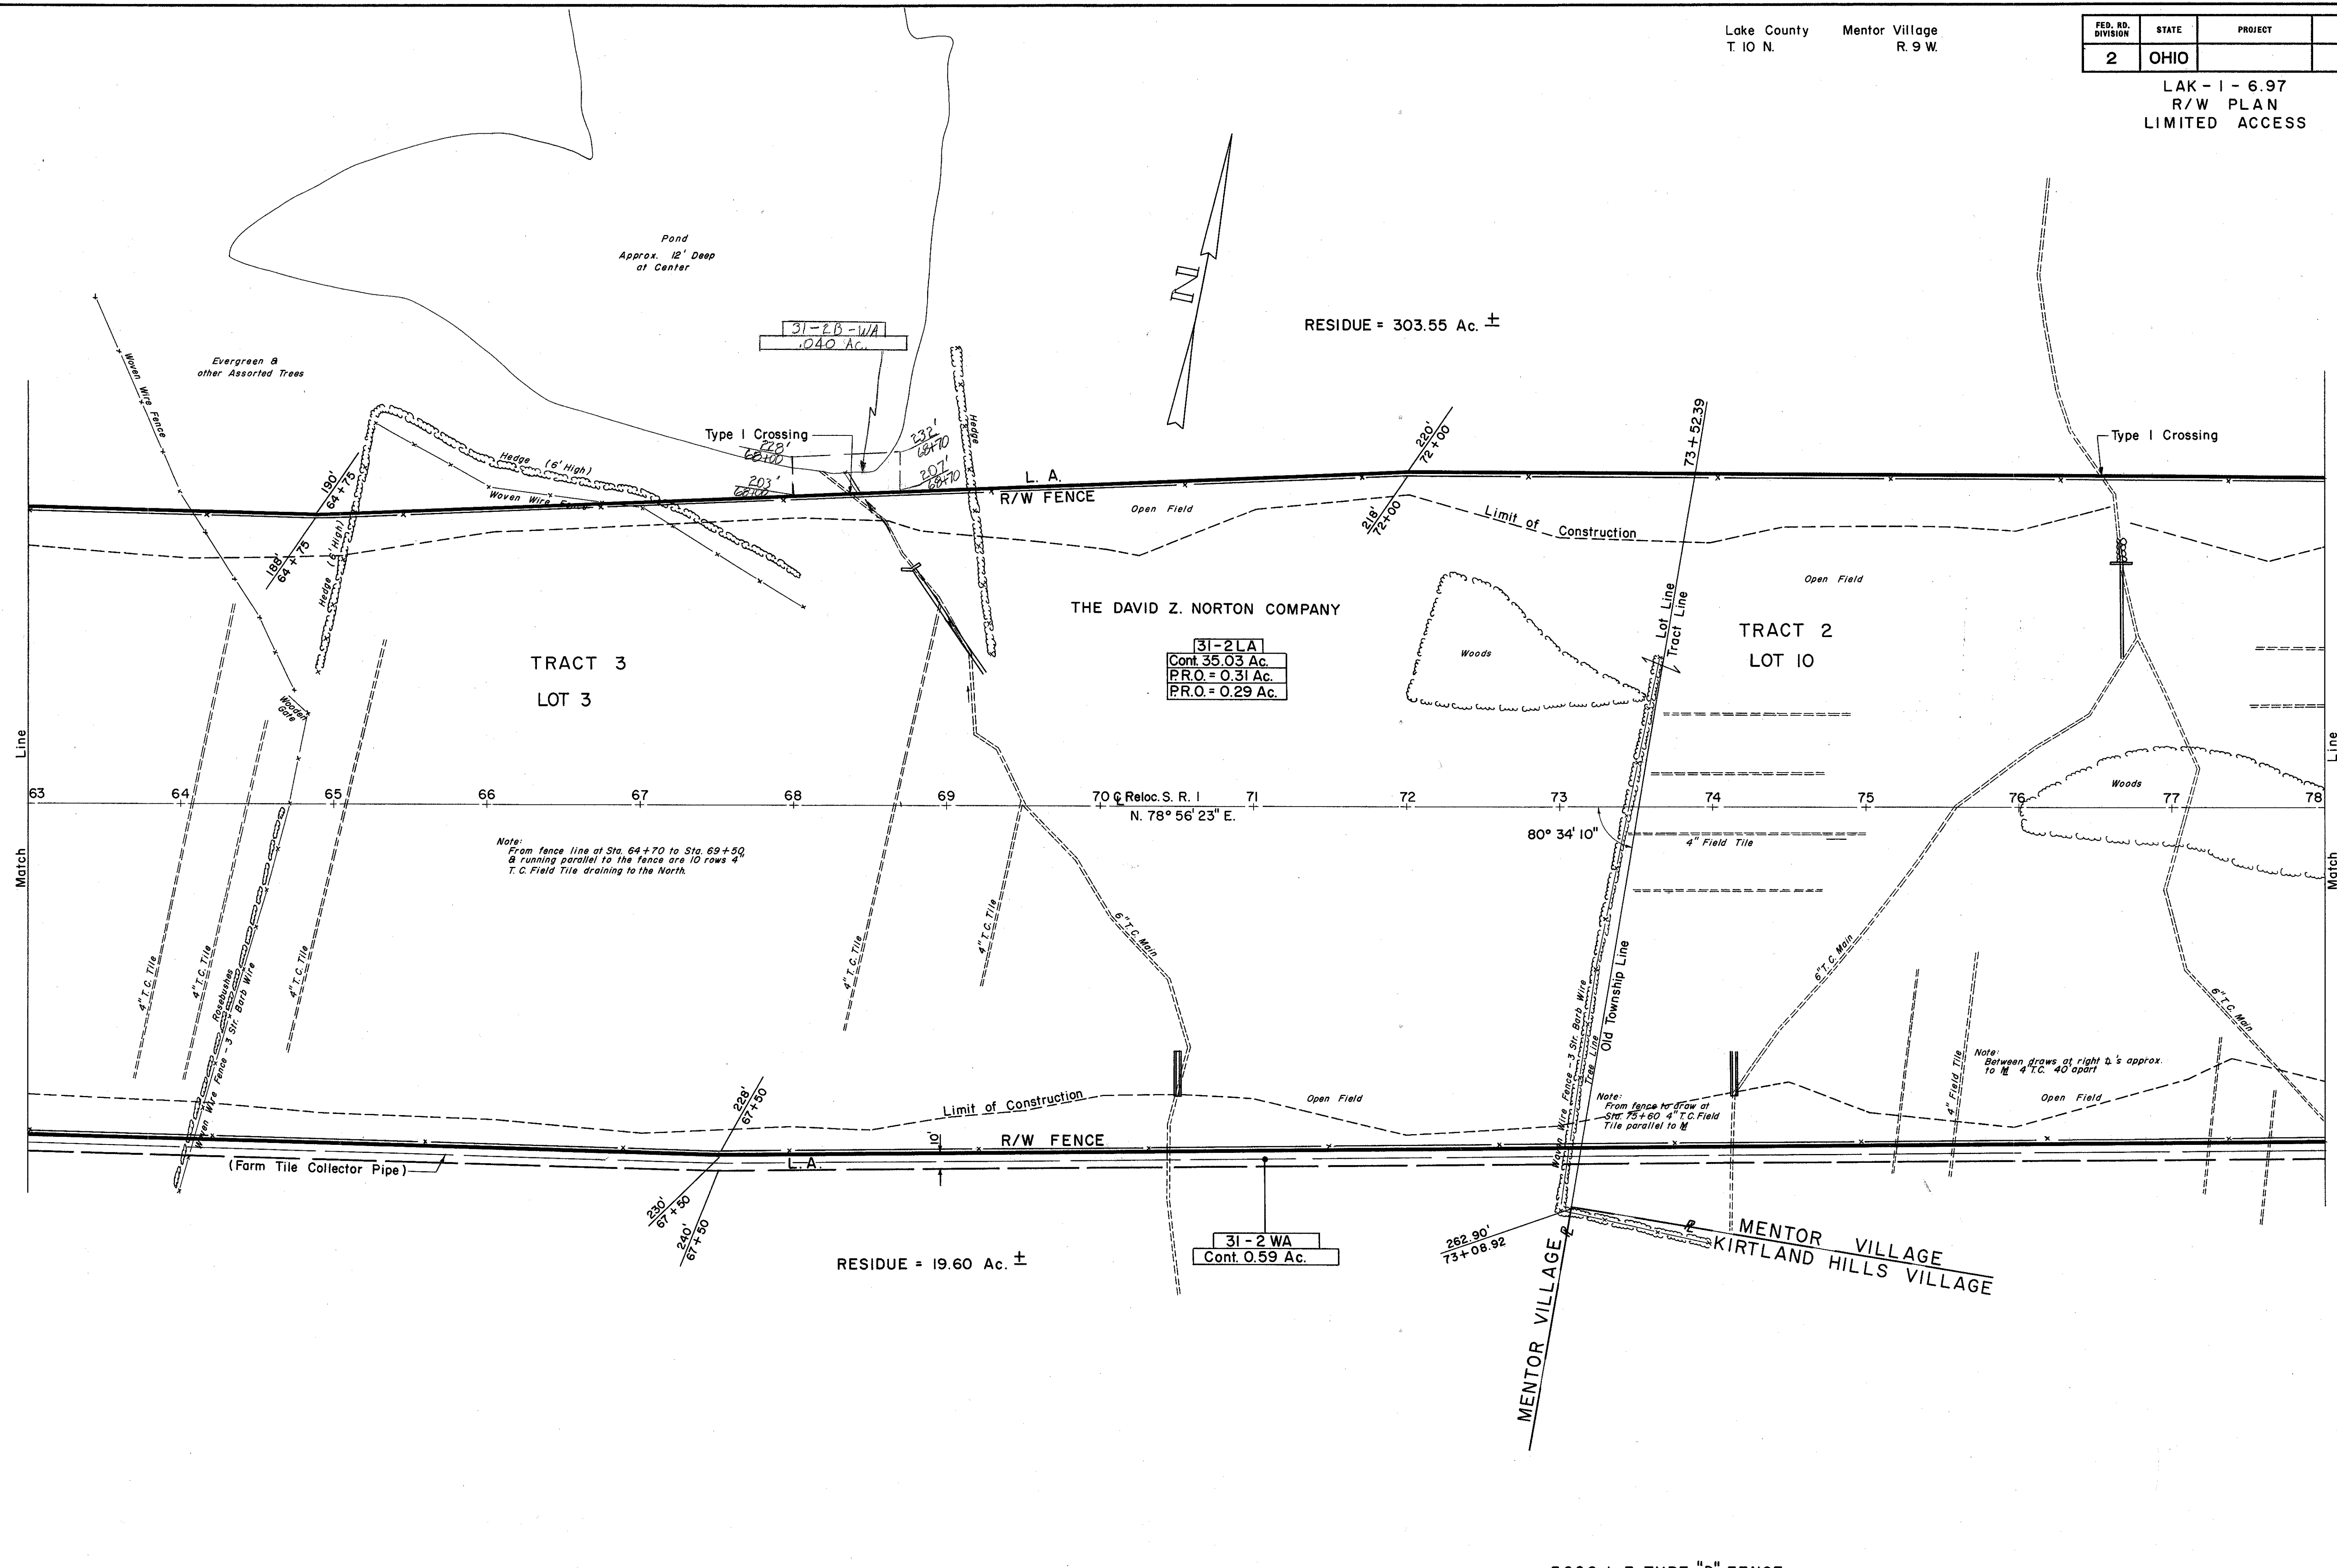

31-2B-1/A
.040 Ac.

31-2LA
Cont. 35.03 Ac.
P.R.O. = 0.31 Ac.
P.R.O. = 0.29 Ac.

31-2WA
Cont. 0.59 Ac.

TRACT 3
LOT 3

TRACT 2
LOT 10

THE DAVID Z. NORTON COMPANY

70 ± Reloc. S. R. 1
N. 78° 56' 23" E.

Note:
From fence line at Sta. 64+70 to Sta. 69+50,
B running parallel to the fence are 10 rows 4"
T.C. Field Tile draining to the North.

Note:
From fence to draw at
Sta. 75+60 4" T.C. Field
Tile parallel to M

Note:
Between draws at right b.s. approx.
to 4" T.C. 40 apart

(Form Tile Collector Pipe)

RESIDUE = 19.60 Ac. ±

MENTOR VILLAGE
KIRTLAND HILLS VILLAGE

3006 L.F. TYPE "D" FENCE