


LAKE COUNTY
LAK-I-4.02
LIMITED ACCESS

R/W
3 of 22

WILLOUGHBY TWP
O.L. 2 TRACT 9
T9N R10W

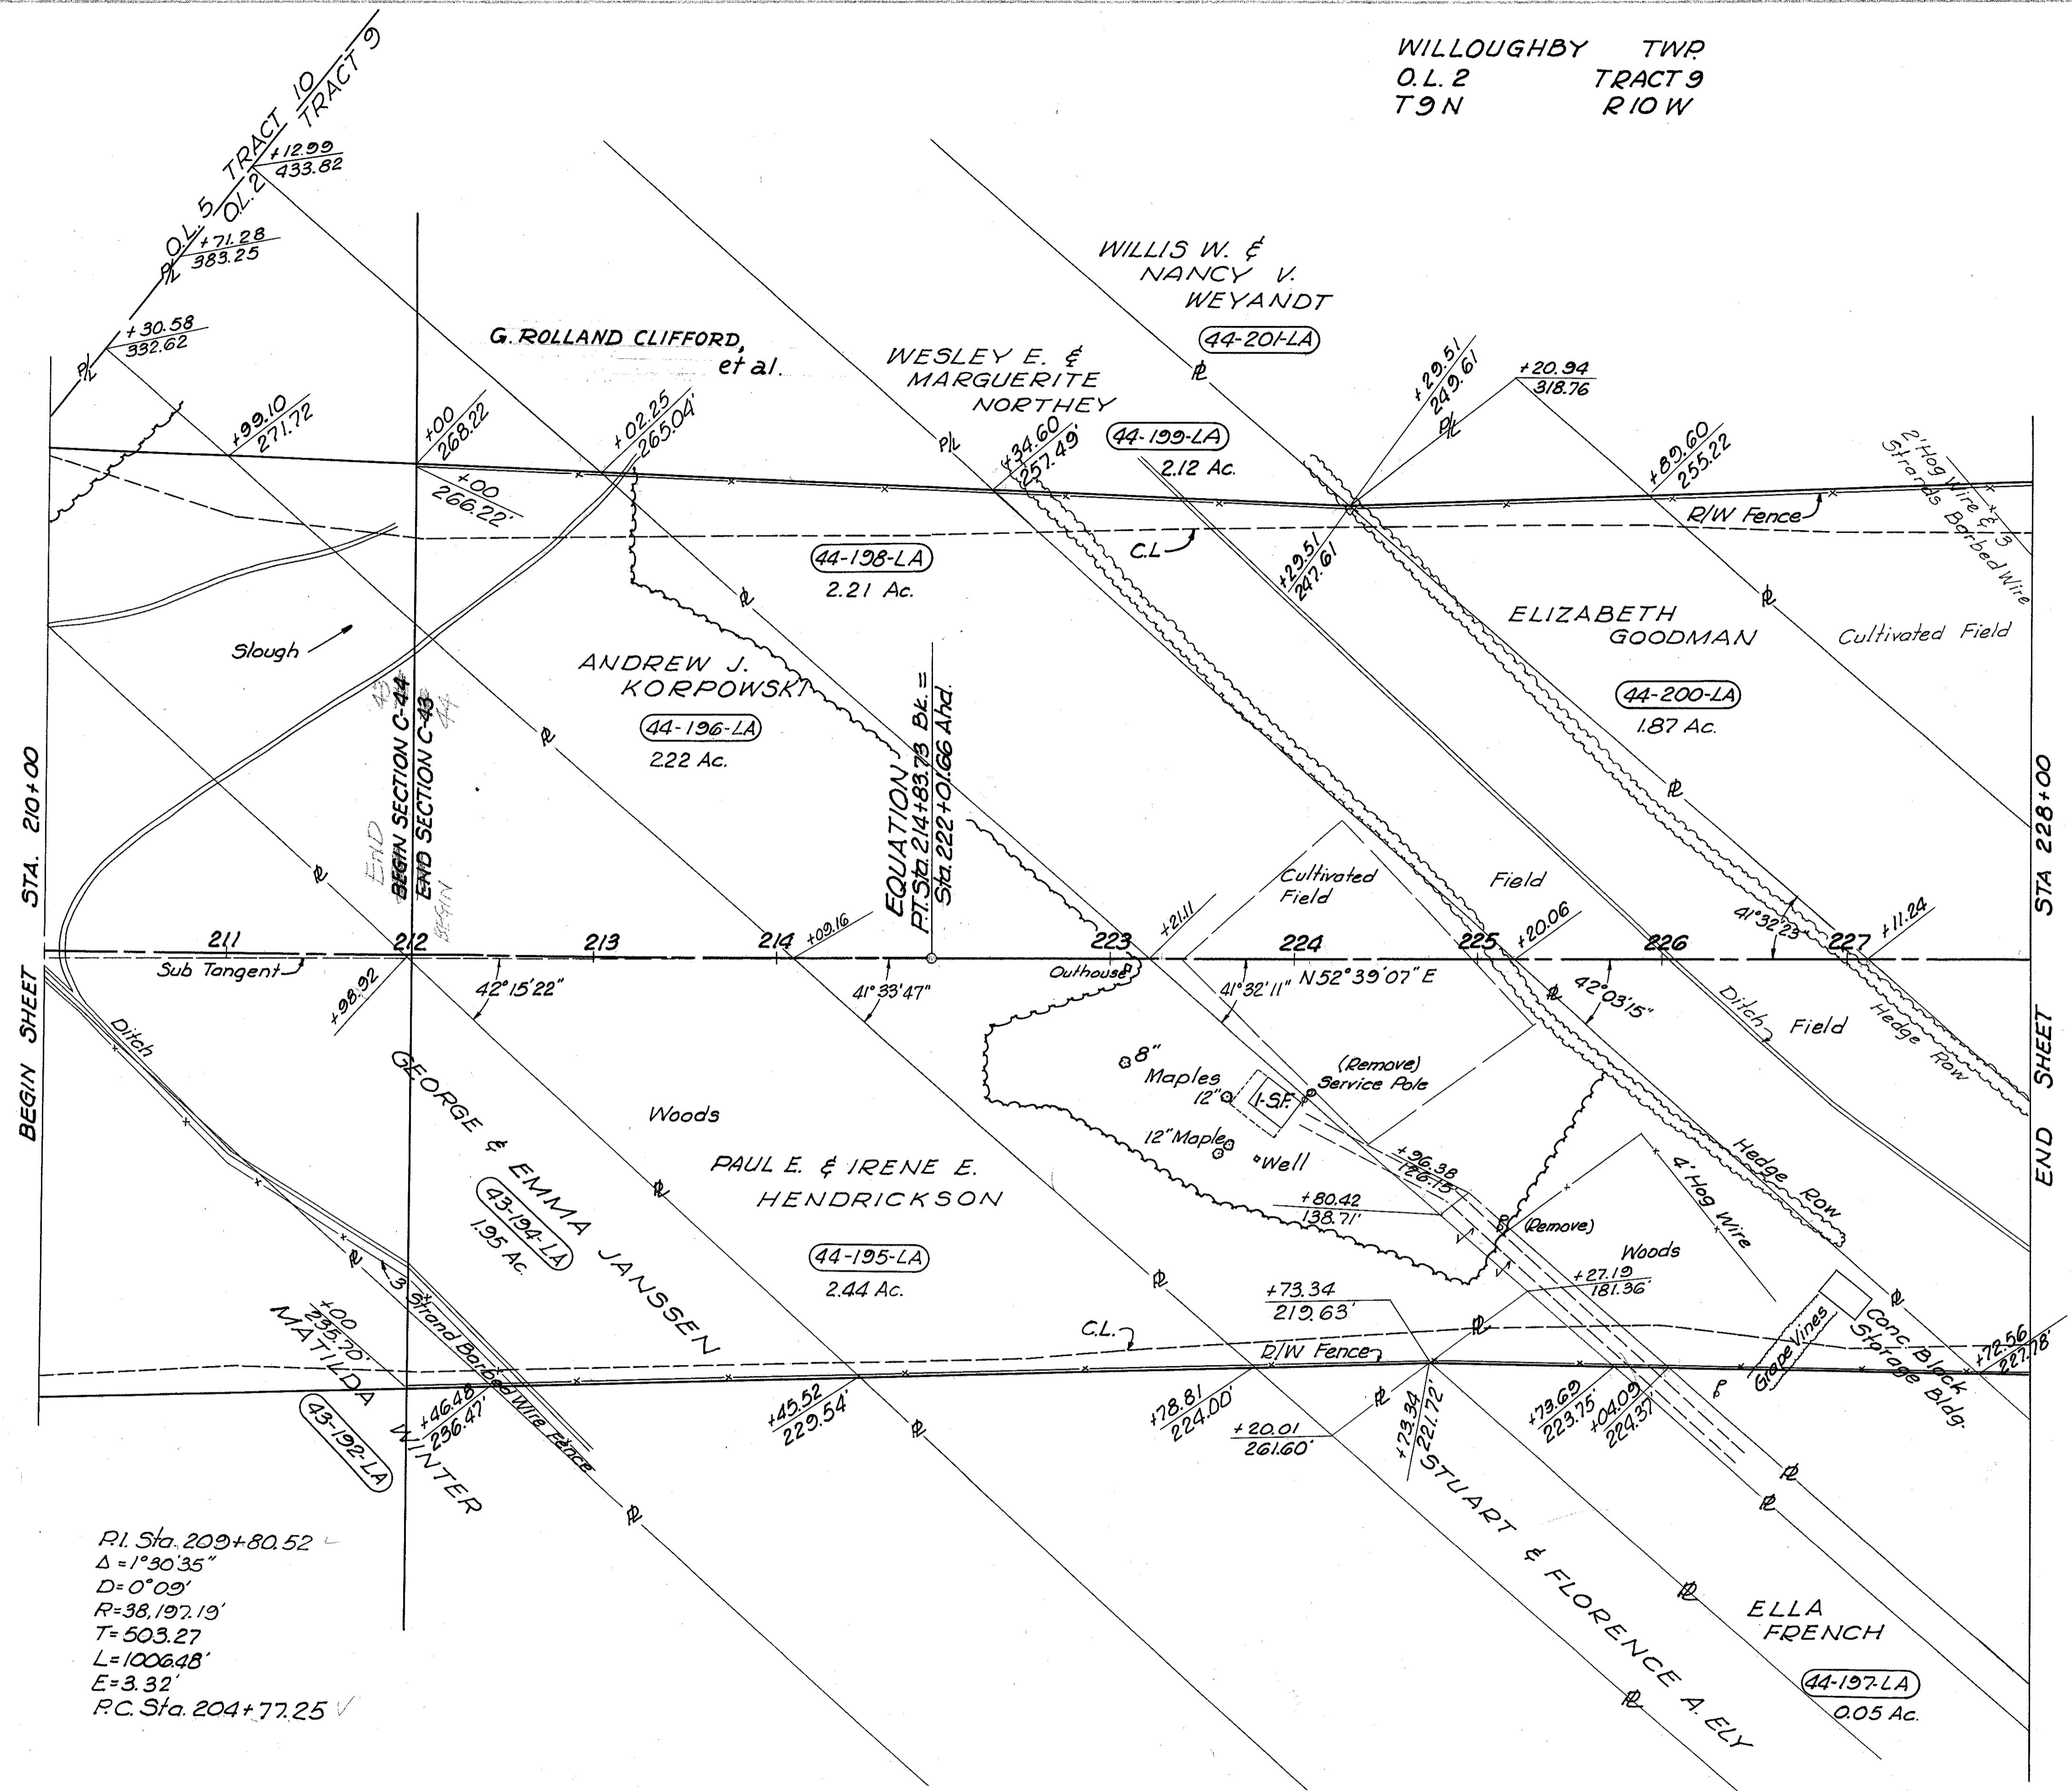

- STRUCTURES TO BE REMOVED**
- Parcel No. 44-196-LA
1-1 Story Frame Res.
1-Out Building
 - Parcel No. 44-198-LA
1-Conc. Block Storage Building

PI Sta. 209+80.52
Δ = 1°30'35"
D = 0°09'
R = 38,197.13'
T = 503.27
L = 1006.48'
E = 3.32'
P.C. Sta. 204+77.25

1762 Lin. Ft. Type "D" Fence

MICHAEL BAKER JR., CONSULTING ENGINEERS ROCHESTER, PENNSYLVANIA					
DATE: 3-23-59	STATE OF OHIO DEPARTMENT OF HIGHWAYS RIGHT OF WAY PLANS STATE HIGHWAY NO. 1 C-44 STA. 210+00 TO STA. 228+00				
Designed	Drawn	Traced	Checked	Reviewed	Date
J.P.	M.P.	E.M.	R.G.		