



LAK-90-8.77/29.20

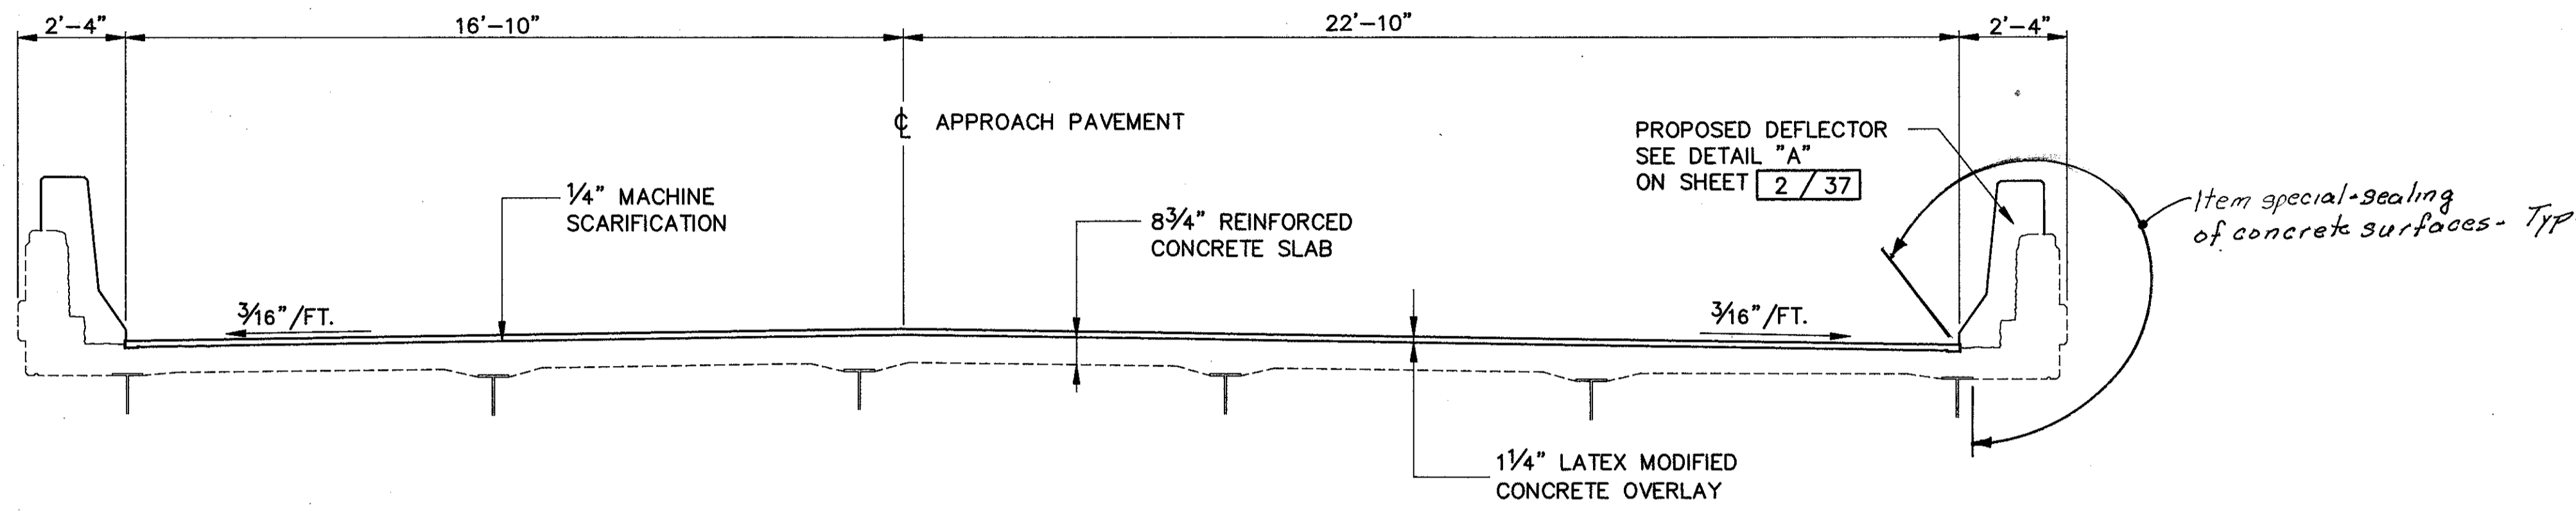

LAK-90-1641R
LAK-90-2110R

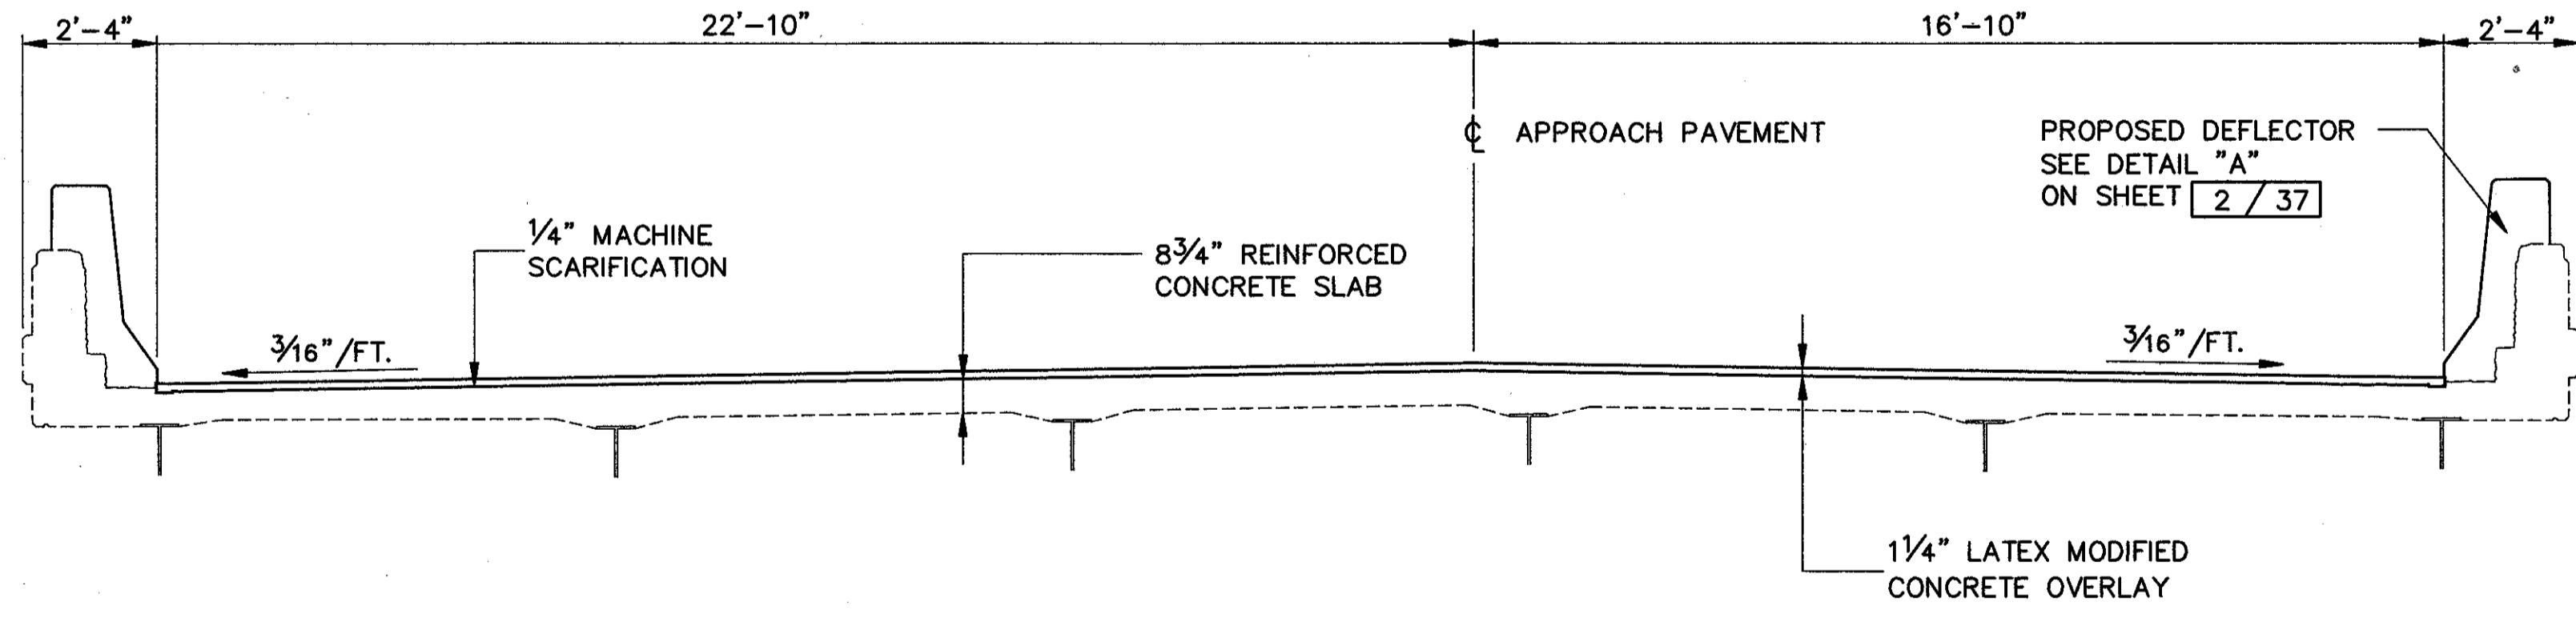

LAK-90-1641L
LAK-90-2110L

CT COLPETZER-THOMAS, INC. AN ENGINEERING GROUP						
WILLOUGHBY • MENTOR • NORTH CANTON • STEUBENVILLE • LORAIN						4 / 37
TYPICAL SECTIONS						
LAK-90-1641L/1641R						
LAK-90-2110L/2110R						
DESIGNED	DRAWN	TRACED	CHECKED	REVIEWED	DATE	REVISED
J.E.A.	R.L.B.	R.L.B.	R.J.C.	B.J.A.	11/2/87	