PLOT SUBMITTED: 1-JUN-1990 09:34
PLOT SUBMITTED BY: GRMOVSEK
ZFI:[100,350]BR90AUBI.DGN

LAKE COUNTY LAK-90-8.77/29.20	OHIO
	FHWA REGION 5
	FEDERAL PROJECT

57C 101

CHANGE ORDER

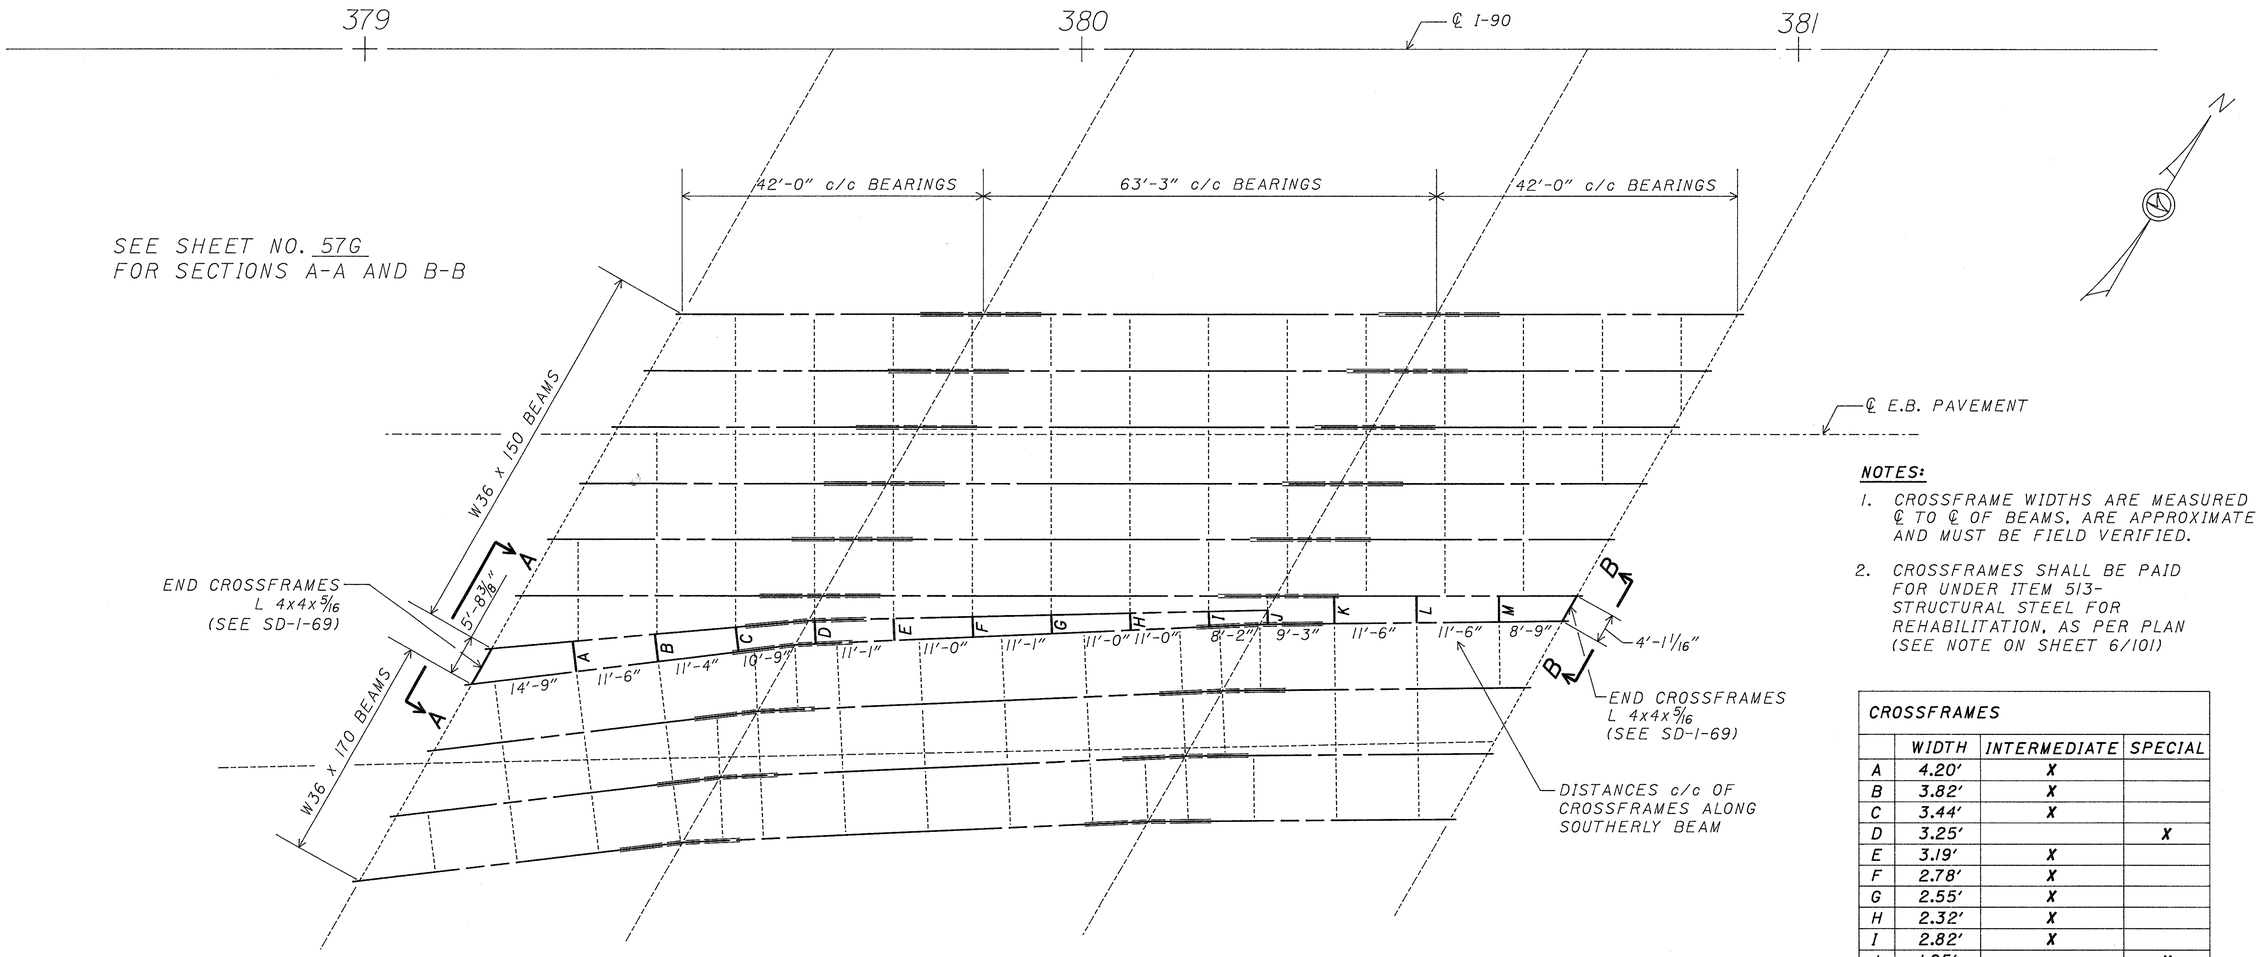

NOTES:

1. CROSSFRAME WIDTHS ARE MEASURED ℄ TO ℄ OF BEAMS, ARE APPROXIMATE AND MUST BE FIELD VERIFIED.
2. CROSSFRAMES SHALL BE PAID FOR UNDER ITEM 513- STRUCTURAL STEEL FOR REHABILITATION, AS PER PLAN (SEE NOTE ON SHEET 6/101)

CROSSFRAMES			
	WIDTH	INTERMEDIATE	SPECIAL
A	4.20'	X	
B	3.82'	X	
C	3.44'	X	
D	3.25'		X
E	3.19'	X	
F	2.78'	X	
G	2.55'	X	
H	2.32'	X	
I	2.82'	X	
J	1.95'		X
K	3.88'	X	
L	3.76'	X	
M	3.65'	X	

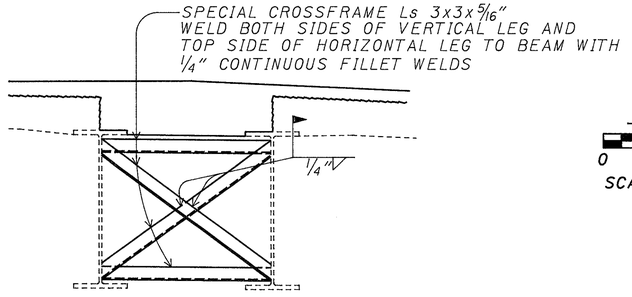

SPECIAL CROSSFRAMES

PLAN

0 10 20

SCALE IN FEET

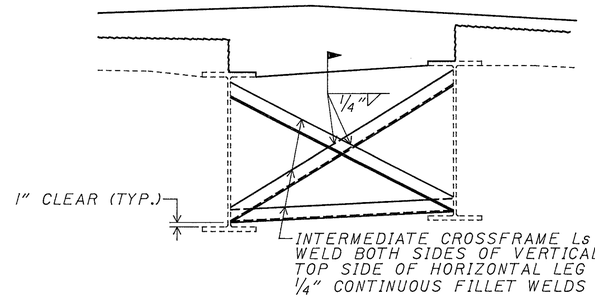

INTERMEDIATE CROSSFRAMES

STATE OF OHIO
DEPARTMENT OF TRANSPORTATION
DISTRICT 12 LOCATION & DESIGN

FRAMING PLAN

BR. NO. LAK-90-1487R
I-90 E.B. OVER AUBURN ROAD

LAKE COUNTY				OHIO
DESIGNED	TRACED	CHECKED	REVIEWED	REVISED
ENF	JAG	DWL	DATE	SHEET 3/7