

# TRANSVERSE SECTIONS

LAKE COUNTY  
LAK-90-8.77/29.20

OHIO

FHWA REGION 5



FEDERAL PROJECT

57D  
101



## CHANGE ORDER

NOTE:

EX. 1/2" ASPHALT OVERLAY NOT SHOWN.

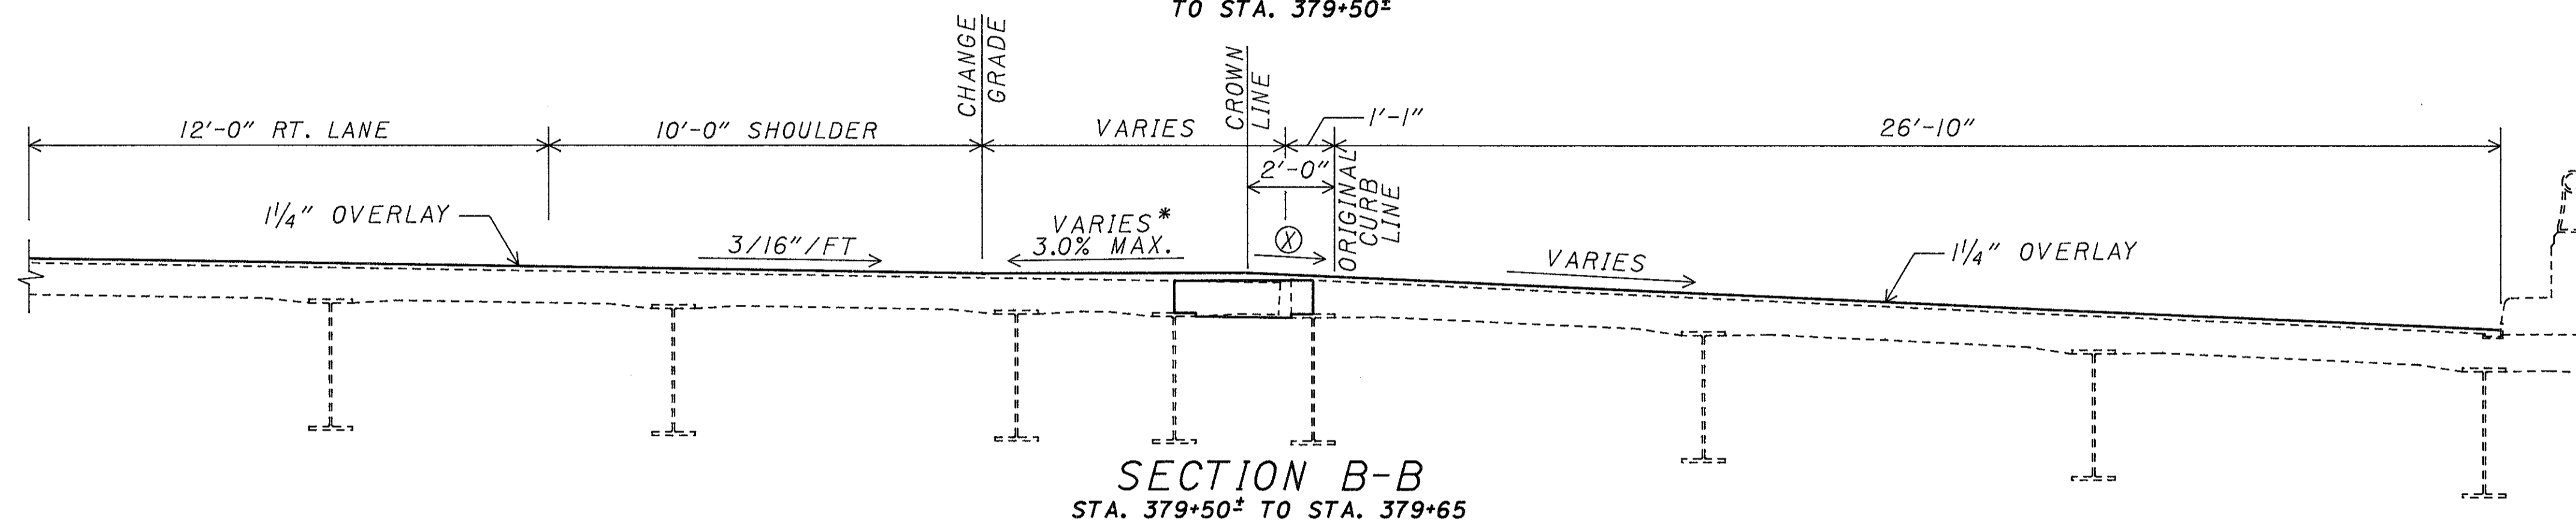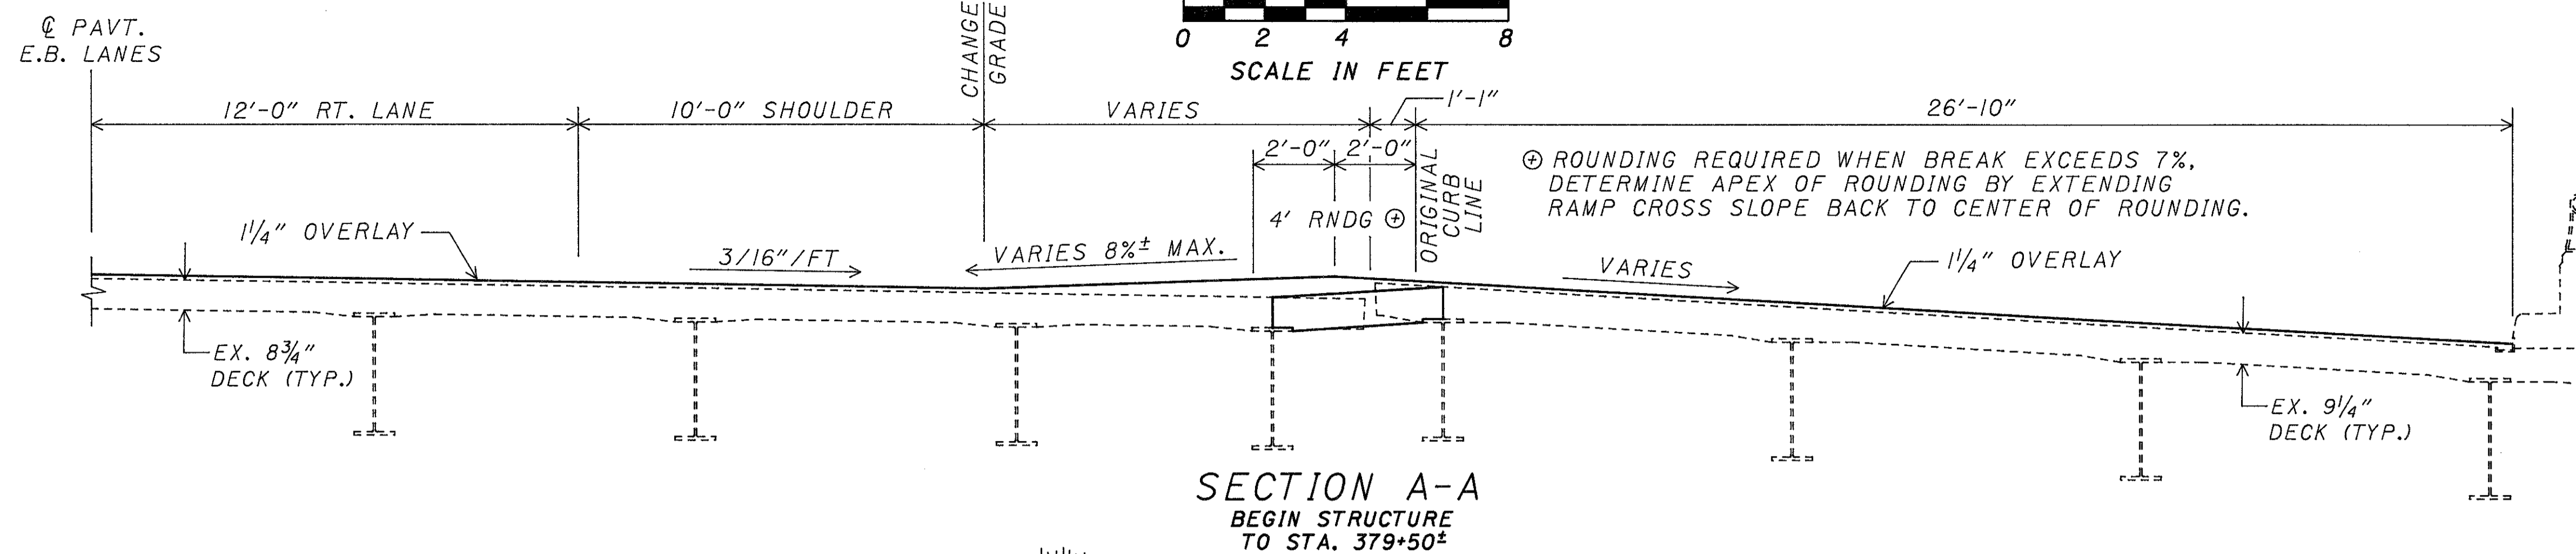

\* - FLAT AT STA. 379+65  
⊗ - MATCH EXISTING RAMP CROSS SLOPE

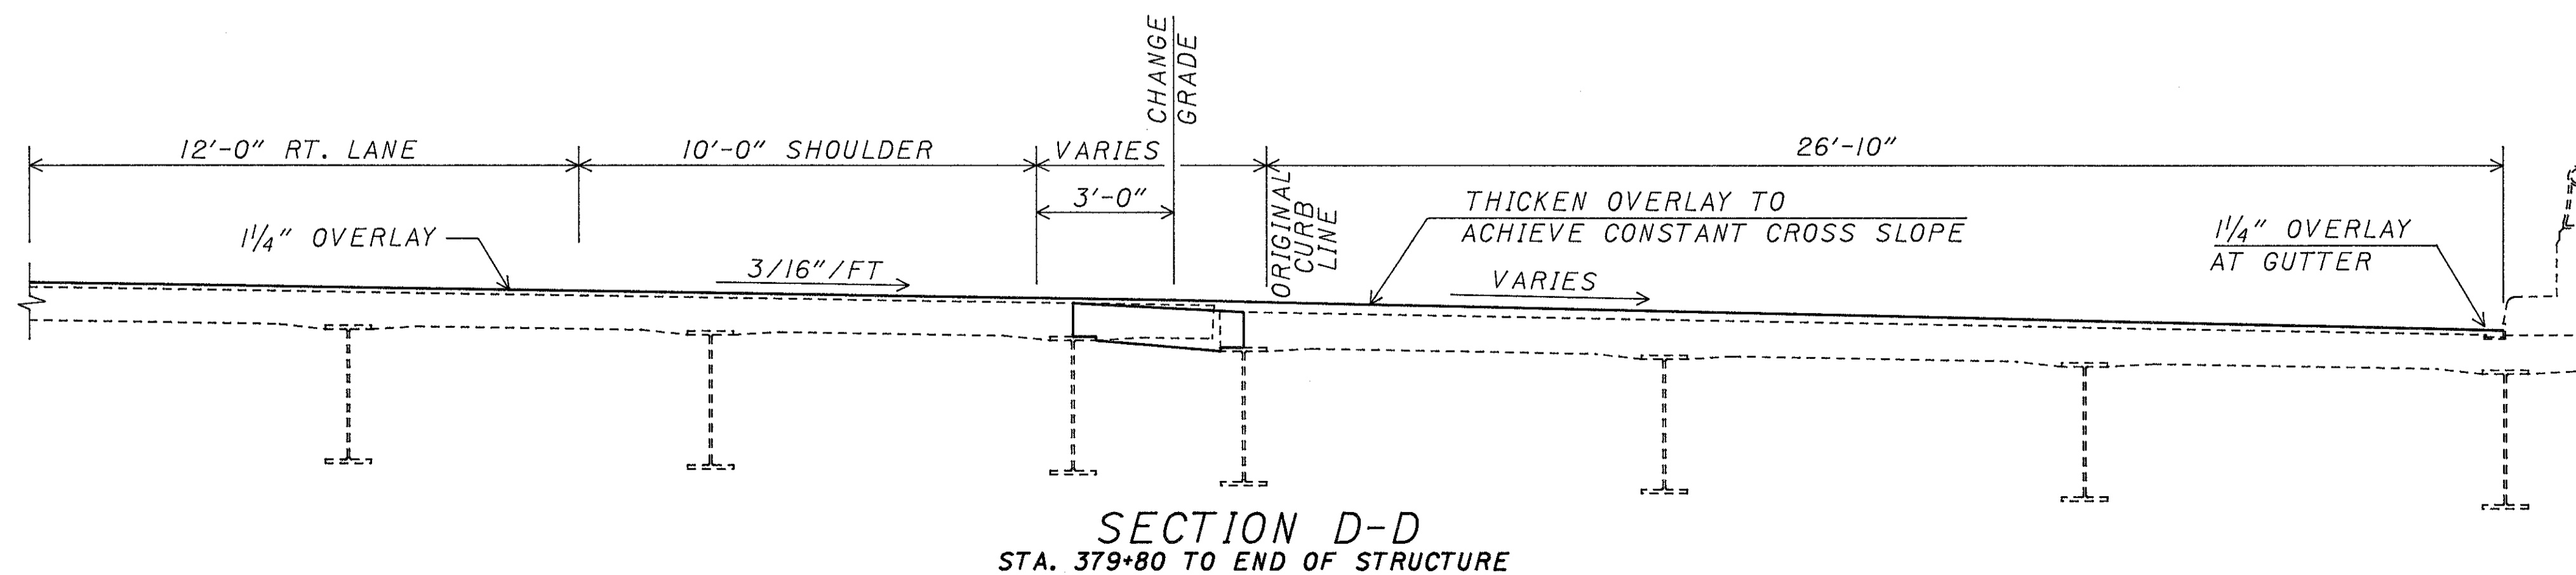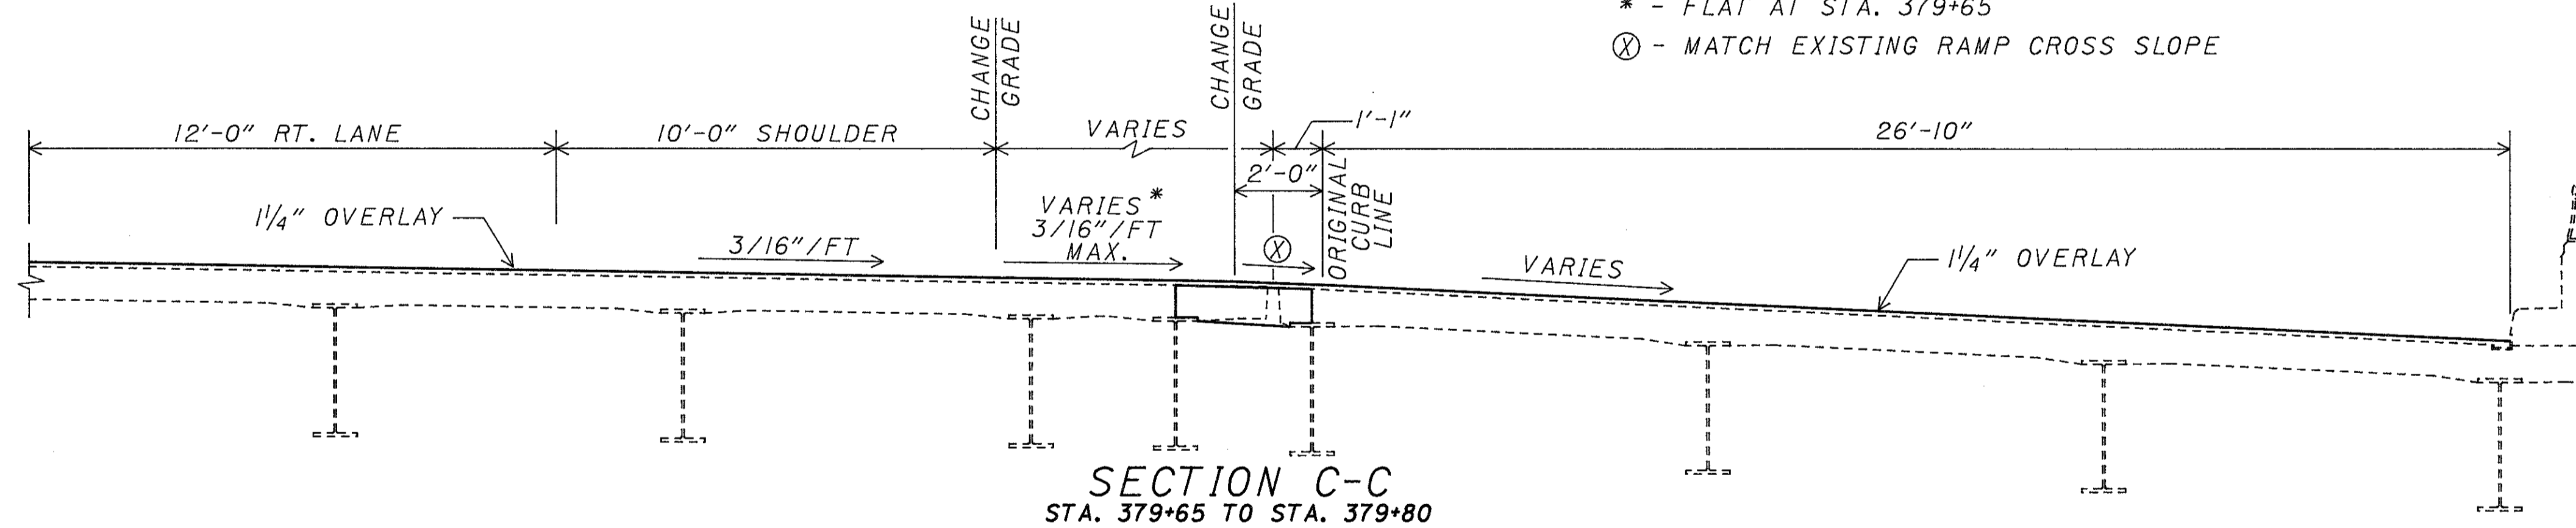

STATE OF OHIO  
DEPARTMENT OF TRANSPORTATION  
DISTRICT 12 LOCATION & DESIGN

## TRANSVERSE SECTIONS

BR. NO. LAK-90-1487R  
I-90 E.B. OVER AUBURN ROAD

DESIGNED	TRACED	CHECKED	REVIEWED	REVISED
ENF	JAG	DWL	DATE	SHEET 4 / 7

PLOT SUBMITTED BY: GRMOVSEK

PLOT SUBMITTED BY: GRMOVSEK

ZFI:[100,350]BR90ATYP.DGN

1  
2  
