PLOT SUBMITTED: 1-JUN-1990 09:38
ZFI:L100,350JBR90DETI.DGN;1
PLOT SUBMITTED BY: GRMOVSEK

JOINT DETAILS

0 3" 6" 1'
SCALE

LAKE COUNTY LAK-90-8.77/29.20	OHIO
	FHWA REGION 5
	FEDERAL PROJECT

57E 101

CHANGE ORDER

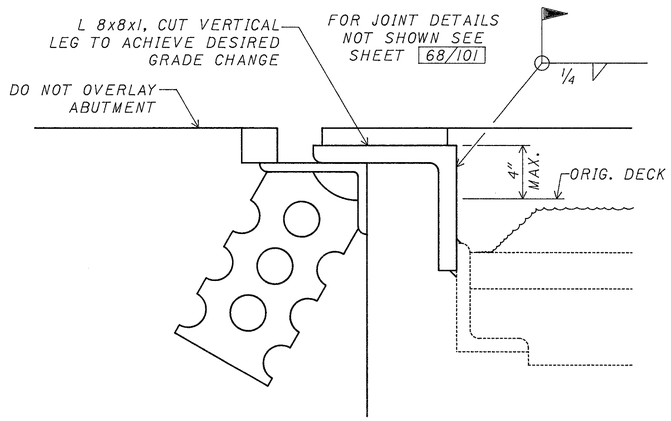

PROPOSED

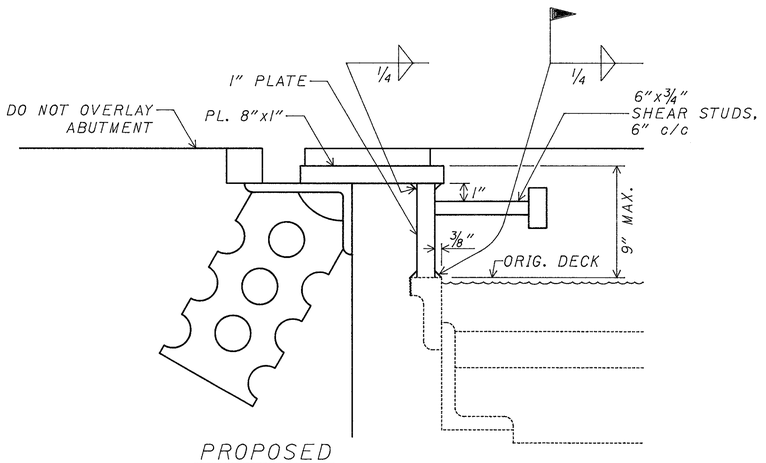

PROPOSED

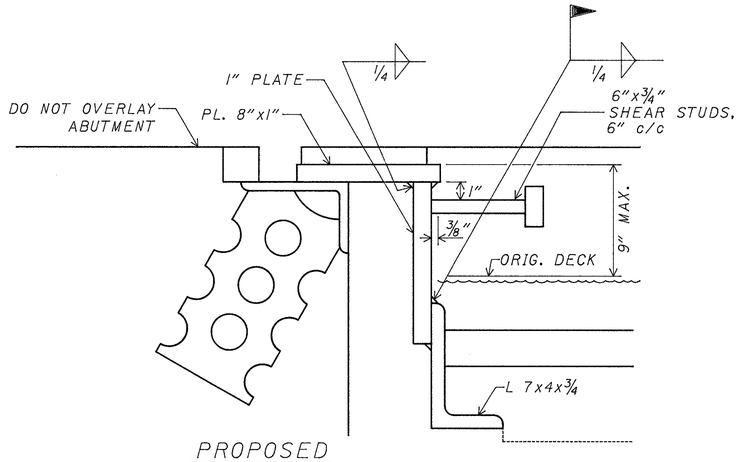

PROPOSED

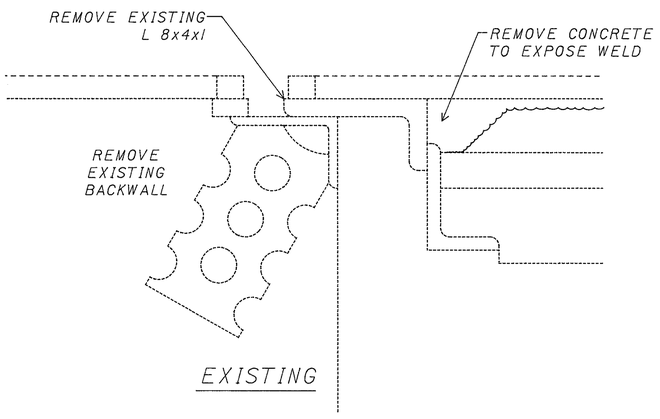

EXISTING

EXPANSION JOINT MODIFICATIONS - DETAIL A (RAISING ORIGINAL JOINT 0" TO 4" - REAR ABUTMENT)

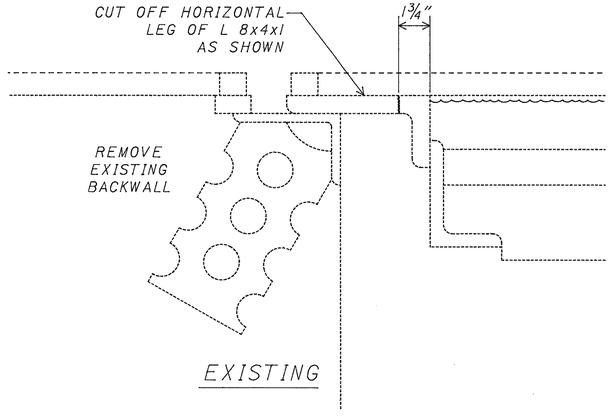

EXISTING

EXPANSION JOINT MODIFICATIONS - DETAIL B RAISING JOINT 4" TO 9" - REAR ABUTMENT

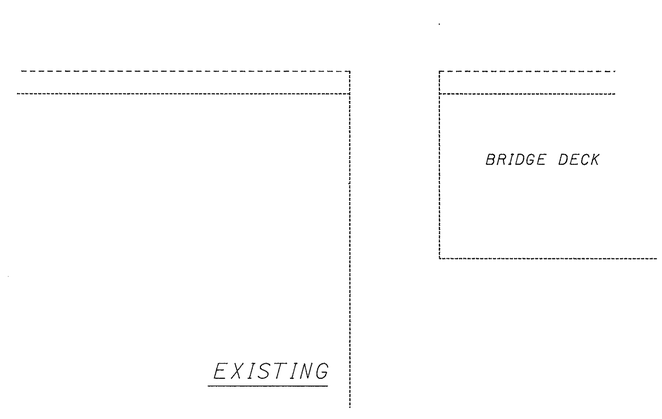

EXISTING

EXPANSION JOINT MODIFICATIONS - DETAIL C (PREVIOUS OPEN BAY - REAR ABUTMENT)

NOTES:

1. EXACT DIMENSIONS INCLUDING JOINT RAISING HEIGHTS SHALL BE BASED UPON FIELD MEASUREMENTS TAKEN AFTER THE DECK IN THE OPEN BAY HAS BEEN REMOVED.
2. 7"x1" JOINT RAISING SHALL BE FIELD INSTALLED AFTER THE ABUTMENT HAS BEEN CONSTRUCTED.
3. SEE SD-1-69 FOR ADDITIONAL JOINT DETAILS. (BOLTS, BOLT HOLES, ANCHOR BARS, ETC.)
4. BACKWALL PORTION OF JOINT AND 7"x1" RAISING ON DECK SIDE OF JOINT INCLUDED UNDER ITEM 516 - VERTICAL EXTENSION OF STRUCTURAL EXPANSION JOINTS, AS PER PLAN (SEE SHEET 68/101)
5. DECK PORTION OF JOINT INCLUDED UNDER ITEM 513 - STRUCTURAL STEEL FOR REHABILITATION, AS PER PLAN (SEE NOTE ON SHEET 6/101)

STATE OF OHIO
DEPARTMENT OF TRANSPORTATION
DISTRICT 12 LOCATION & DESIGN

JOINT DETAILS

BR. NO. LAK-90-1487R
I-90 E.B. OVER AUBURN ROAD

LAKE COUNTY OHIO

DESIGNED	TRACED	CHECKED	REVIEWED	REVISED
ENF	JAG	DWL	DATE	SHEET 5 / 7