


S.R. 91 R/W & CURVE DATA

D	= 7200.00'
R	= 5729.58'
Δ	= 3°45'45"
T	= 138.19'
L	= 376.25'
C	= 376.18'
E	= 3.09'
PC STA.	122+89.93

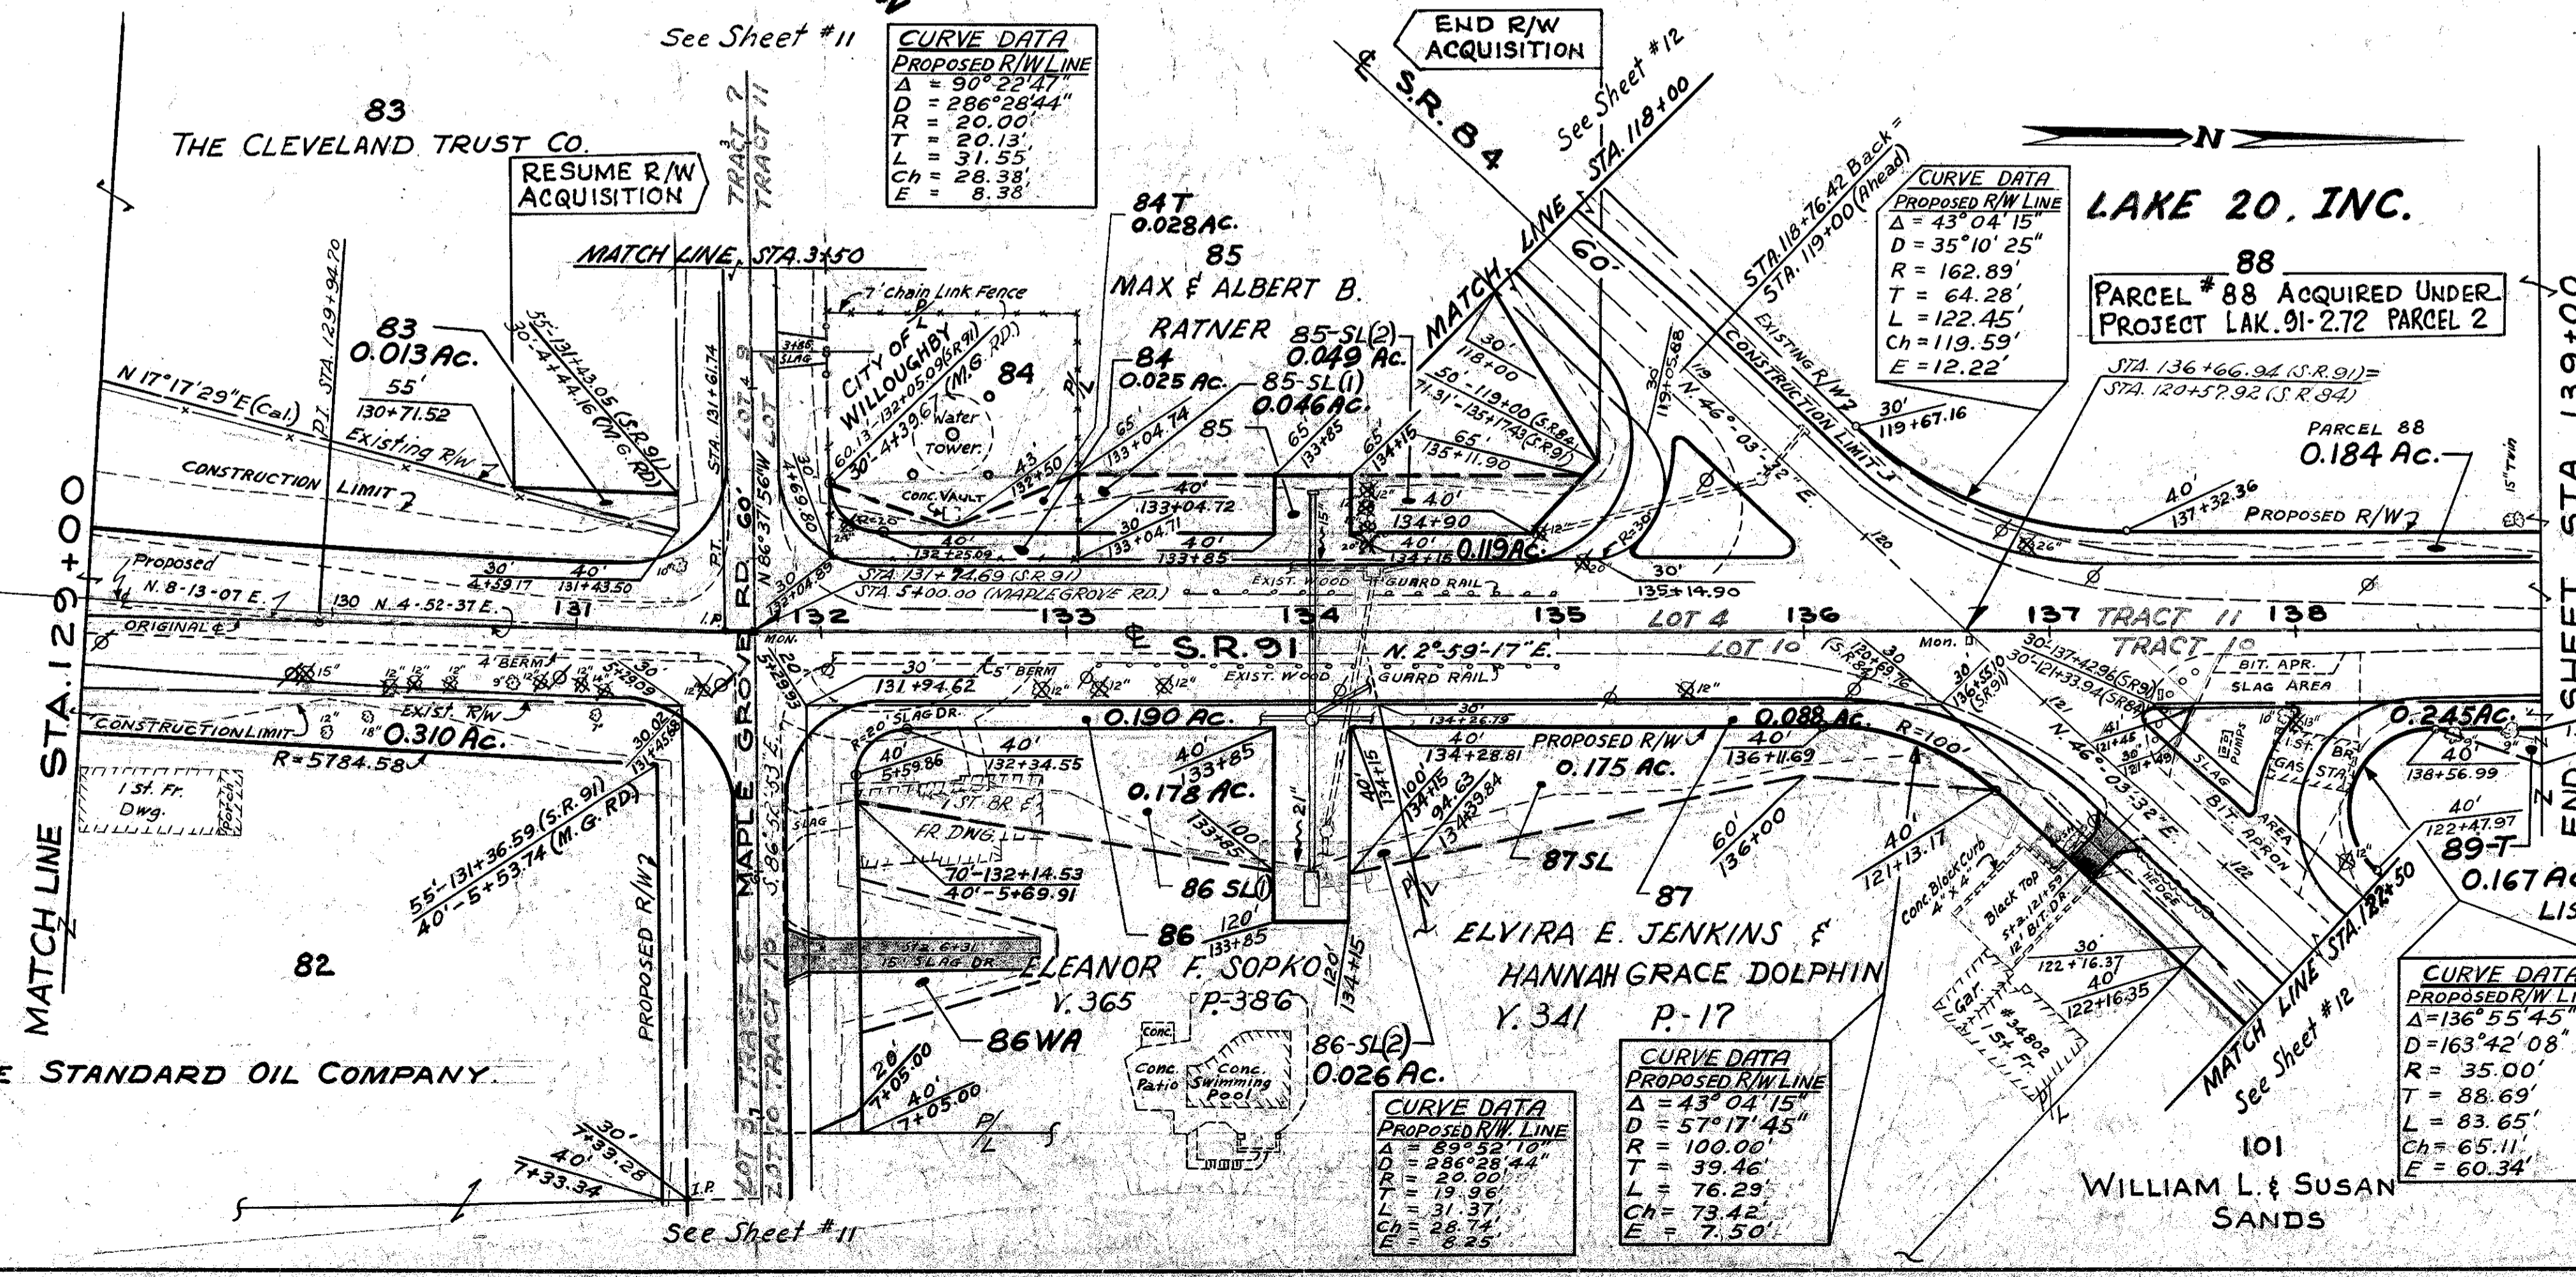

CURVE DATA PROPOSED R/W LINE

Δ	= 90°22'41"
D	= 286°28'44"
R	= 20.00'
T	= 20.13'
L	= 31.55'
Ch	= 28.38'
E	= 8.38'

CURVE DATA PROPOSED R/W LINE

Δ	= 43°04'15"
D	= 35°10'25"
R	= 162.89'
T	= 64.28'
L	= 122.45'
Ch	= 119.59'
E	= 12.22'

CURVE DATA PROPOSED R/W LINE

Δ	= 136°55'45"
D	= 163°42'08"
R	= 35.00'
T	= 88.69'
L	= 83.65'
Ch	= 65.11'
E	= 60.34'

S.R. 91 R/W & CURVE DATA

D	= 7200.00'
R	= 5729.58'
Δ	= 3°20'30"
T	= 167.13'
L	= 334.17'
C	= 334.12'
E	= 2.44'
PC STA.	128+27.57

Date	REVISIONS	BY
9-19-63	Parcels 82 & 120 combined-Property owner changed.	A.M.
	COMPLETED	Date: -