


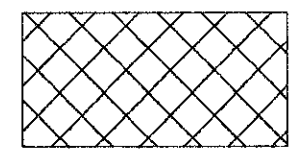



NO.	REVISIONS	BY	DATE
1	DELETE SIGN	JPR	8/3/00
2	DELETE SIGNAL TIMING NOTE	JPR	8/3/00

DURING EACH PHASE OF CONSTRUCTION, THE CONTRACTOR SHALL TEMPORARILY MODIFY THE SIGNAL PHASING AT EACH RAMP BY ELIMINATING THE LEFT TURN PHASE FROM S.R. 91 ONTO THE RESPECTIVE RAMP. A R-121 SIGN SHALL BE MOUNTED ON THE DRUMS ADJACENT TO THE LEFT TURN LANE. AFTER COMPLETION OF CONSTRUCTION, THE CONTRACTOR SHALL REMOVE THE R-121 SIGN AND SHALL RETURN THE CONTROLLER TO THE ORIGINAL SETTINGS. SIGNAL TIMINGS SHALL ALSO BE ADJUSTED ON THE VINE STREET DETOUR AS DIRECTED BY THE ENGINEER. THE COST OF SIGNAL MODIFICATION SHALL BE INCLUDED IN THE UNIT PRICE BID FOR ITEM 614 MAINTENANCE OF TRAFFIC.

ALL CONFLICTING SIGNAGE SHALL BE COVERED. ALL CONFLICTING PAVEMENT MARKINGS SHALL BE COVERED WITH TEMPORARY TAPE.

NOTE: ALL SIGNS SHALL BE LOCATED PER THE STANDARD CONSTRUCTION DRAWINGS. S.R. 91 LANE CLOSURES SHALL BE PER MT-95.30 WITH ADDITIONAL SIGNAGE AS INDICATED.

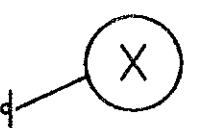-  WORK AREA - PHASE II
-  WORK AREA - PHASE IV
-  DETOUR ROUTE
-  CONSTRUCTION SIGNING (REFER TO SIGNING LEGEND FOR REQUIRED SIGNS)

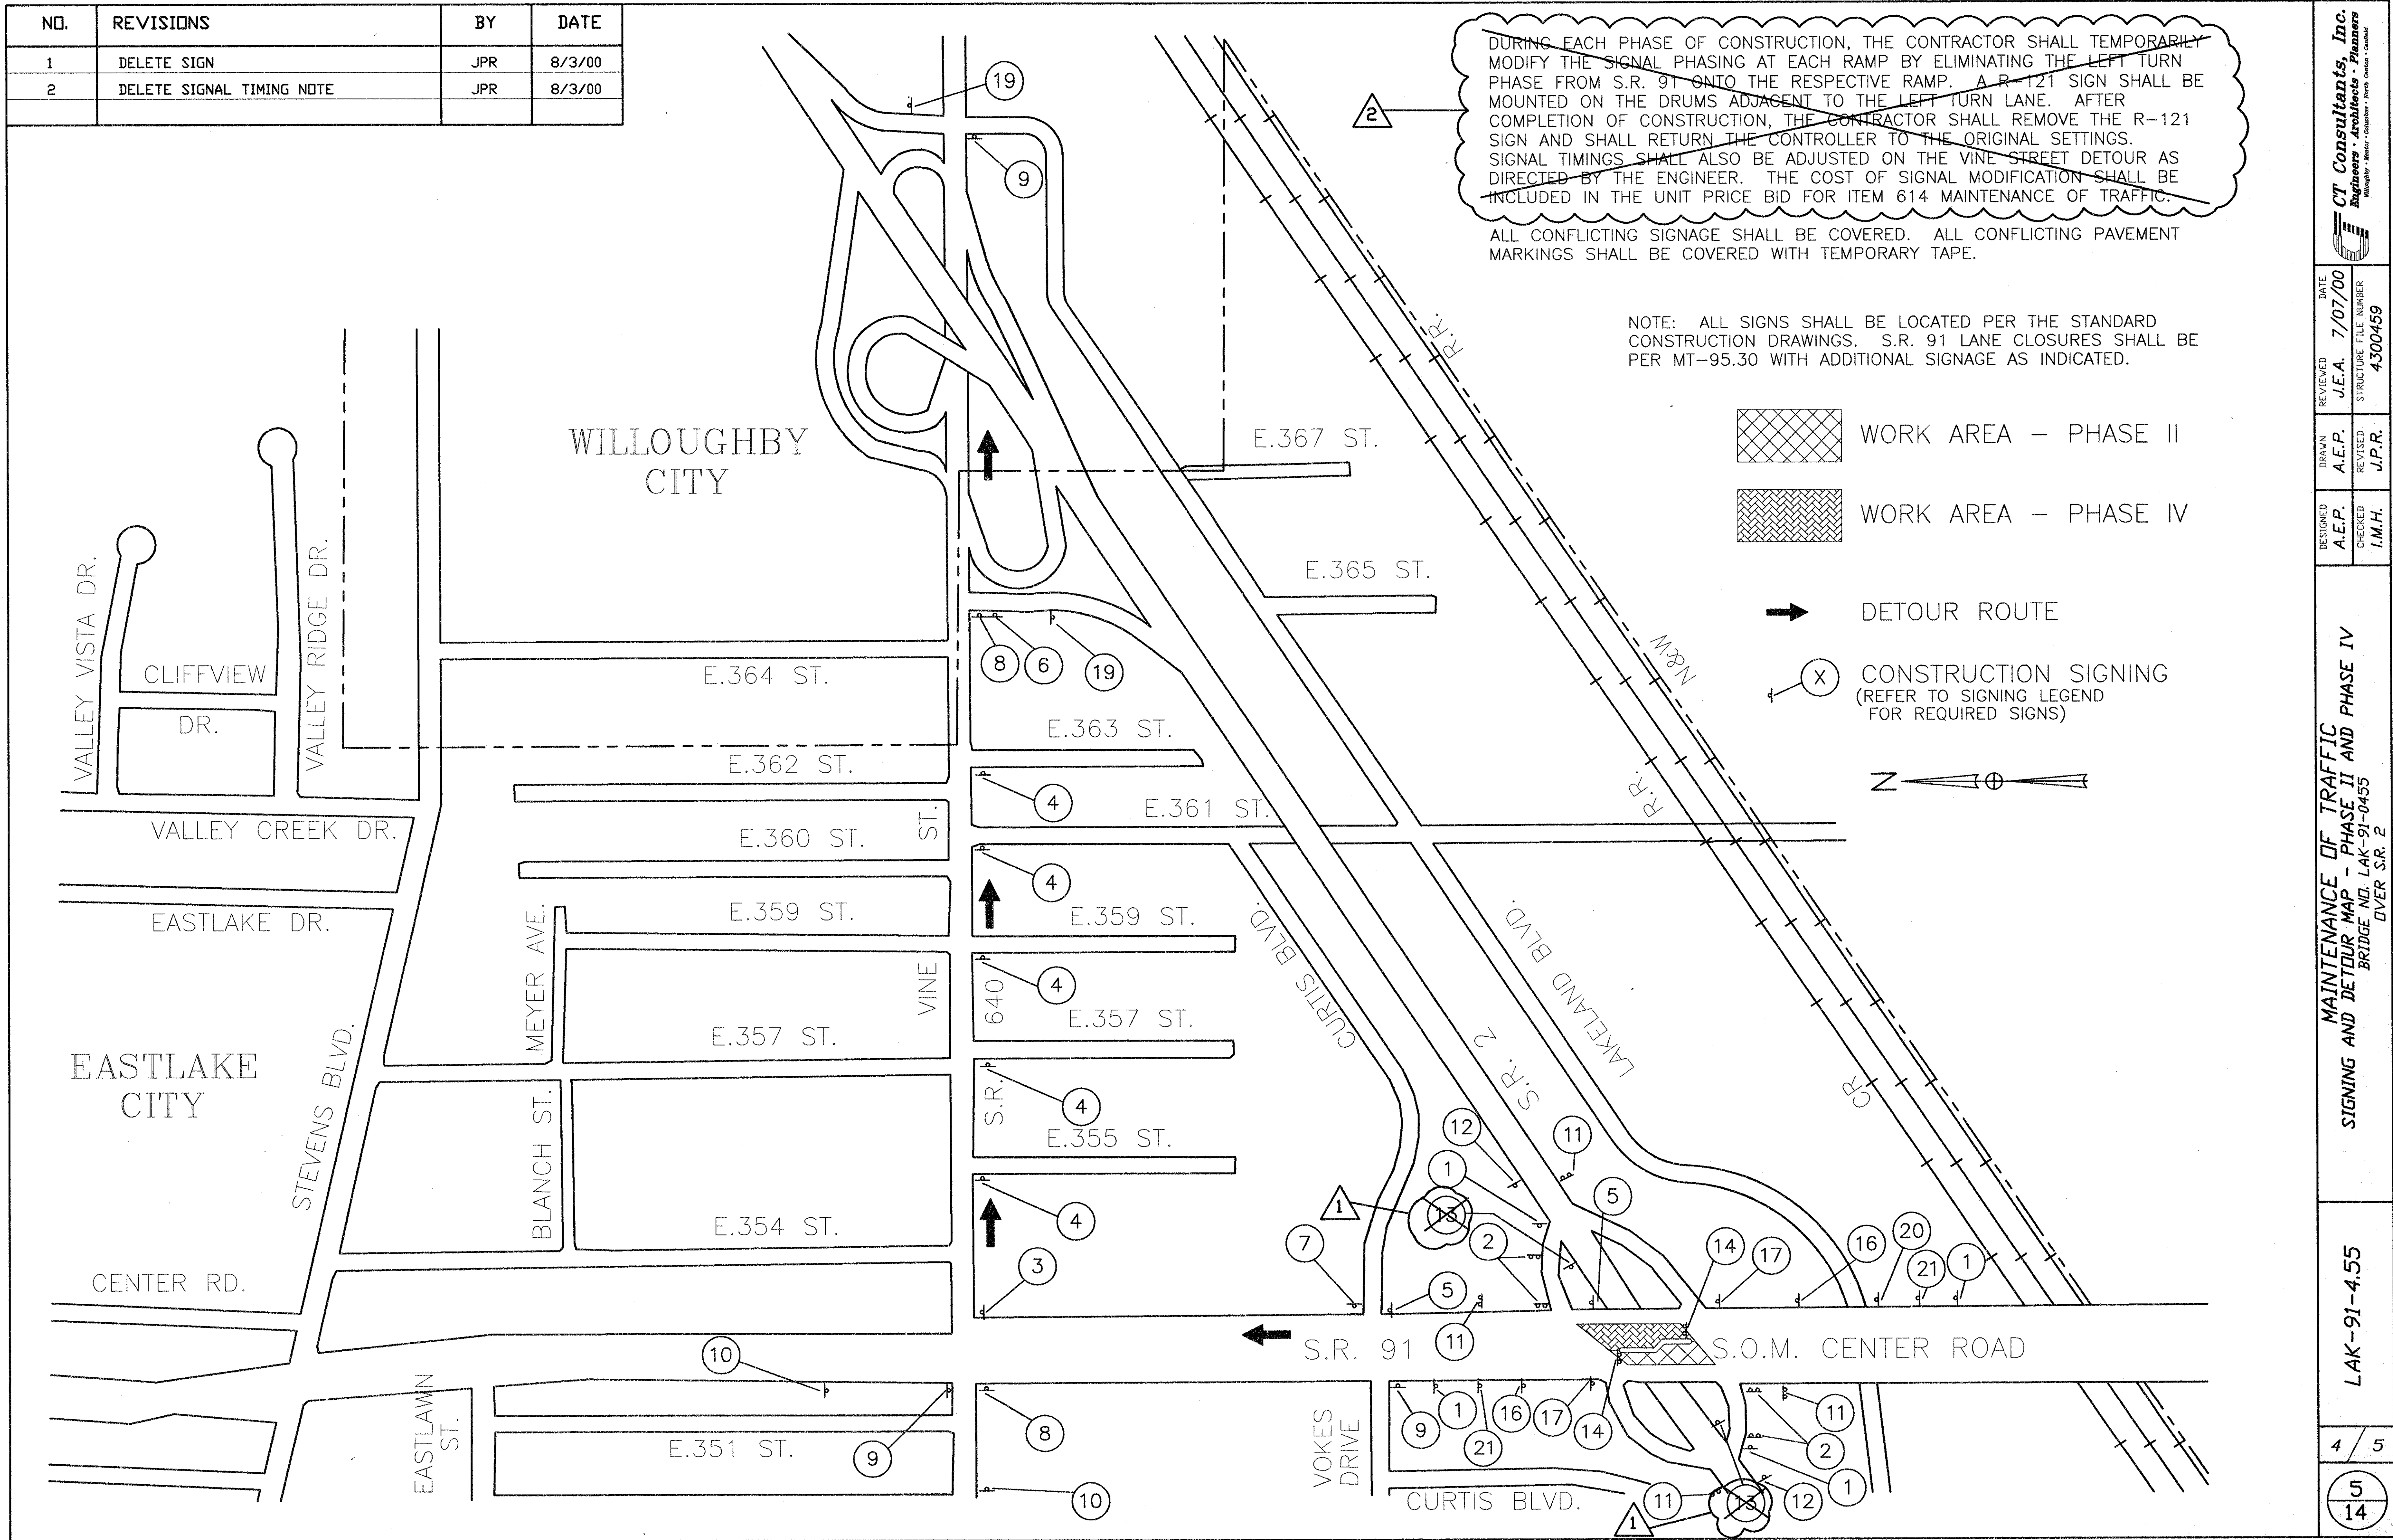

H:\2000\00063\CA0\TRAFFIC\063M01.DWG PLOT SCALE 1:12

**CT Consultants, Inc.**  
 Engineers - Architects - Planners  

DATE: 7/07/00  
 REVIEWED: J.E.A.  
 DRAWN: A.E.P.  
 DESIGNED: A.E.P.  
 CHECKED: I.M.H.

STRUCTURE FILE NUMBER: 4300459  
 REVISED: J.P.R.  
 MAINTENANCE OF TRAFFIC  
 SIGNING AND DETOUR MAP - PHASE II AND PHASE IV  
 BRIDGE NO. LAK-91-0455  
 OVER S.R. 2

LAK-91-4.55  
 4 / 5  
 5 / 14