
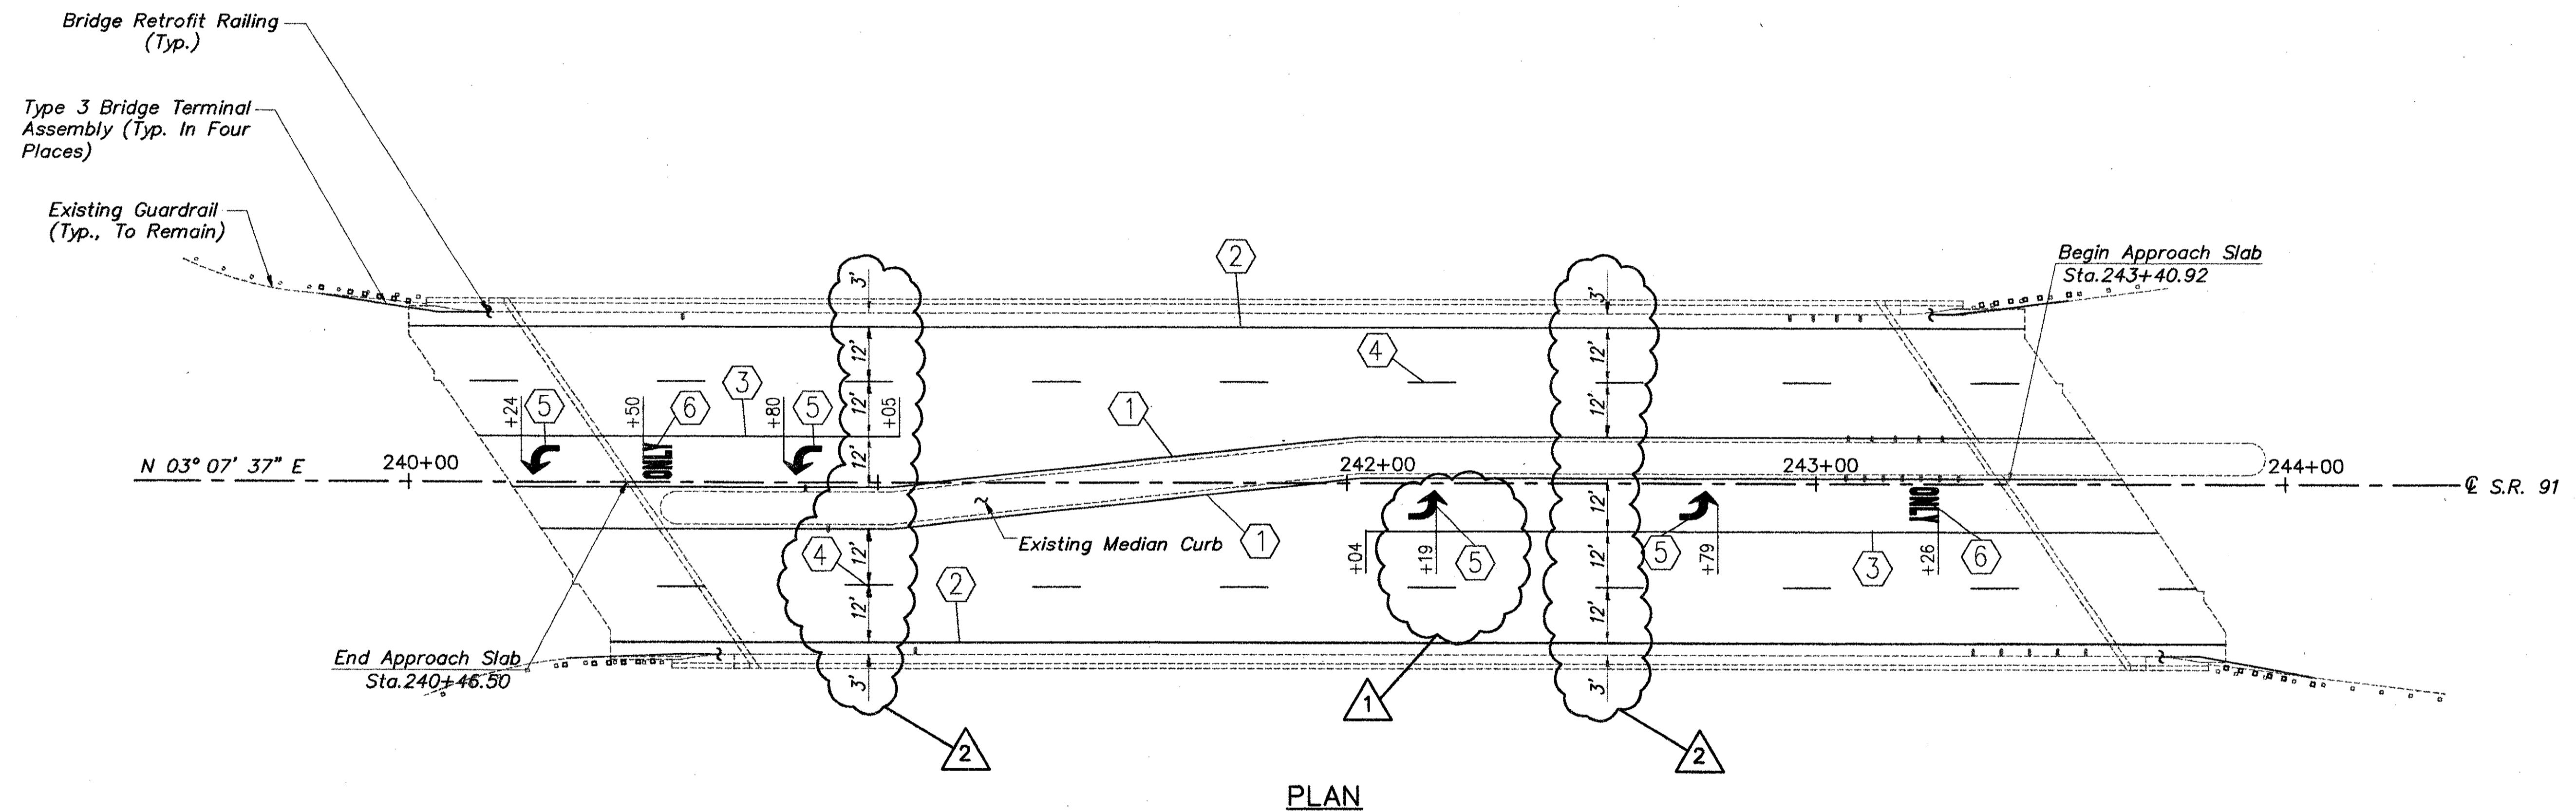


NOTE: MATCH ALL EXISTING PAVEMENT MARKINGS AT THE LIMITS OF RESURFACING.  
 ANY ADDITIONAL PAVEMENT MARKINGS DAMAGED BY THE CONTRACTOR'S  
 OPERATIONS SHALL BE REPLACED AT THE CONTRACTOR'S EXPENSE.

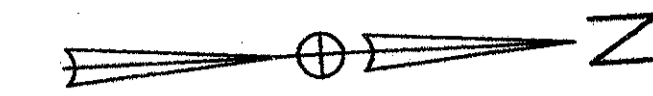

PLAN

PAVEMENT MARKING LEGEND

- ① ITEM 828 - EDGE LINE, YELLOW
- ② ITEM 828 - EDGE LINE, WHITE
- ③ ITEM 828 - CHANNELIZING LINE
- ④ ITEM 828 - LANE LINE
- ⑤ ITEM 828 - LANE ARROW
- ⑥ ITEM 828 - WORD ON PAVEMENT, 72"

NO.	REVISIONS	BY	DATE
1	PAVEMENT MARKING TYPE	JPR	8/3/00
2	PAVEMENT MARKING SPACING	JPR	8/3/00

H:\2000\00063\CAD\063PLOT1.DWG PLOT SCALE 1:20