


SCALE

### S. EXIT RAMP S.R. 2

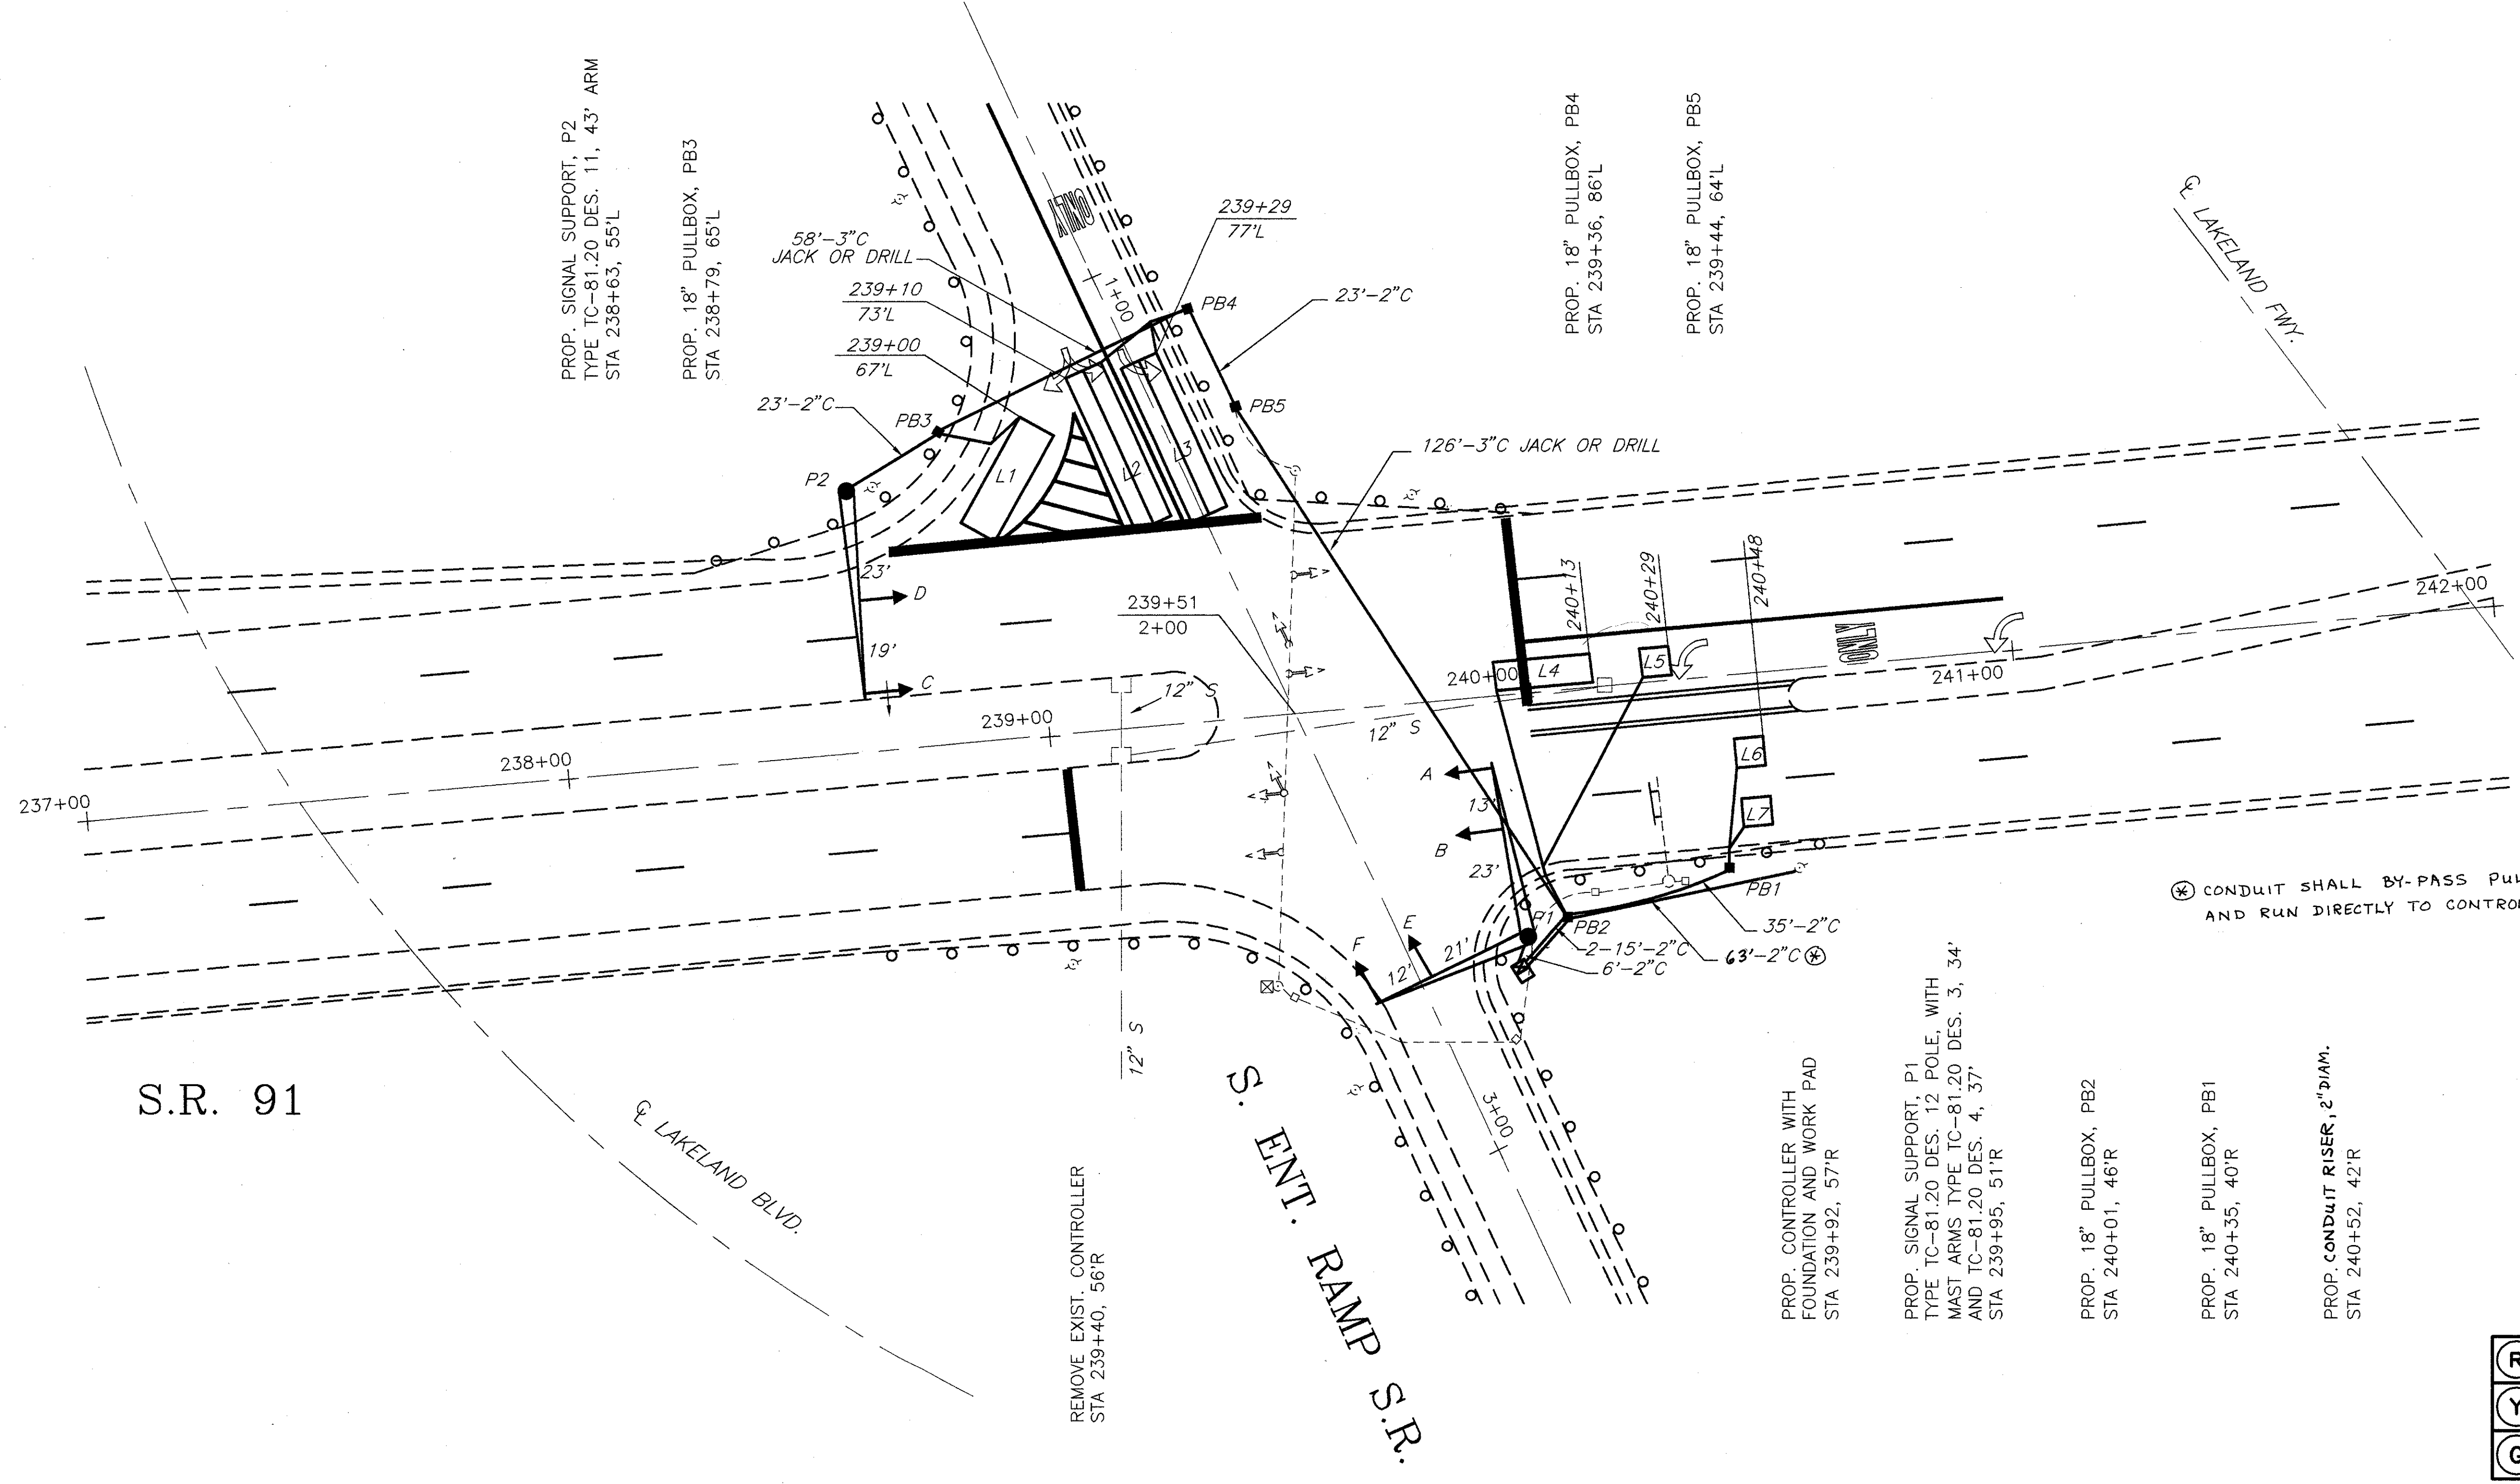


S.R. 91

LAKELAND BLVD.

S. ENT. RAMP S.R. 2

R/W

THE UNDERGROUND UTILITIES ARE SHOWN ACCORDING TO INFORMATION FURNISHED BY THE UTILITIES CONCERNED. THEIR ACCURACY IS NOT GUARANTEED, THEREFORE THEY SHOULD BE RECHECKED BEFORE UNDERGROUND CONSTRUCTION BEGINS.

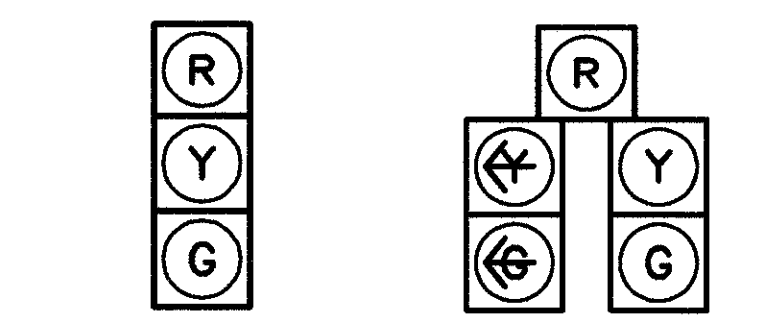

A, B, D, E & F      C

ALL HEADS ARE 12" POLY

SIGNALS