




# CURTIS BLVD

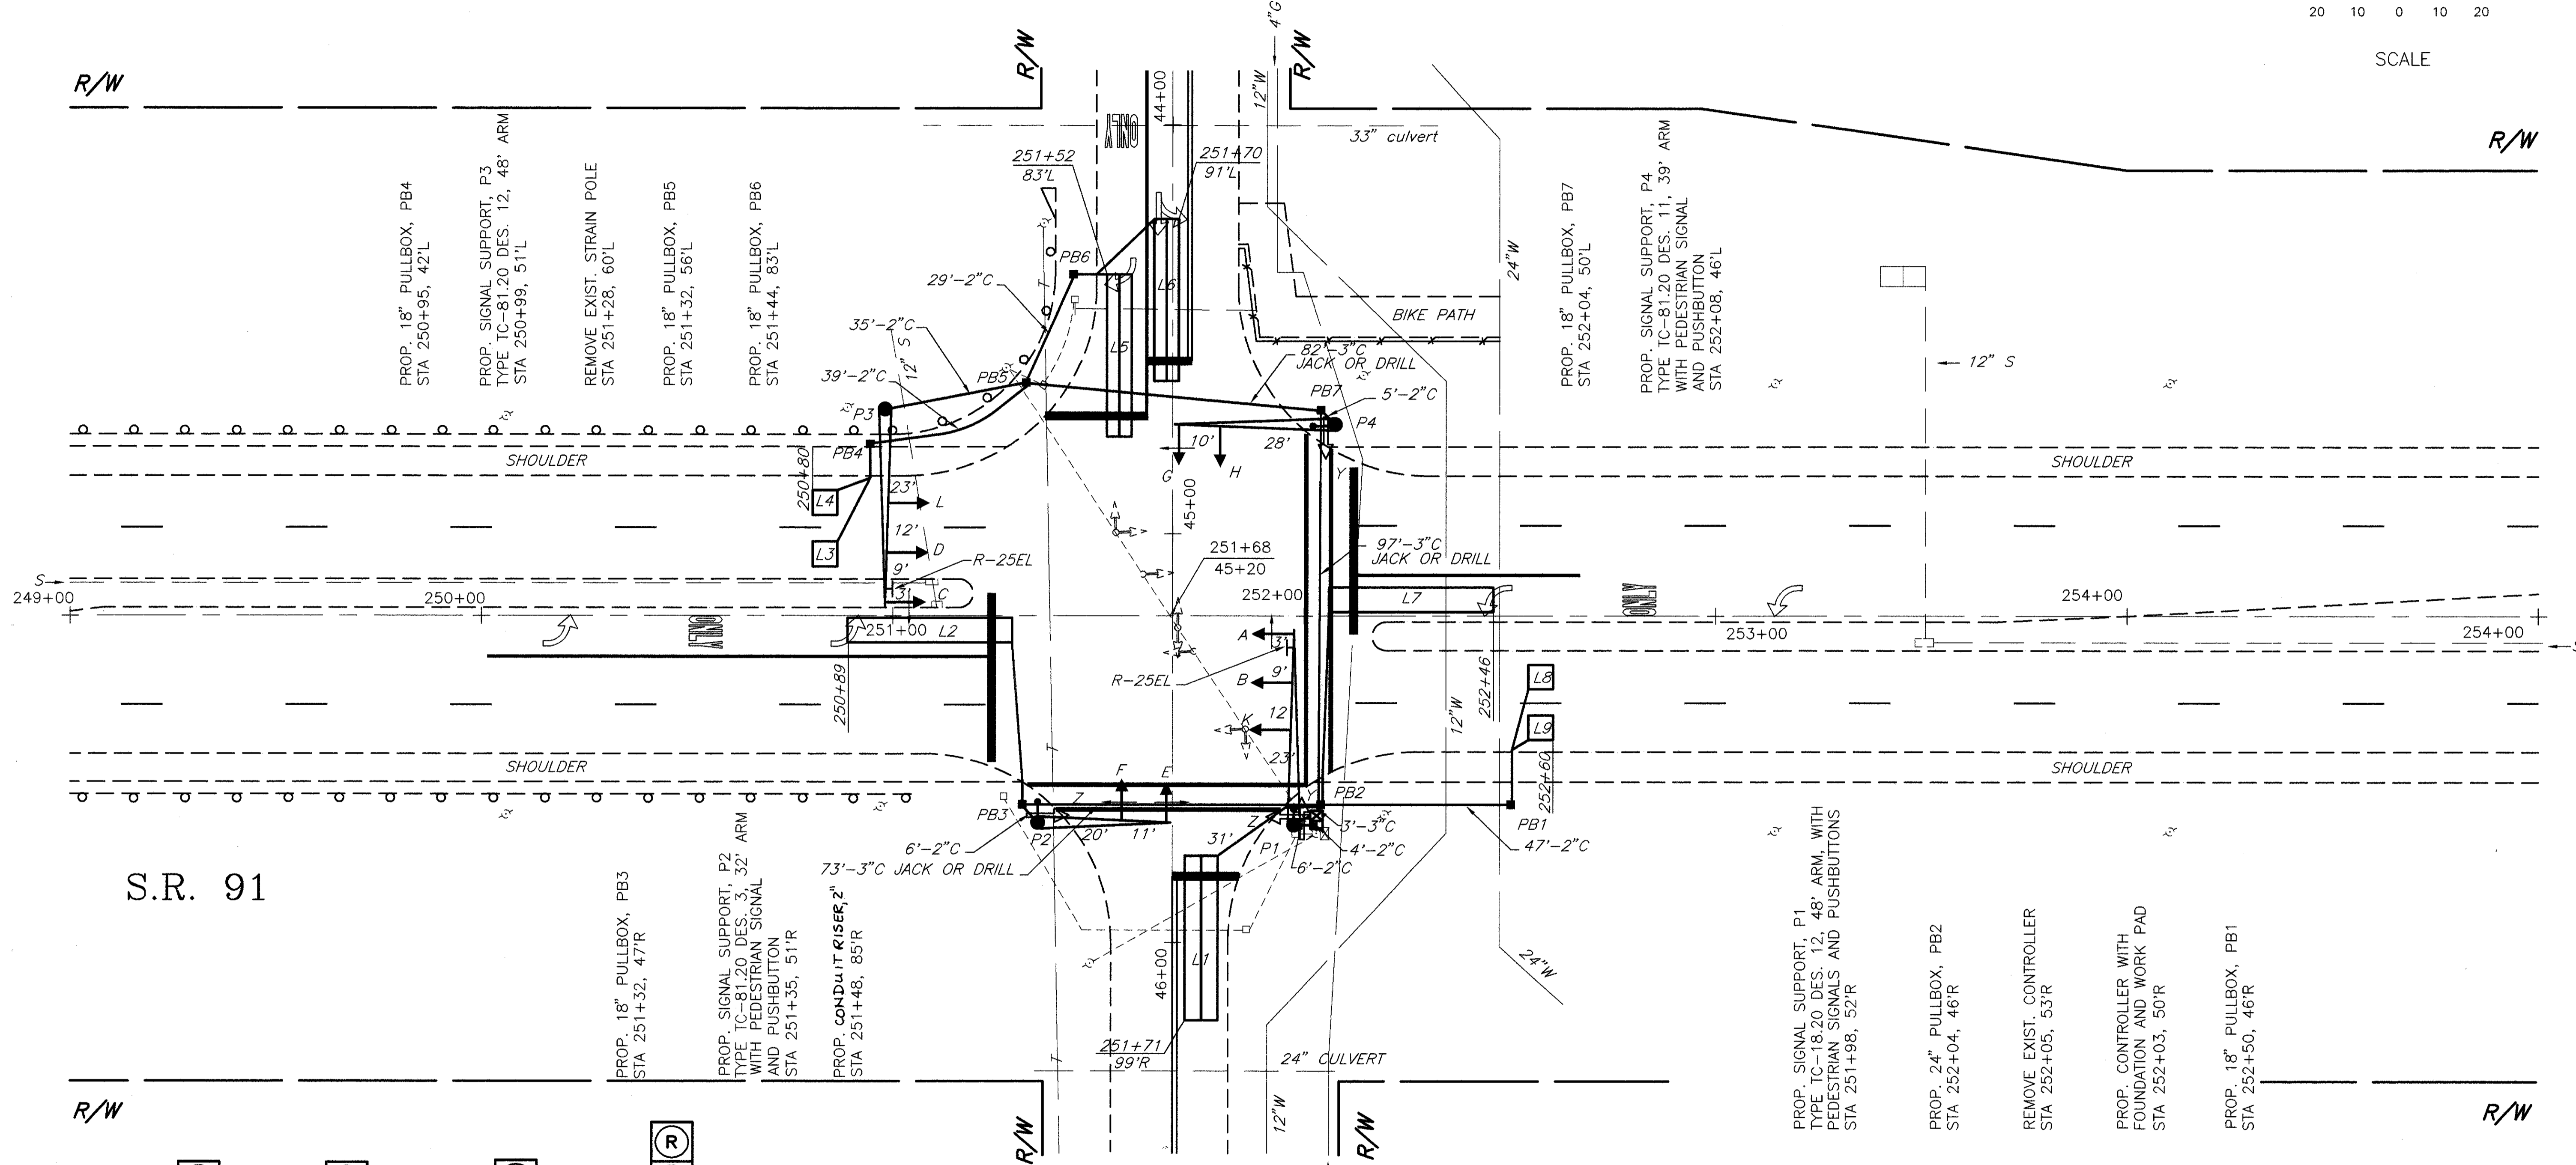


S.R. 91

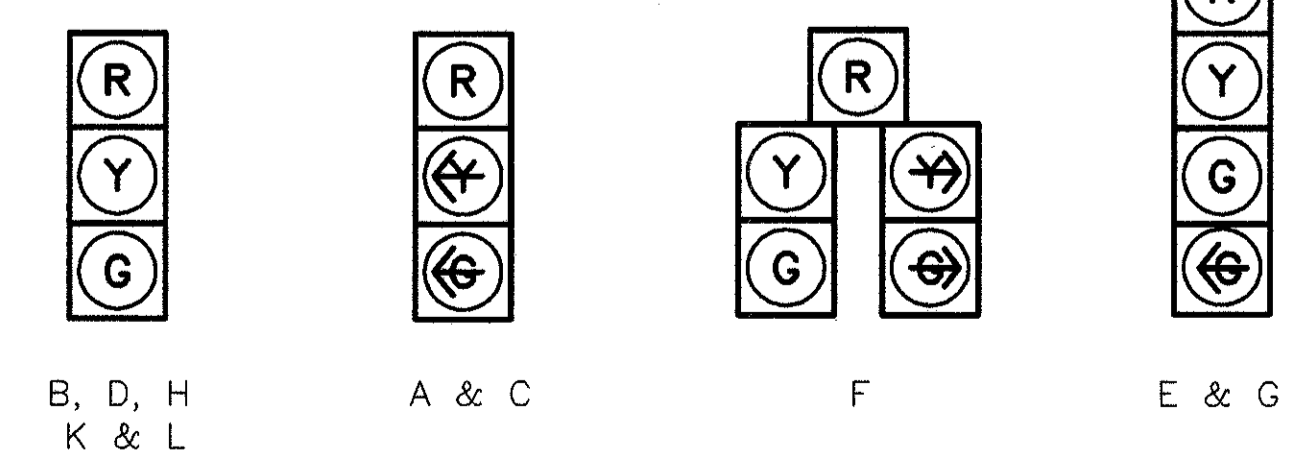

ALL HEADS ARE 12" POLY  
**SIGNALS**

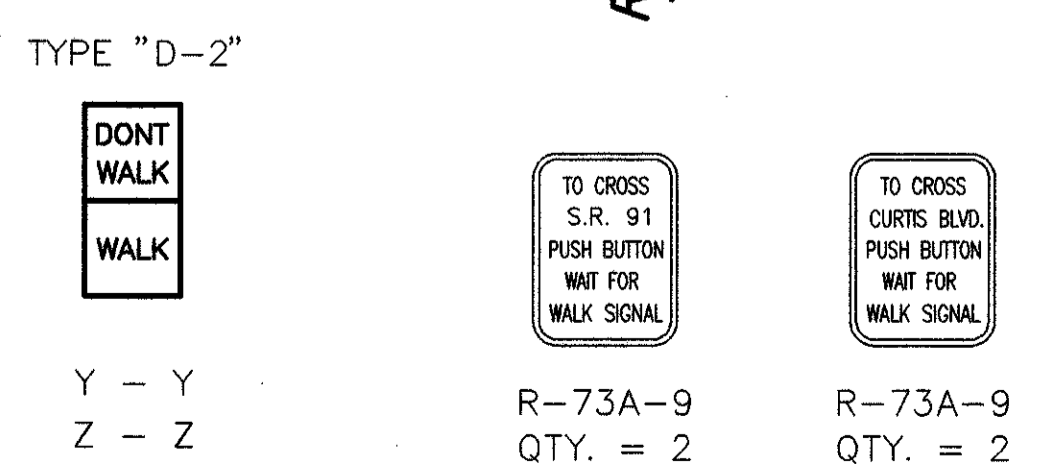

**PED SIGNS**

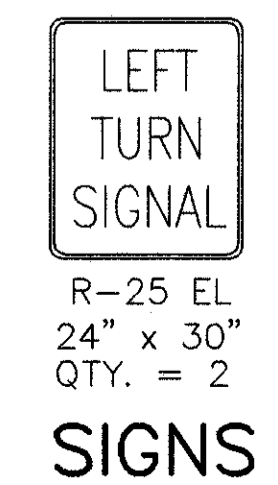

**SIGNALS**

PROP. SIGNAL SUPPORT, P1  
TYPE TC-18.20 DES. 12, 48' ARM, WITH  
PEDESTRIAN SIGNALS AND PUSHBUTTONS  
STA 251+98, 52R

PROP. 24" PULLBOX, PB2  
STA 252+04, 46R

REMOVE EXIST. CONTROLLER  
STA 252+05, 53R

PROP. CONTROLLER WITH  
FOUNDATION AND WORK PAD  
STA 252+03, 50R

PROP. 18" PULLBOX, PB1  
STA 252+50, 46R

THE UNDERGROUND UTILITIES ARE SHOWN ACCORDING  
TO INFORMATION FURNISHED BY THE UTILITIES CONCERNED.  
THEIR ACCURACY IS NOT GUARANTEED, THEREFORE THEY  
SHOULD BE RECHECKED BEFORE UNDERGROUND  
CONSTRUCTION BEGINS.