CALC. BY: DATE:	LAKE COUNTY LAK-91-4.56	OHIO
CHKD. BY: DATE:		FHWA REGION 5
		FEDERAL PROJECT

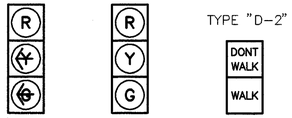

A & C

B, D, E, F, F, G, H, K & L

W – W
X – X
Y – Y
Z – Z

ALL HEADS ARE 12" POLY

SIGNALS

R-73A-9 QTY. = 4

R-73A-9 QTY. = 4

PED SIGNS

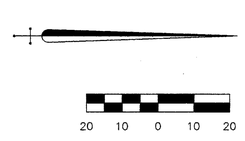

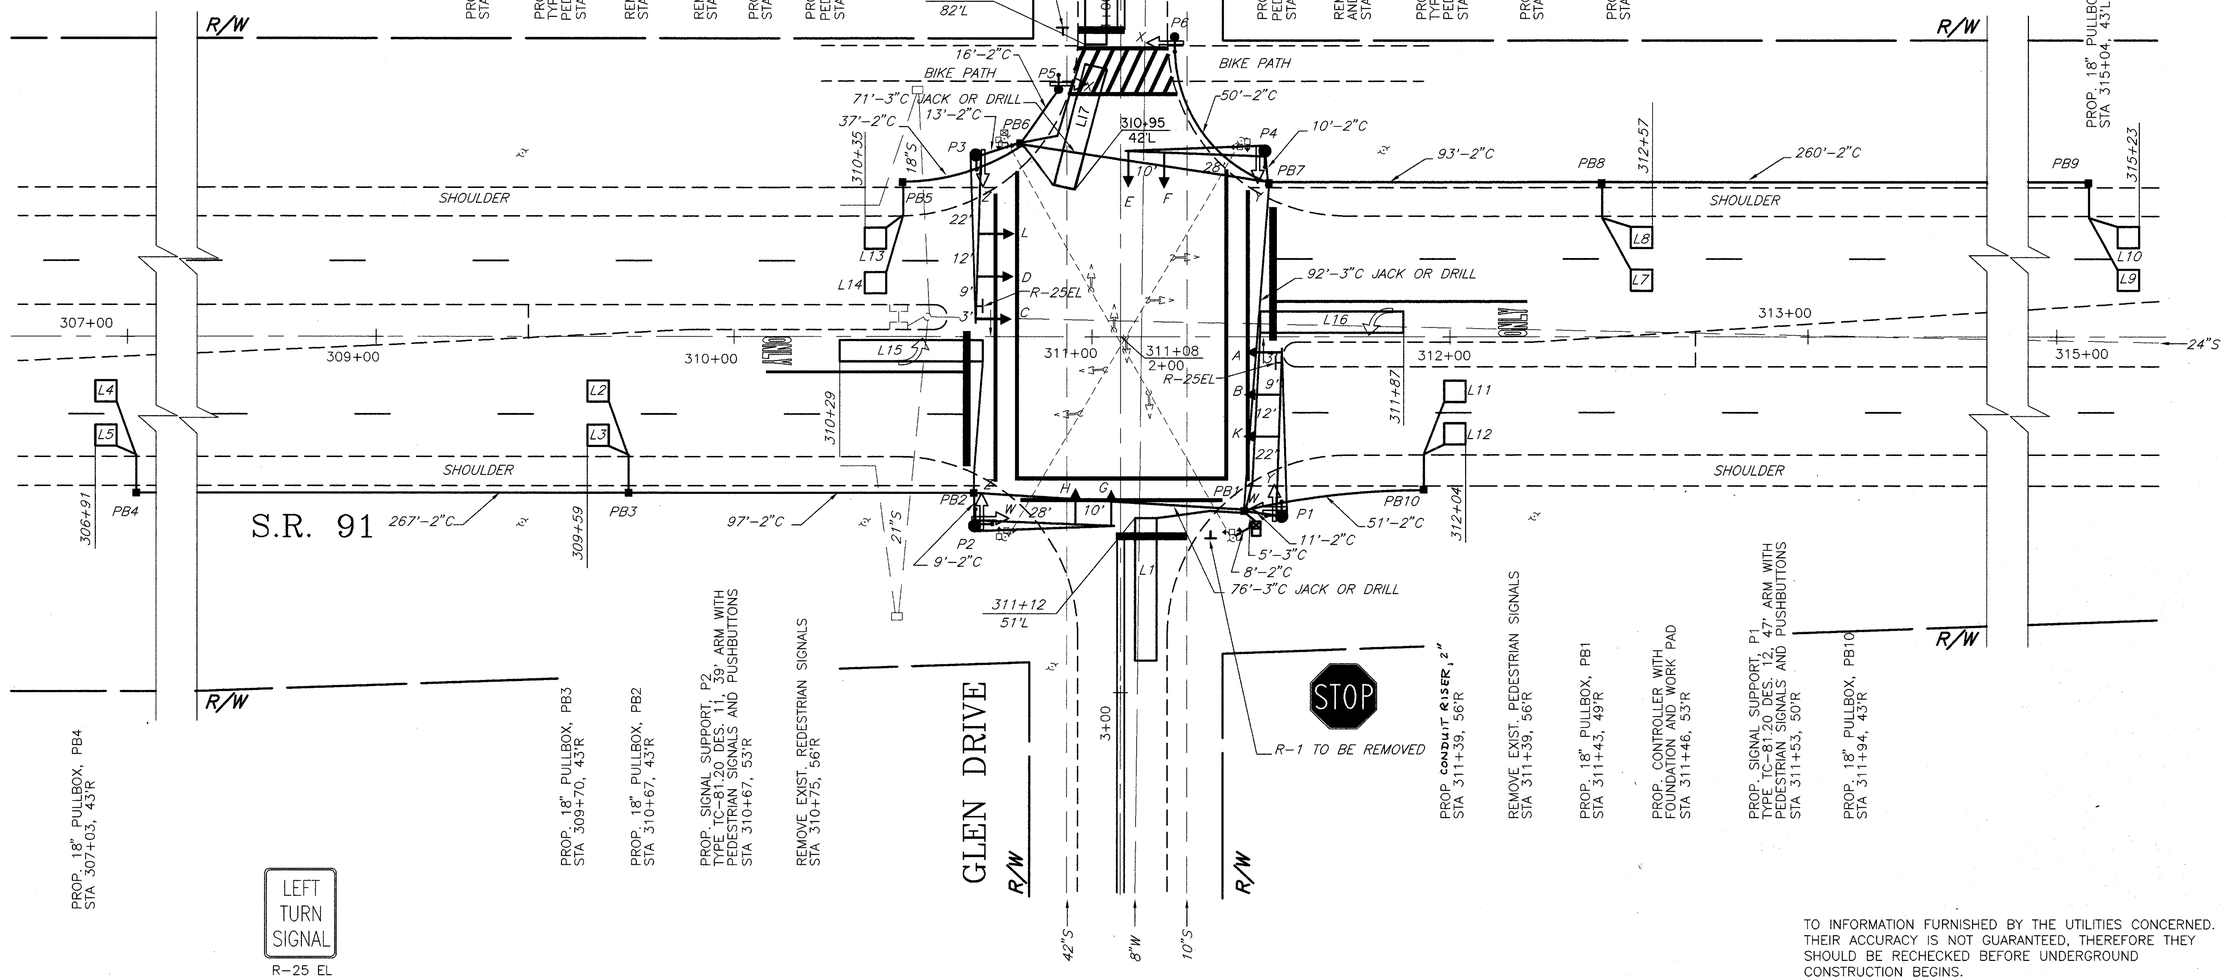

R-25 EL
24" x 30"
QTY. = 2

SIGNS

TO INFORMATION FURNISHED BY THE UTILITIES CONCERNED. THEIR ACCURACY IS NOT GUARANTEED, THEREFORE THEY SHOULD BE RECHECKED BEFORE UNDERGROUND CONSTRUCTION BEGINS.

REVISED 4-26-94

S.R. 91 & GLEN DRIVE TRAFFIC CONTROL PLAN