




SCALE

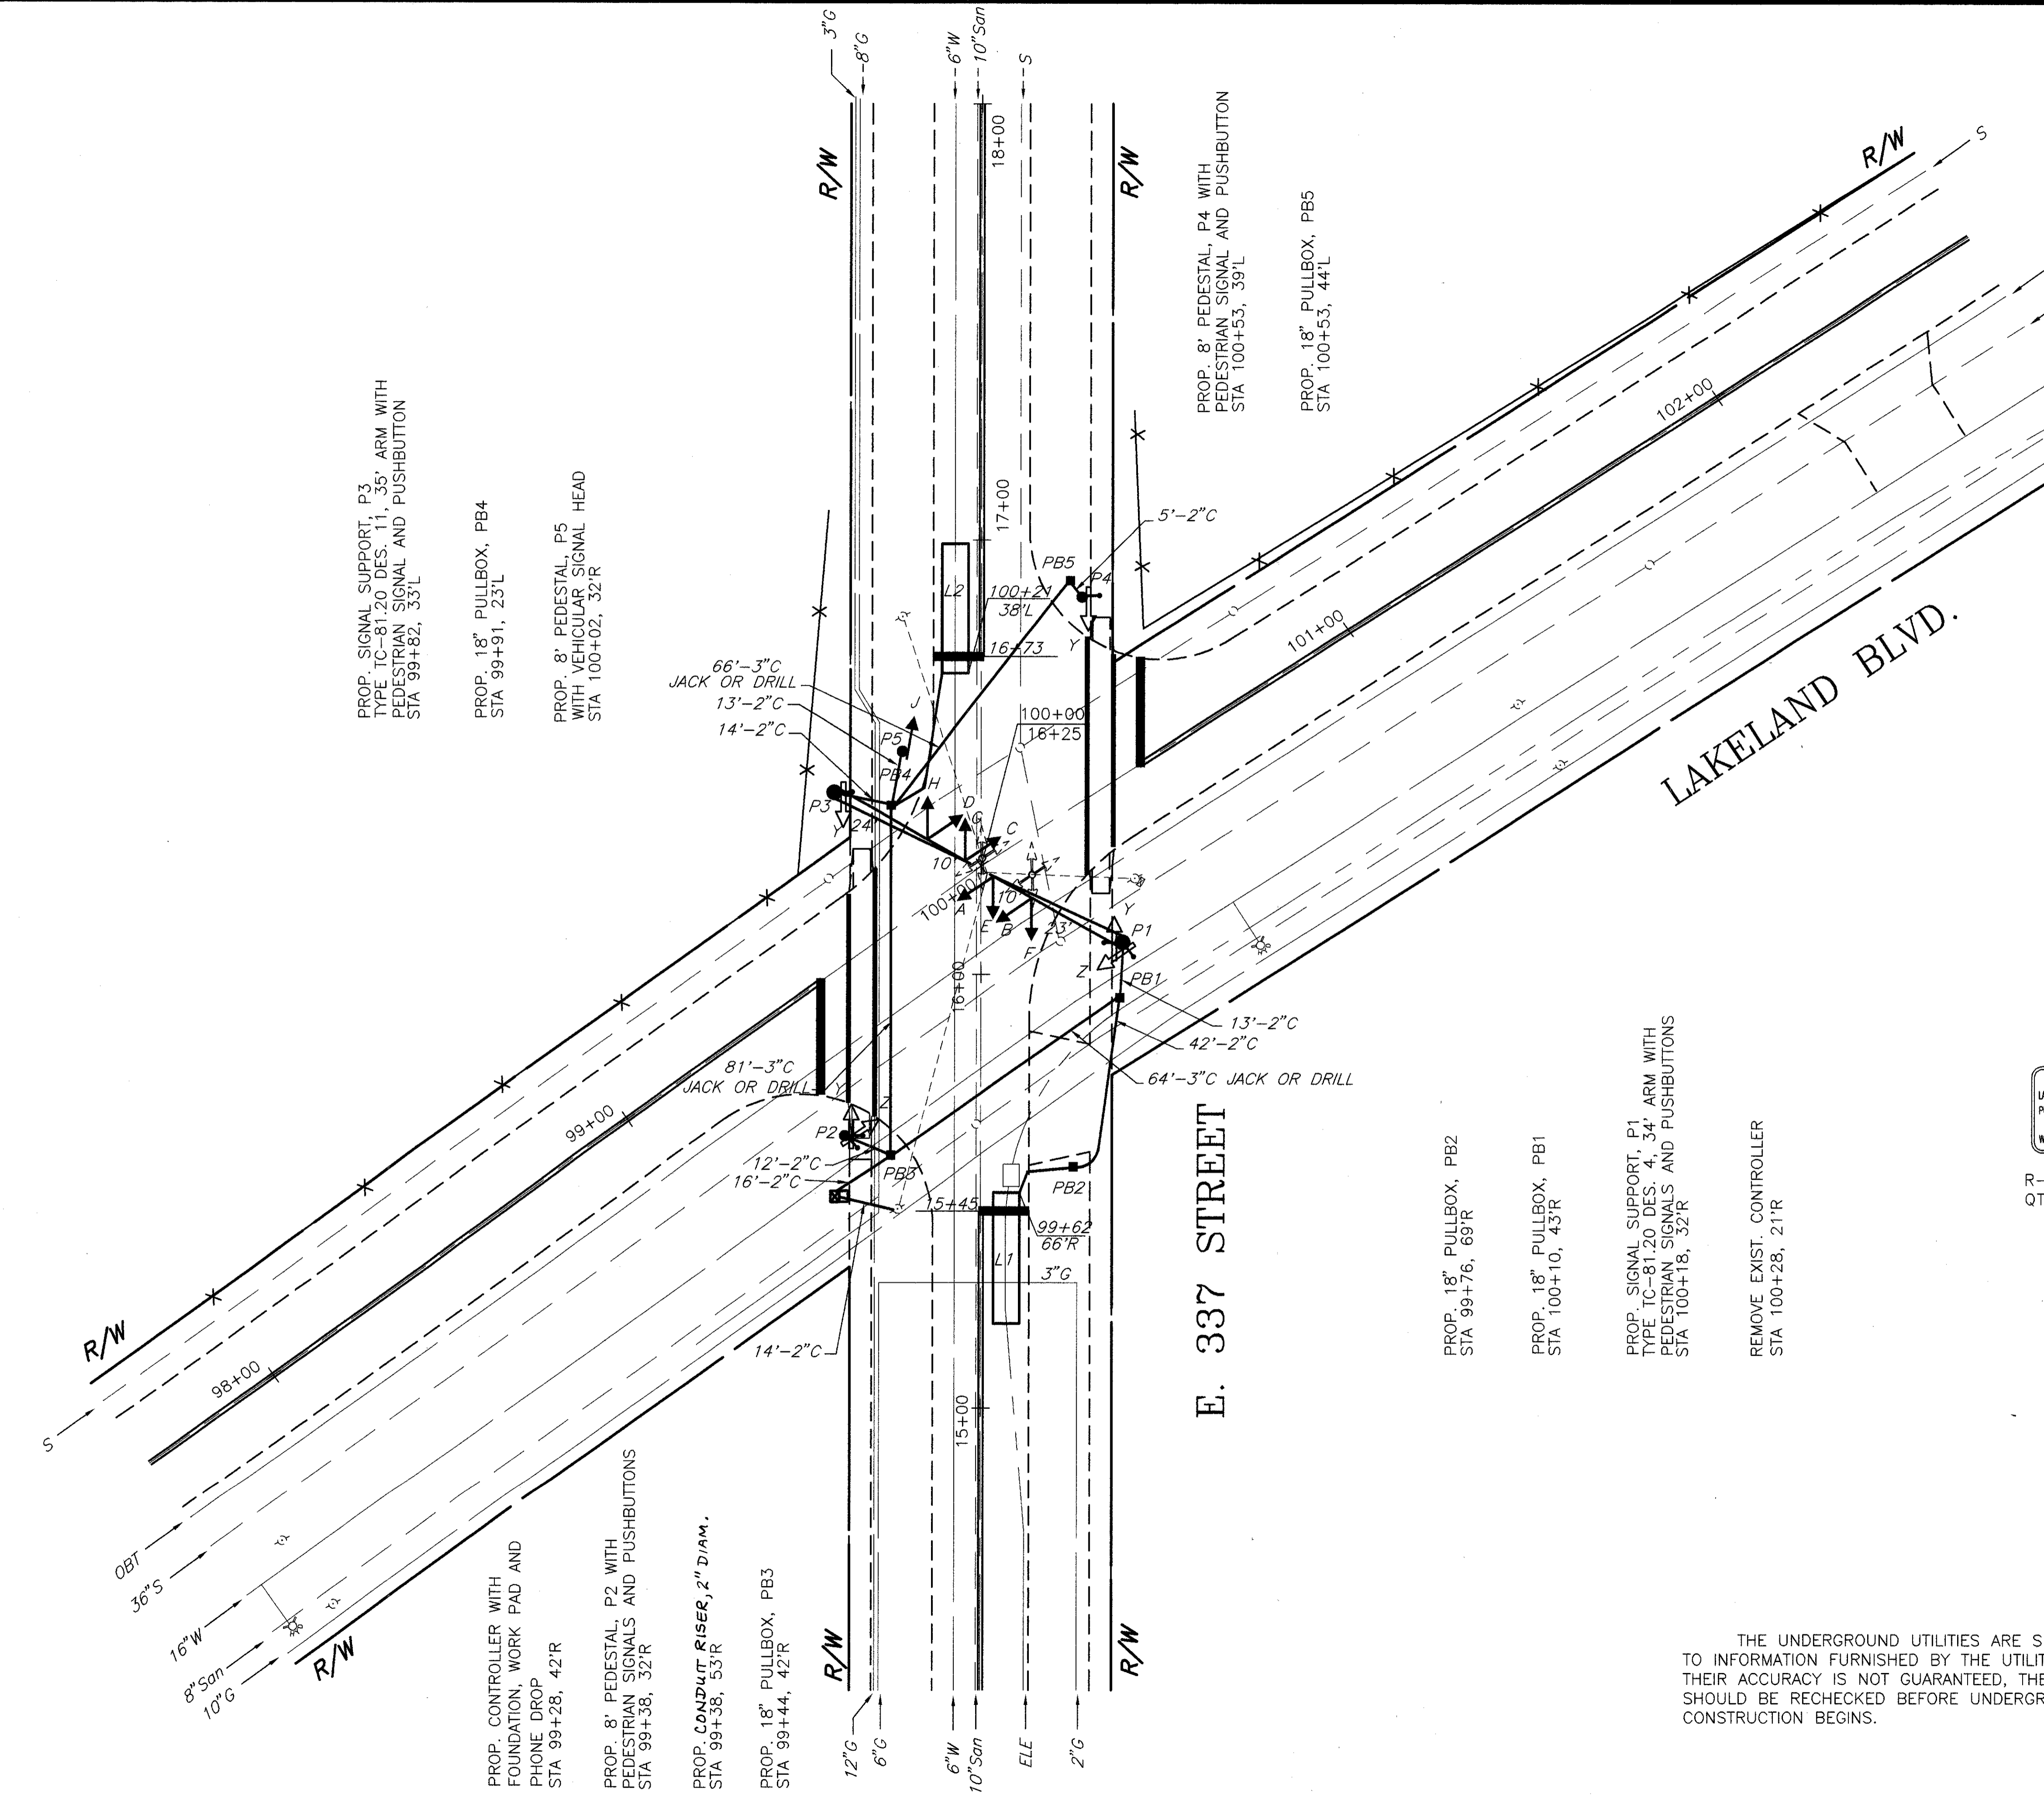

PROP. SIGNAL SUPPORT, P3  
TYPE TC-81.20 DES. 11, 35' ARM WITH  
PEDESTRIAN SIGNAL AND PUSHBUTTON  
STA 99+82, 33'L

PROP. 18" PULLBOX, PB4  
STA 99+91, 23'L

PROP. 8' PEDESTAL, P5  
WITH VEHICULAR SIGNAL HEAD  
STA 100+02, 32'R

PROP. 8' PEDESTAL, P4 WITH  
PEDESTRIAN SIGNAL AND PUSHBUTTON  
STA 100+53, 39'L

PROP. 18" PULLBOX, PB5  
STA 100+53, 44'L

66'-3"C  
JACK OR DRILL  
13'-2"C  
14'-2"C

81'-3"C  
JACK OR DRILL

13'-2"C  
42'-2"C  
64'-3"C JACK OR DRILL

PROP. CONTROLLER WITH  
FOUNDATION, WORK PAD AND  
PHONE DROP  
STA 99+28, 42'R

PROP. 8' PEDESTAL, P2 WITH  
PEDESTRIAN SIGNALS AND PUSHBUTTONS  
STA 99+38, 32'R

PROP. CONDUIT RISER, 2" DIAM.  
STA 99+38, 53'R

PROP. 18" PULLBOX, PB3  
STA 99+44, 42'R

PROP. 18" PULLBOX, PB2  
STA 99+76, 69'R

PROP. 18" PULLBOX, PB1  
STA 100+10, 43'R

PROP. SIGNAL SUPPORT, P1  
TYPE TC-81.20 DES. 4, 34' ARM WITH  
PEDESTRIAN SIGNALS AND PUSHBUTTONS  
STA 100+18, 32'R

REMOVE EXIST. CONTROLLER  
STA 100+28, 21'R

THE UNDERGROUND UTILITIES ARE SHOWN ACCORDING  
TO INFORMATION FURNISHED BY THE UTILITIES CONCERNED.  
THEIR ACCURACY IS NOT GUARANTEED, THEREFORE THEY  
SHOULD BE RECHECKED BEFORE UNDERGROUND  
CONSTRUCTION BEGINS.

NOTE:  
ALL SIGNAL HEADS TO HAVE TUNNEL VISORS




R-73A-9  
QTY. = 4



R-73A-9  
QTY. = 2

PED SIGNS

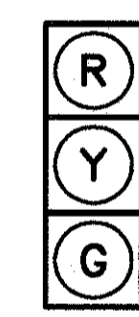

TYPE "D-2"



A, B, C, D, Y - Y  
E, F, G, H & J, Z - Z

ALL HEADS ARE 12" POLY

SIGNALS