

ST. GABRIEL PARISH

SCHOOL ADDITION

MENTOR, OHIO
BISHOP OF CLEVELAND
REV. ROBERT E. PAHLER
MOST REV. JAMES A. HICKEY

INDEX OF DRAWINGS	
A-1	FIRST FLOOR PLAN, E.L. AND C.L. DETAILS
A-2	SECOND FLOOR PLAN, E.L. AND C.L. DETAILS
A-3	ROOF PLAN, E.L. AND C.L. DETAILS
SOIL TEST BORING DATA

	HOLE 1	HOLE 2	HOLE 3	HOLE 4	HOLE 5	HOLE 6	HOLE 7
640							
641							
642							

NOTE
NEW FIRST FLOOR
E.L. = 100.0' EQUIVALENT
EXISTING 696.0' ±

TOPOGRAPHICAL SURVEY TAVERN MARCH 6, 1980
N. CASINI

NOTE
STAIRS TO BE LOCATED FOR
SOIL DATA (DITCHED
TRENCH)

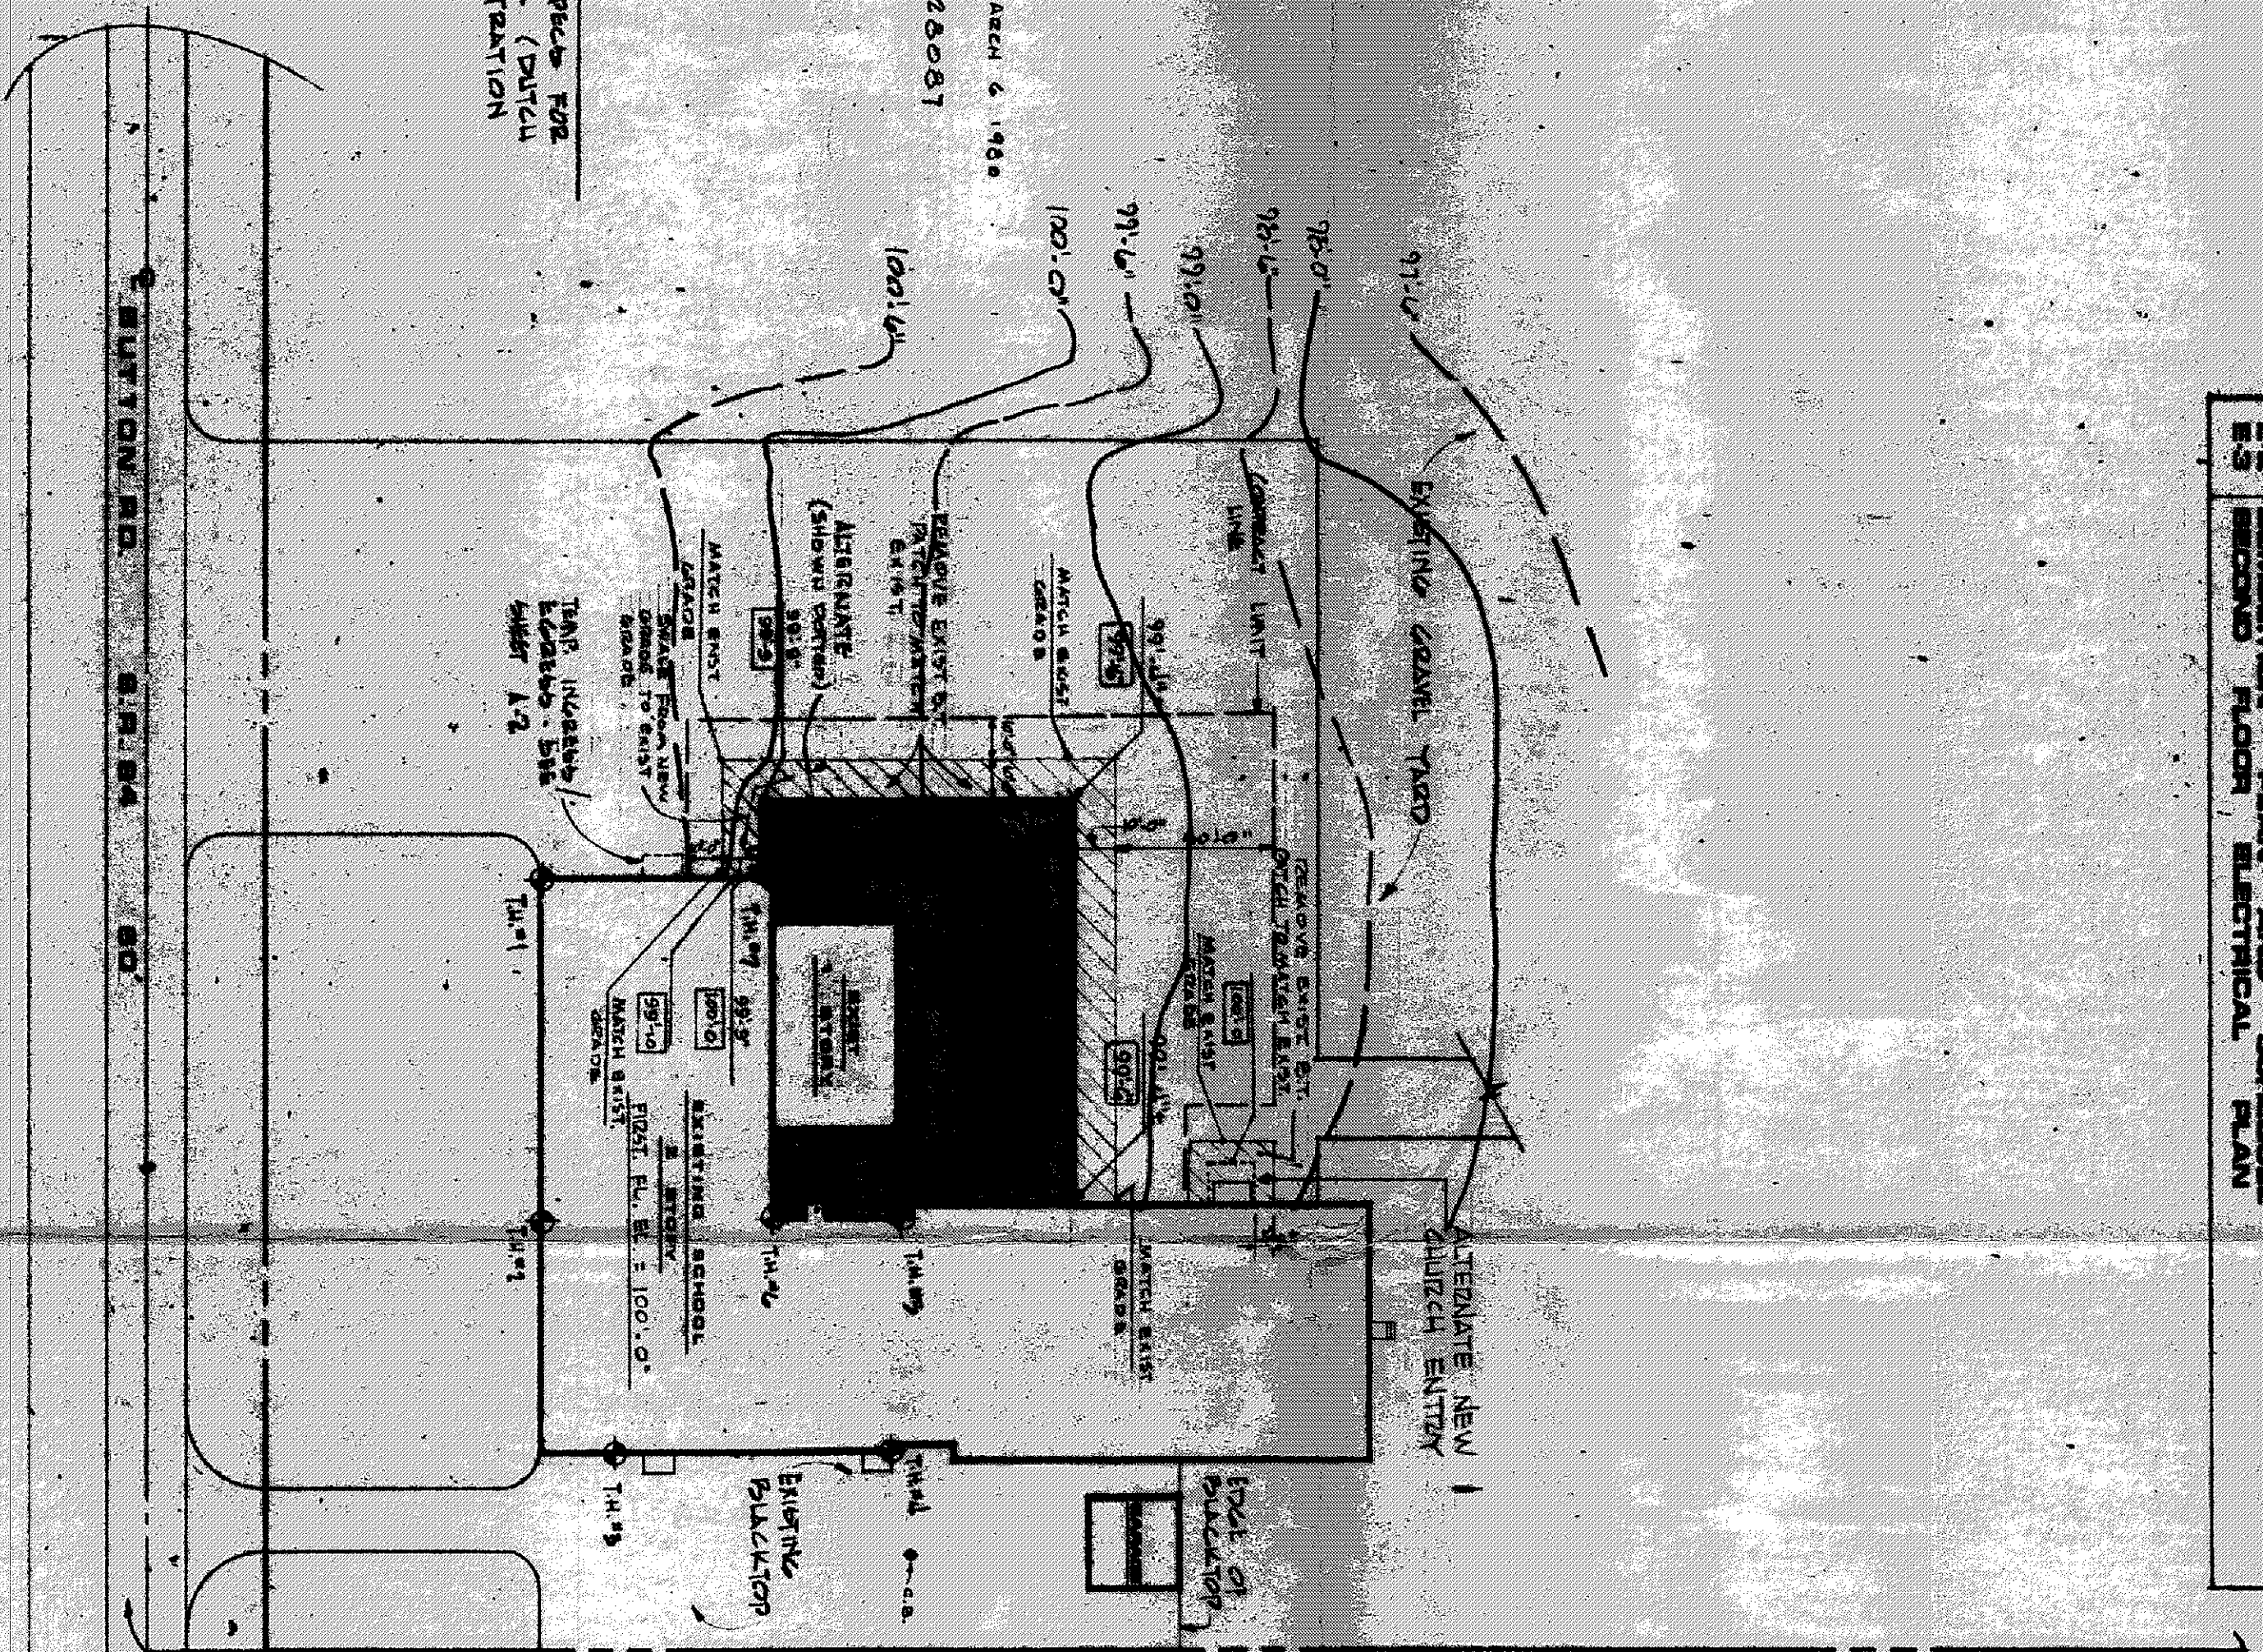

PLOT PLAN

SCALE: 1" = 40'

Grading Plan Approved
as shown and/or noted by
THOMAS P. GILLES, P.E.
City Engineer
Date 7/2/80