

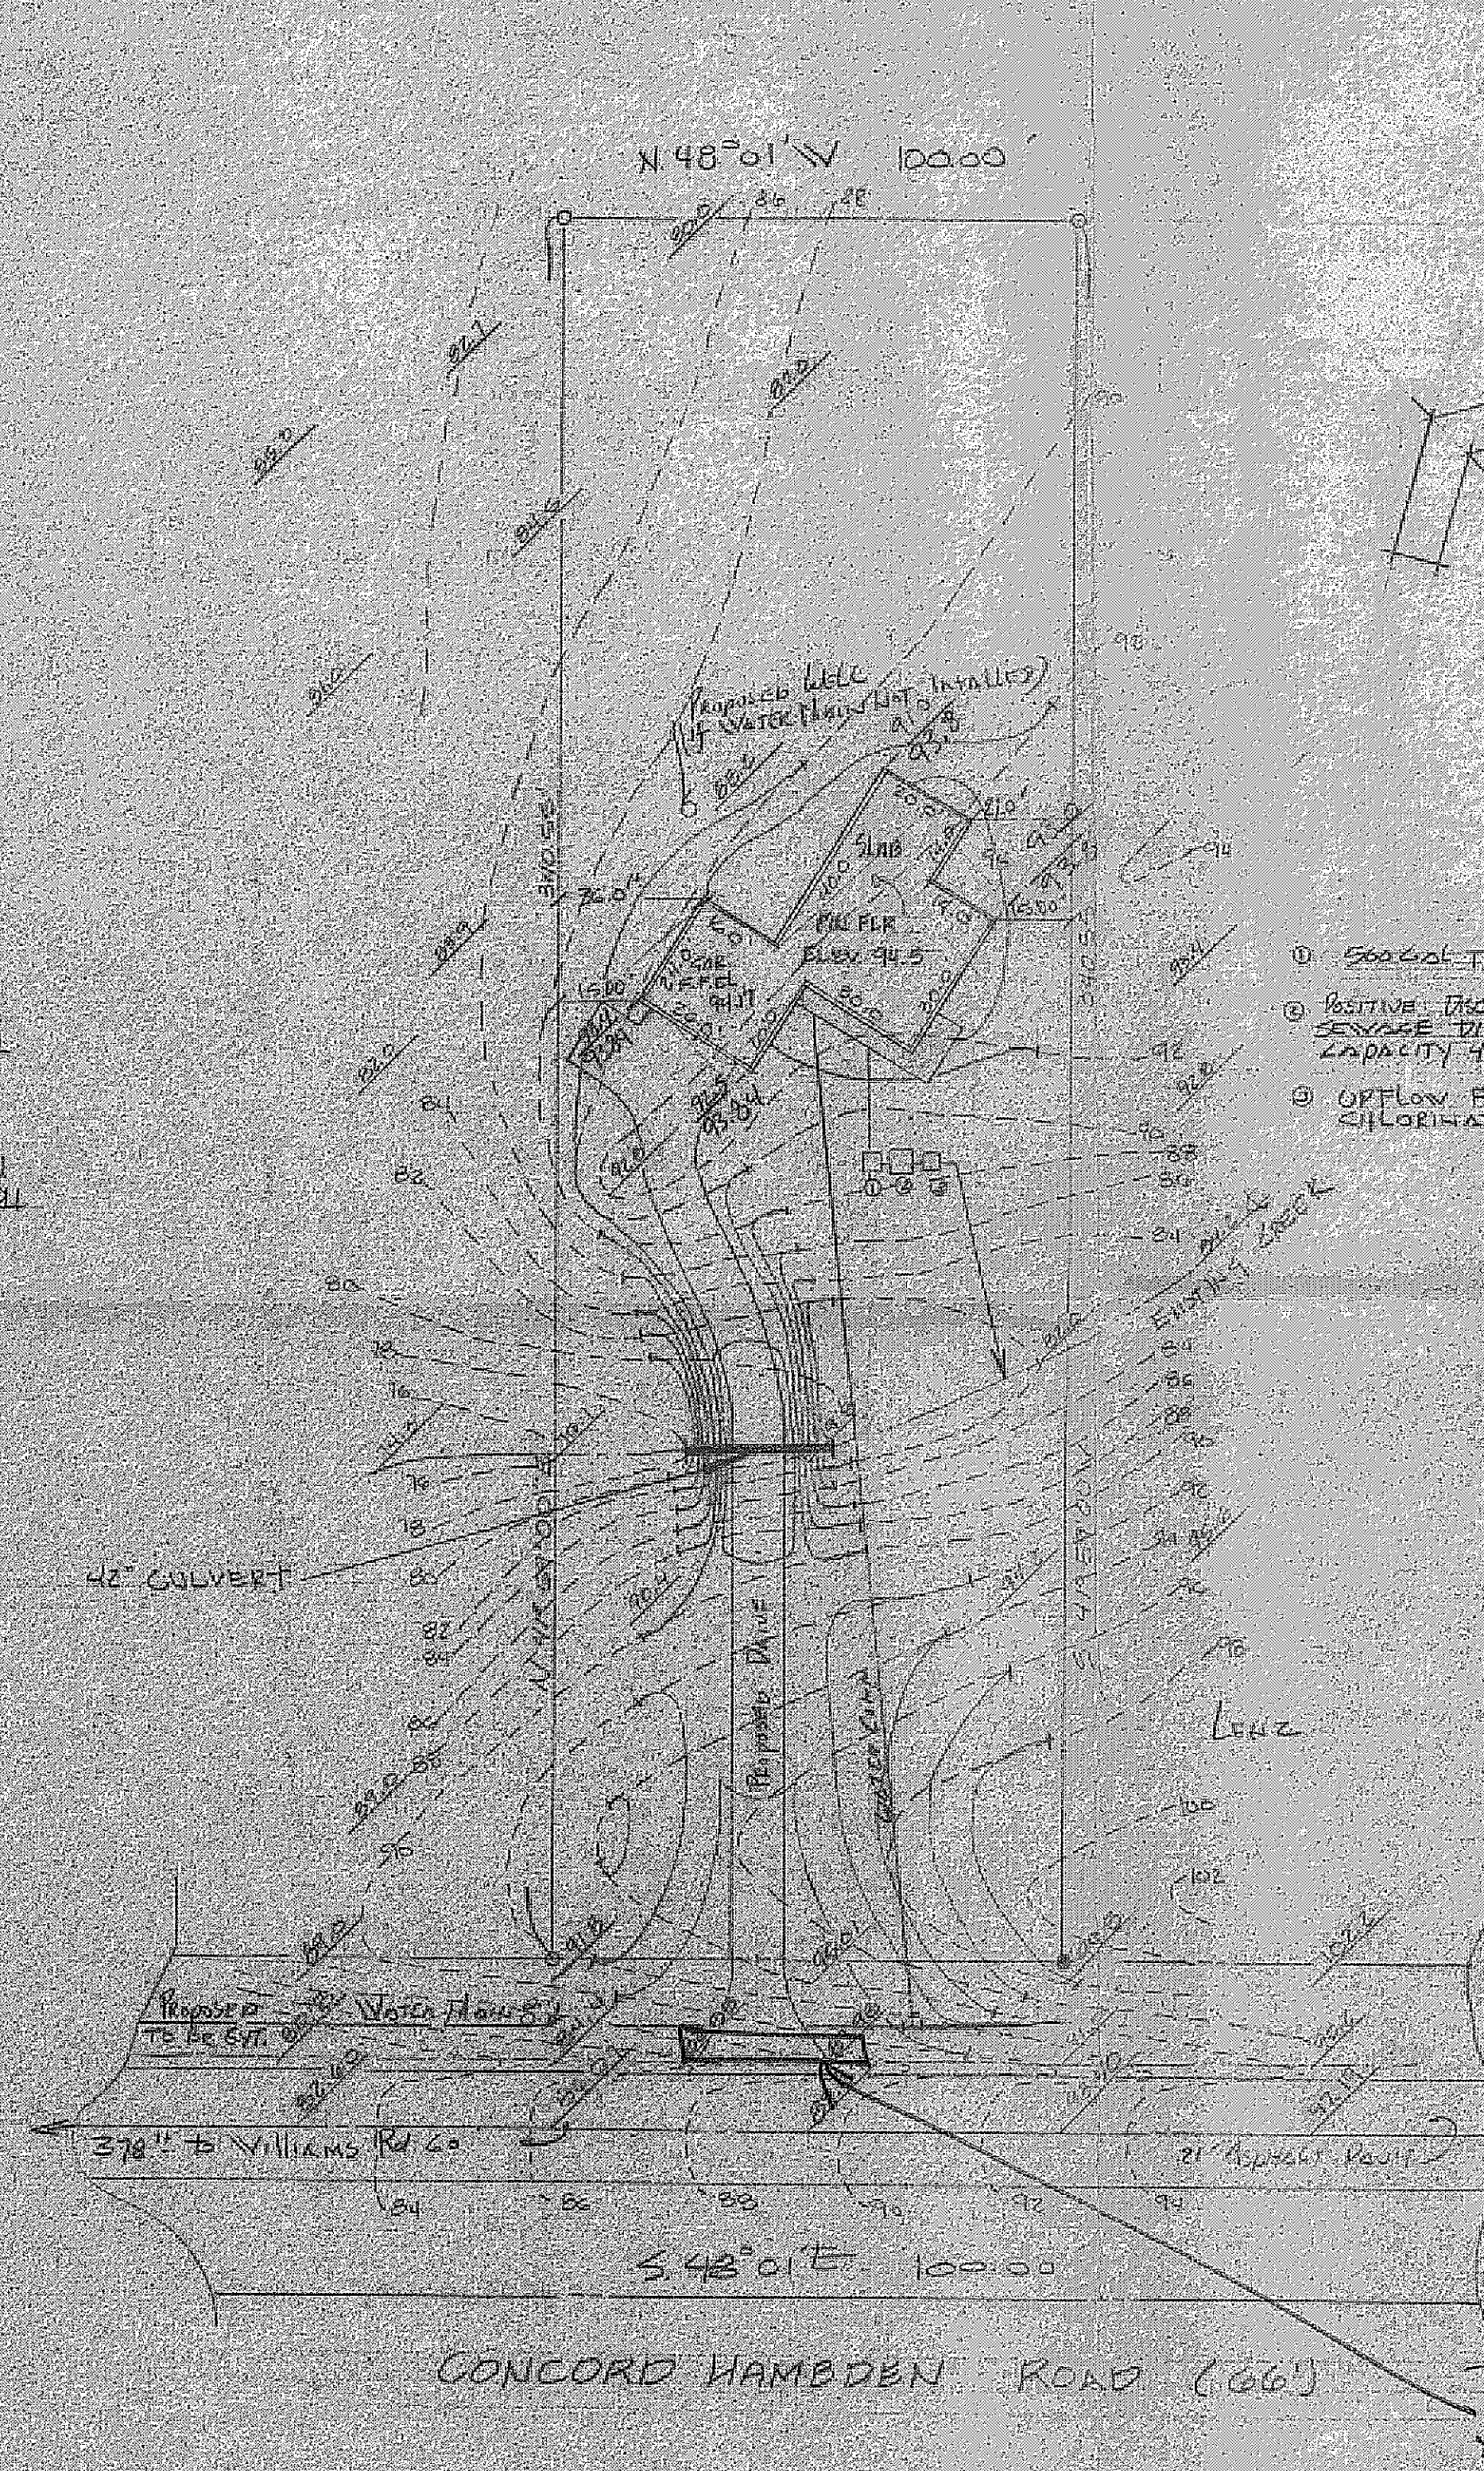


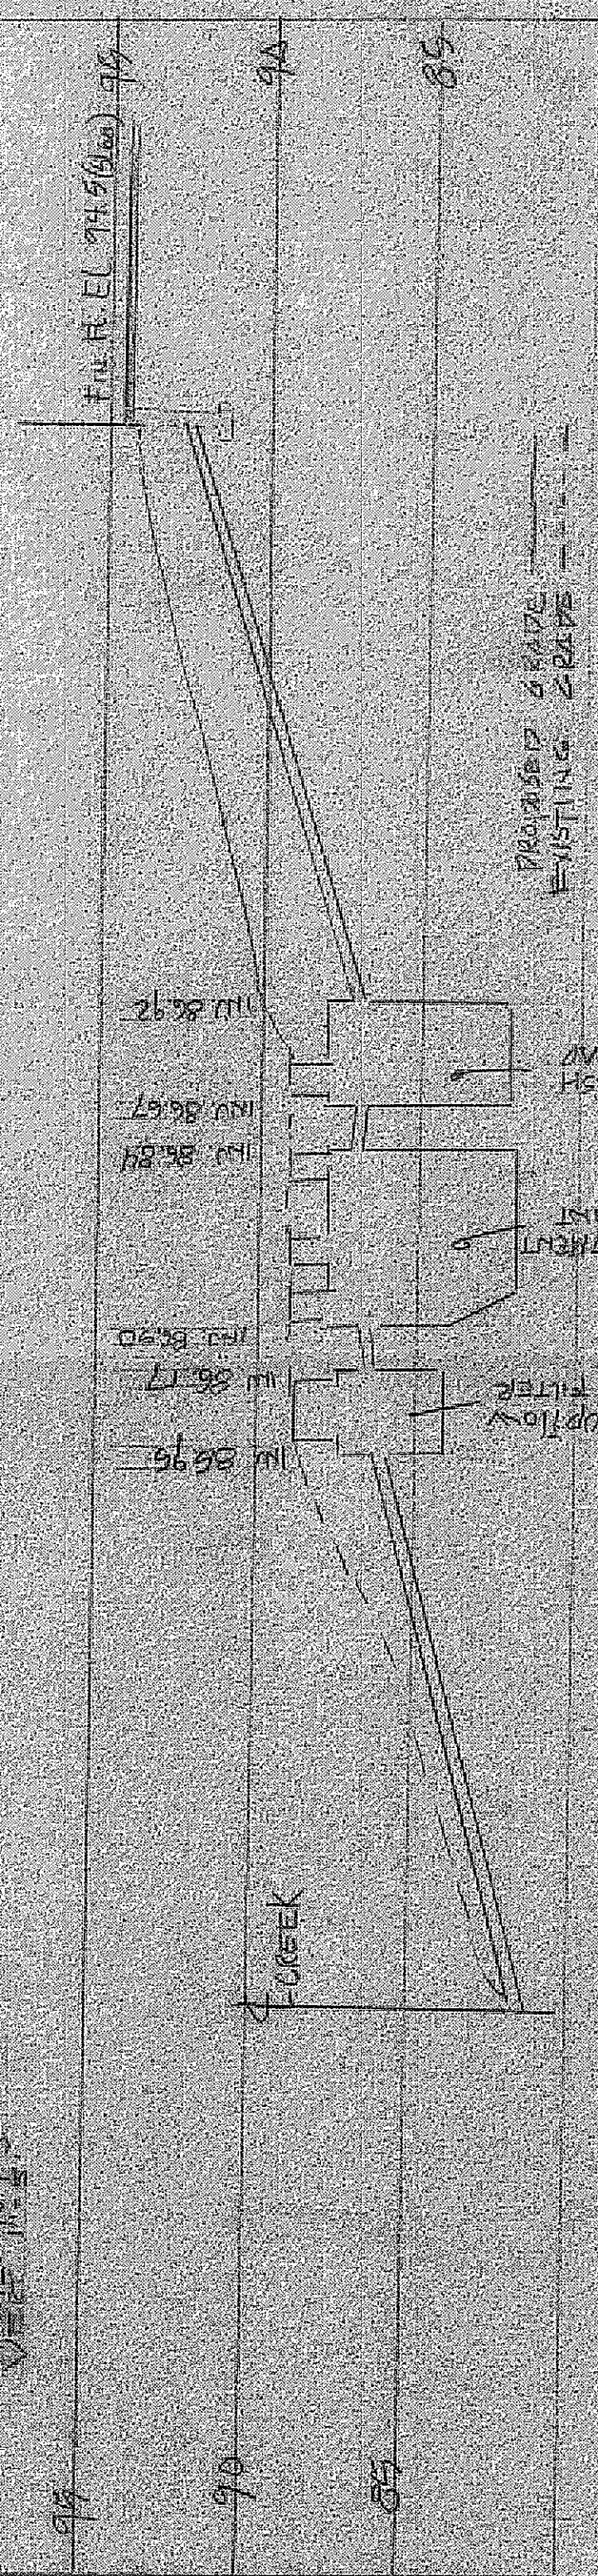

Grading Plan Approved
as shown and/or noted
THOMAS P. GILLES, P.E.
Lake County Engineer
By Date 4-9-79

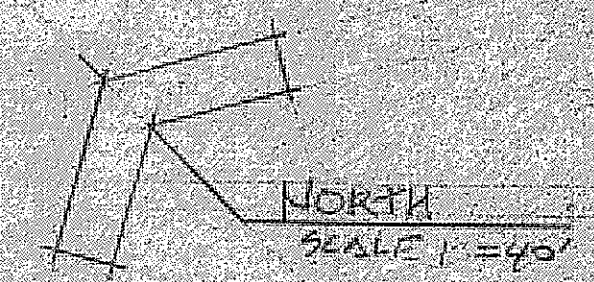

- SITE PLAN -

CONCORD TWP (LAKE COUNTY, OH)
FOR: DAVID LEHTONEN
10922 JOHN CARR RIDGE PARK DR

LEGEND

EXISTING CONTOURS -----
PROPOSED CONTOURS -----
DITCH ----- STREAM -----

- DESIGN CERTIFICATION -

THIS PLAN WAS PREPARED BY ME AND
IS CORRECT TO THE BEST OF MY
KNOWLEDGE AND BELIEF.
William C. Babcock P.E. 652

PLAN PREPARED BY

BABCOCK JONES ASSOC INC.
CIVIL ENGINEERS AND SURVEYORS
270 MAIN ST. #20 PAINT, OHIO 43071-1811

SCALE: 1" = 40' DATE: 4-6-79

ZONING PERMIT

ISSUED 4-9-79
SUBJECT TO APPROVAL BY:
Lake County Sanitary Eng. ☐
Lake County Eng. Dept. ☒
Lake County Planning Comm. ☐
Lake County Bldg. Dept. ☒

CONCORD HAMBDEN ROAD (66)

12" x 20' min culvert to be
installed at existing grade of ditch.