


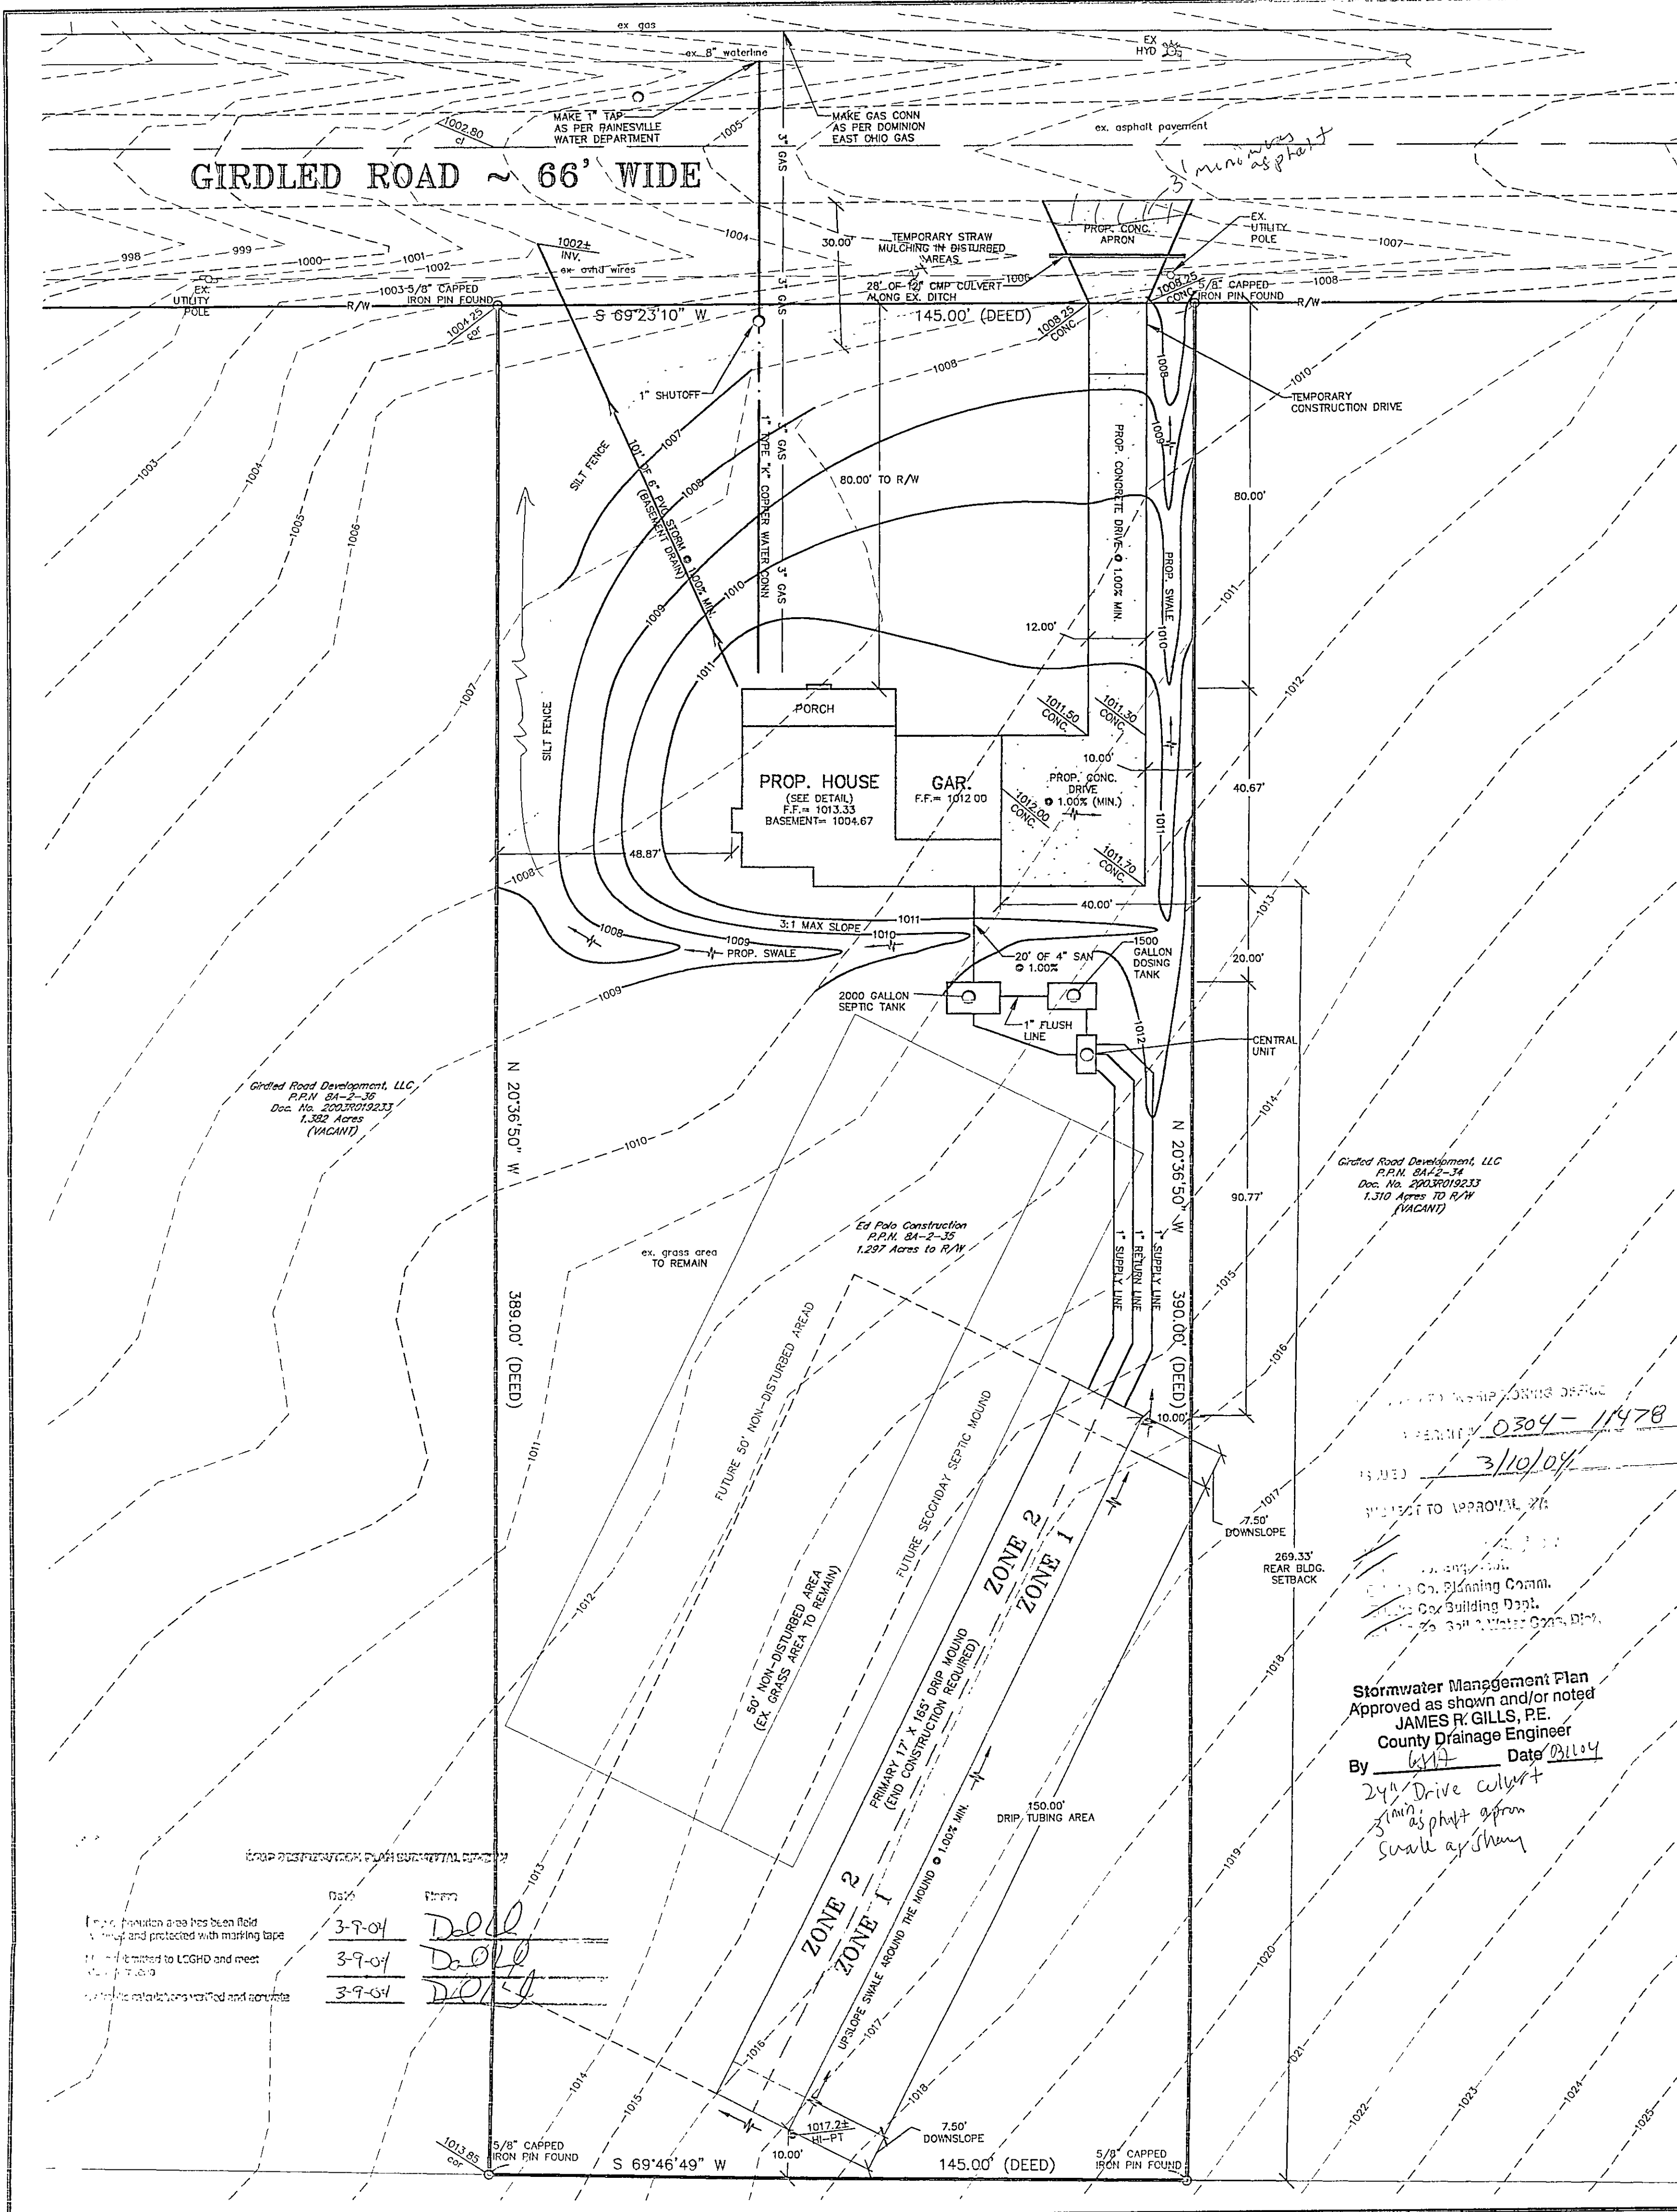

PAINESVILLE WATER DEPT. (PWD) GENERAL NOTES:


1. ALL BENDS, TEES, AND REDUCERS TO BE MEGA-LUG RESTRAINED.
2. HYDRANTS TO BE MUELLER CENTURION 5-1/4", DARLING, OR EQUAL. HYDRANTS TO BE PLUGGED.
3. INSTALLATION AND PRESSURE TESTING SHALL BE PER PWD SPECIFICATIONS.
4. ALL WATERMAINS SHALL BE D.I.P. CLASS 52 AND SHALL CONFORM TO AWWA C150. TAR AND WRAP ALL FITTINGS.
5. DISINFECTION AND/OR CHLORINATION SHALL BE AS PER AWWA C651.
6. FEES AND APPLICATION FOR FIRE LINE INSTALLATION AND INSPECTION DEPOSIT OF \$175.00 PER DAY SHALL BE PLACED WITH THIS OFFICE 72 HOURS PRIOR TO SCHEDULING CONSTRUCTION.
7. LINE VALVES TO BE "RIGHT TO OPEN VALVES".
8. CONTRACTOR IS RESPONSIBLE FOR ALL INSPECTION COSTS. INSPECTION COSTS TO BE PAID TO PWD AT THE CURRENT HOURLY RATE.
9. ZINC ANODE CAPS ARE TO BE USED ON ALL MECHANICAL JOINT BOLTS.
10. CURB STOPS SHALL HAVE COPPER INLETS AND OUTLETS AND SHALL BE HAYS 4304, FORD 822, OR EQUAL.
11. SERVICE BOXES SHALL BE BUFFALO PATTERN WITH 2 1/2" SHAFTS. THE BOXES SHALL BE ADJUSTABLE IN HEIGHT FROM 42" TO 60" AND SHALL HAVE THE WORD "WATER" CAST NEATLY AND LEGIBLY ON THE LID WHICH SHALL BE HELD IN PLACE BY A BRONZE OR BRASS STANDARD BOLT. CURB BOXES SHALL BE STANDARD WEIGHT, SIZE 94E, AND SHALL BE MUELLER 4-10350, TYEAR PIPE INDUSTRIES 6500 OR EQUAL.
12. ALL M.J. FITTINGS TO BE "CL. 110".
13. WATER METER TO BE INSTALLED INSIDE PER P.W.D. SPEC'S.
14. 1" SERVICE IS TO BE INSTALLED BY CONTRACTOR UNDER CITY INSPECTION.
15. 1" TAP TO BE MADE BY THE CITY WATER DEPT. AT OWNER'S COST.

SOIL & WATER CONSERVATION NOTES

1. INGRESS-EGRESS
A STONE ACCESS DRIVE COMPLETE WITH UNDER LYING GEO-TEXTILE FABRIC (20 FEET WIDE AND 50 FEET LONG) FOR INGRESS AND EGRESS AT THE SITE. SHALL BE INSTALLED. THIS DRIVE SHALL BE THE ONLY ENTRANCE AND EXIT TO THE SITE.
2. SILT FENCE
ALL SILT FENCE SHALL BE INSTALLED PRIOR TO ANY EARTHWORK ACTIVITIES AT THE SITE IN THE LOCATIONS SHOWN ON THE SITE PLAN AS WELL AS ALONG THE FRONT OF ANY LOT THAT SLOPES TOWARDS THE STREET.
3. TEMPORARY SEEDING
DISTURBED AREAS OF THE SITE THAT ARE TO REMAIN IDLE FOR MORE THAN THIRTY (30) DAYS SHALL BE PROPERLY SEEDED AND STRAW MULCHED WITHIN SEVEN (7) DAYS OF COMPLETION OF INITIAL GRADING. TEMPORARY SEEDING AND MULCHING OF A THIRTY (30) FOOT STRIP OF THE ENTIRE FRONT OF THE LOT SHALL BE MAINTAINED ON THE SITE ONCE INITIAL GRADING IS COMPLETE.
4. STABILIZATION OF CRITICAL AREAS WITHIN FIFTY (50) FEET OF ANY STREAM OR WETLAND SHALL BE COMPLETE WITHIN TWO (2) DAYS OF THE DISTURBANCE IF THE SITE IS TO REMAIN INACTIVE FOR LONGER THAN FOURTEEN (14) DAYS.
5. STRAW-MULCH SHALL BE APPLIED AT A RATE OF 1 BALE PER EVERY TEN (10) FEET OF CURB, AT A WIDTH OF THIRTY (30) FEET OF THE ENTIRE LENGTH OF THE LOT. WOOD CHIPS MAY ALSO BE USED BUT MUST BE SPREAD A MINIMUM DEPTH OF FOUR (4) INCHES OVER THE THIRTY-FOOT WIDTH AND MUST BE ACCOMPANIED BY A PROPERLY INSTALLED SILT FENCE.
6. MAINTENANCE
EROSION AND SEDIMENT CONTROLS SHALL BE INSPECTED EVERY (7) SEVEN DAYS OR WITHIN 24 HOURS OF A 0.5" OR GREATER RAINFALL EVENT. NECESSARY REPAIRS SHALL BE MADE AT THIS TIME.

NOTE:
ALL EROSION AND SEDIMENT CONTROL SPECIFICATIONS, APPLICATIONS, AND TIMETABLES ARE BASED ON THE DESCRIPTIONS AND STANDARDS OF THE OHIO DEPARTMENT OF NATURAL RESOURCES "RAINWATER AND LAND DEVELOPMENT MANUAL," AND CAN BE FOUND IN THE LAKE COUNTY EROSION AND SEDIMENT CONTROL RULES AS ADOPTED DECEMBER 21, 1999.

THE SPECIFIED EROSION AND SEDIMENT CONTROL STANDARDS ARE GENERAL GUIDELINES AND SHALL NOT LIMIT THE RIGHT OF THE COUNTY TO IMPOSE, AT ANY TIME, ADDITIONAL, MORE STRINGENT REQUIREMENTS.

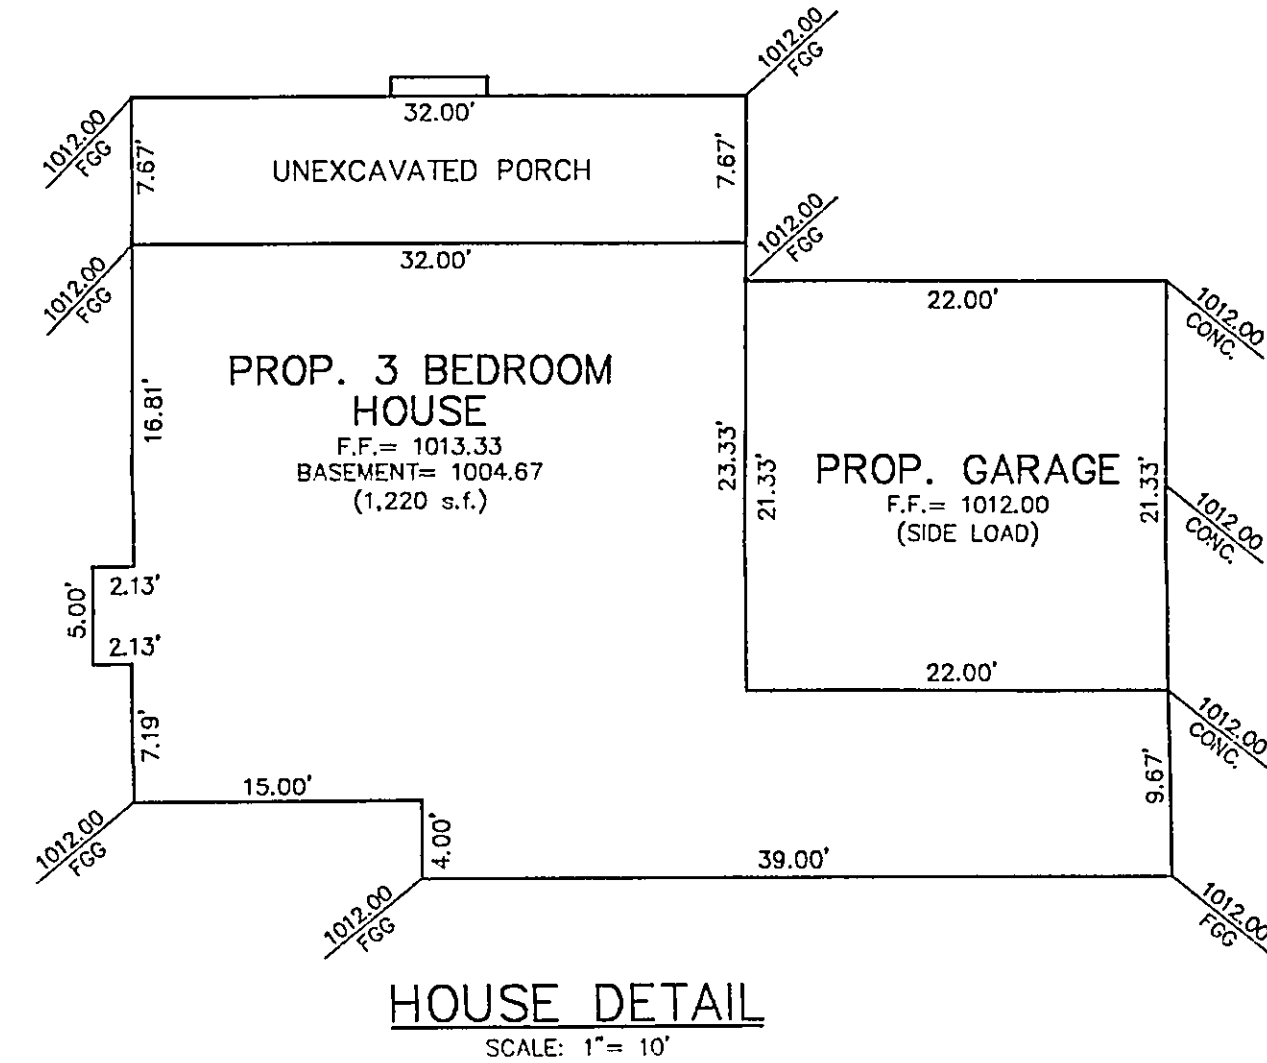

TEMPORARY SEEDING SPECIFICATIONS

SEEDING DATES	SPECIES	LB./1,000 FT.	PER ACRE
MARCH 1 TO AUGUST 15	OATS	3	4 BUSHEL
	TALL FESCUE	1	40 LB.
	ANNUAL RYEGRASS	1	40 LB.
	PERENNIAL RYEGRASS	1	40 LB.
AUGUST 16 TO NOVEMBER 1	RYE	3	2 BUSHEL
	TALL FESCUE	1	40 LB.
	ANNUAL RYEGRASS	1	40 LB.
	WHEAT	3	2 BUSHEL
NOVEMBER 1 TO SPRING SEEDING	TALL FESCUE	1	40 LB.
	ANNUAL RYEGRASS	1	40 LB.
	PERENNIAL RYEGRASS	1	40 LB.
	TALL FESCUE	1	40 LB.



*NOTE: OTHER APPROVED SEED SPECIES MAY BE SUBSTITUTED

CERTIFICATION:

"I, the undersigned, hereby certify that this topography, indicated by 1" 0" contours and elevations shown hereon, represent an actual field survey made by me or by my direct supervision on August 24, 2002 and that the elevations were taken at appropriate intervals and that, as of that date, they existed as indicated hereon.

John Urbanick
Reg. No. E-66506

2/2/04
Date

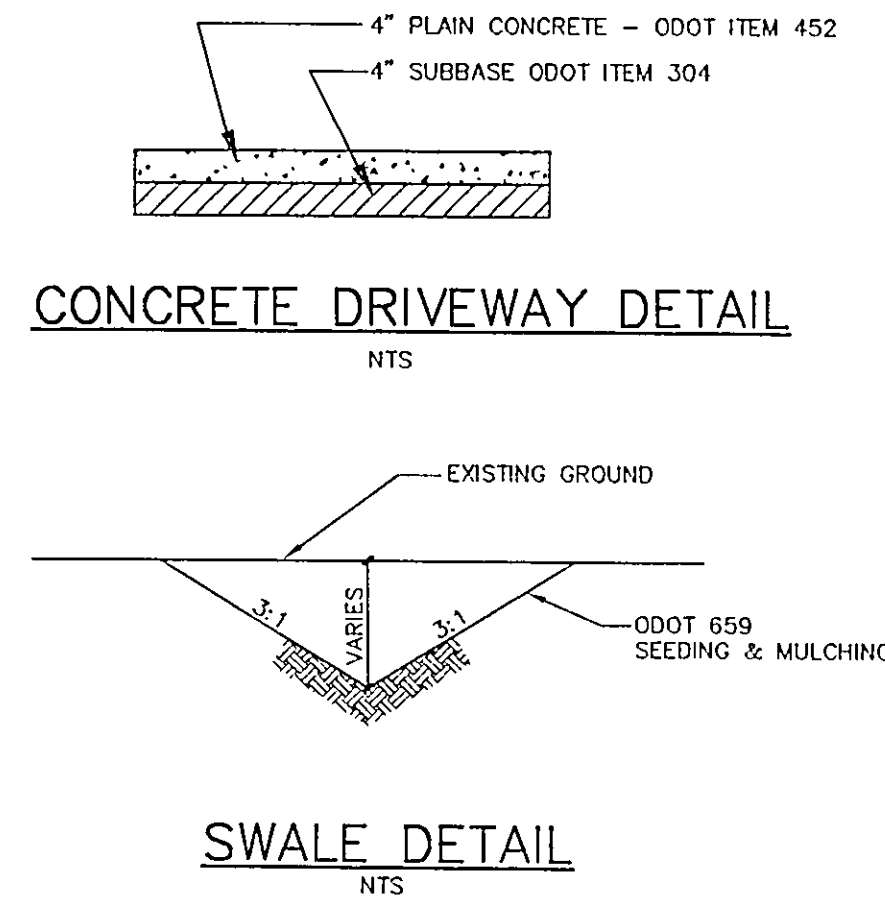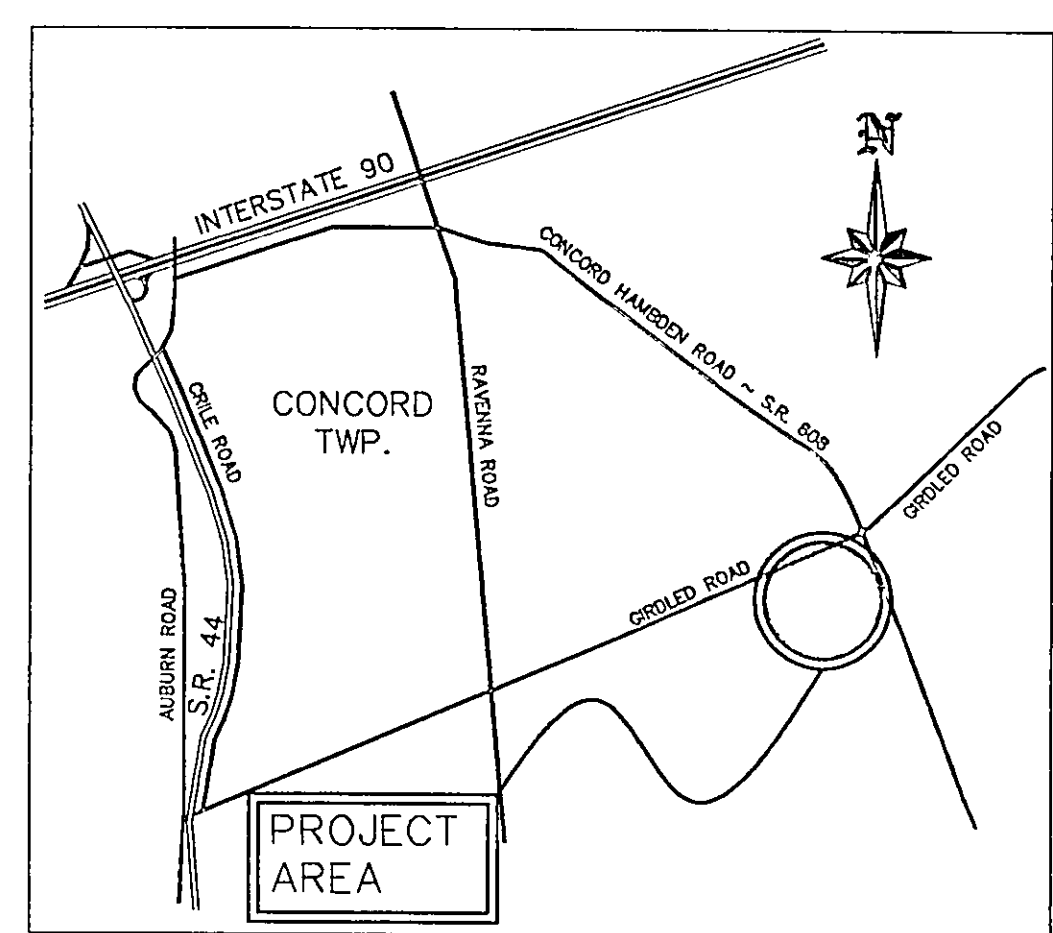

PROJECT NOTES:

1. CONTRACTOR TO FIELD VERIFY LOCATIONS OF ALL UNDERGROUND UTILITIES, INCLUDING ALL UNDERGROUND ELECTRICAL LINES.
2. SEE HOUSE PLANS FOR DETAILS AND COMPLETE CONSTRUCTION INFORMATION.
3. DOWNSPOUTS ARE TO OUTLET TO SPLASHBLOCKS AND BE DIRECTED AWAY FROM THE HOUSE.
4. A TEMPORARY 2" STONE CONSTRUCTION ENTRANCE (6" THICK) SHALL BE INSTALLED AS PER THE SPECIFICATIONS FOUND IN THE RAINWATER & LAND DEVELOPMENT MANUAL.
5. ALL DISTURBED AREAS SHALL HAVE TEMPORARY SEEDING AS PER SPECIFICATIONS FOUND IN THE RAINWATER & LAND DEVELOPMENT MANUAL.
6. LAKE COUNTY SOIL & WATER CONSERVATION DISTRICT SITE PLAN PERMIT NOTES AND DETAIL SPECS FROM THE MANUAL HAVE ALSO BEEN PROVIDED TO THE CLIENT.
7. DISTURBED AREA= 0.595 Acres,

Rev. 1 2
Description REVISED AS PER LCOH REVISED AS PER LCOH
Date 2/2/04 2/19/04
By JLU JLU
CHK'D:

Site and Septic Plan
P.P.N. 8A-2-35 on
Girdled Road for
Ed Polo Construction
Concord Township ~ Lake County ~ Ohio

STATE OF OHIO
JOHN URBANICK
E-66506
REGISTERED
PROFESSIONAL CIVIL ENGINEER

Drawn By: JLU
Checked By:
Approved By:
Date: 2/19/04

Greenland Consulting, Inc.
6520 Hopkins Road, Mentor, OH 44060
Phone: (440) 250-8167 Fax: (440) 205-1923
E-Mail: greenland@att.net

Scale: Horiz. 1"=20'
Vert. 1"=N/A
Sheet No. 1 Of 2
Filename: 04-001/db