

6" SAN LAT 49" DE FROM
SAN HIGH 1' 8" DEEP.

4

9

O.L. 21
O.L. 22

HORSE
PAVEMENT

LANE 60'

DESIGN CERTIFICATION

This Plat was prepared by me, and is correct to the best of my knowledge and belief. All boundary data shown hereon was obtained from public records.

S/L 10A Edward J. Debevec 4514 7/5/90
Registered Surveyor's Signature Reg. No. Date

S/L 10B Edward J. Debevec 4514 4/21/92
Registered Surveyor's Signature Reg. No. Date

S/L 10C Edward J. Debevec 4514 8/31/90
Registered Surveyor's Signature Reg. No. Date



"AS BUILT" CERTIFICATION

I hereby certify that the circled grades shown hereon are existing finished grades checked in the field on date shown and are correct to the best of my knowledge and belief.

S/L 10A Registered Surveyor's Signature Reg. No. Date

S/L 10B Registered Surveyor's Signature Reg. No. Date

S/L 10C Registered Surveyor's Signature Reg. No. Date

LEGEND




NOTES: Set Driveway culvert 15" below edge of pavement, 24 feet off centerline. Use 12" CMP, 12 gauge culvert pipe.


ISSUED 6-30-92
SUBJECT TO APPROVAL BY:
Lake County Sanitary Eng. ☐
Lake County Eng. Dept. ☒
Lake County Planning Comm. ☒
For Ray Zirkle
5865 Shore Drive, PO Box Lake County Bldg. Dept.
Madison, Ohio 44057
Phone (216) 428-2058

OF Sublot No. 10B
OLDE MILL SUBDIVISION
Concord Township,
Lake County, Ohio

Prepared By:
Debevec-Salo & Associates, Inc.
860 Bryn Mawr Avenue
Richfield, Ohio 44092
Phone (216) 944-2589
Date 6-11-92
12" DRIVE CULVERT
Scale: 1"=30'

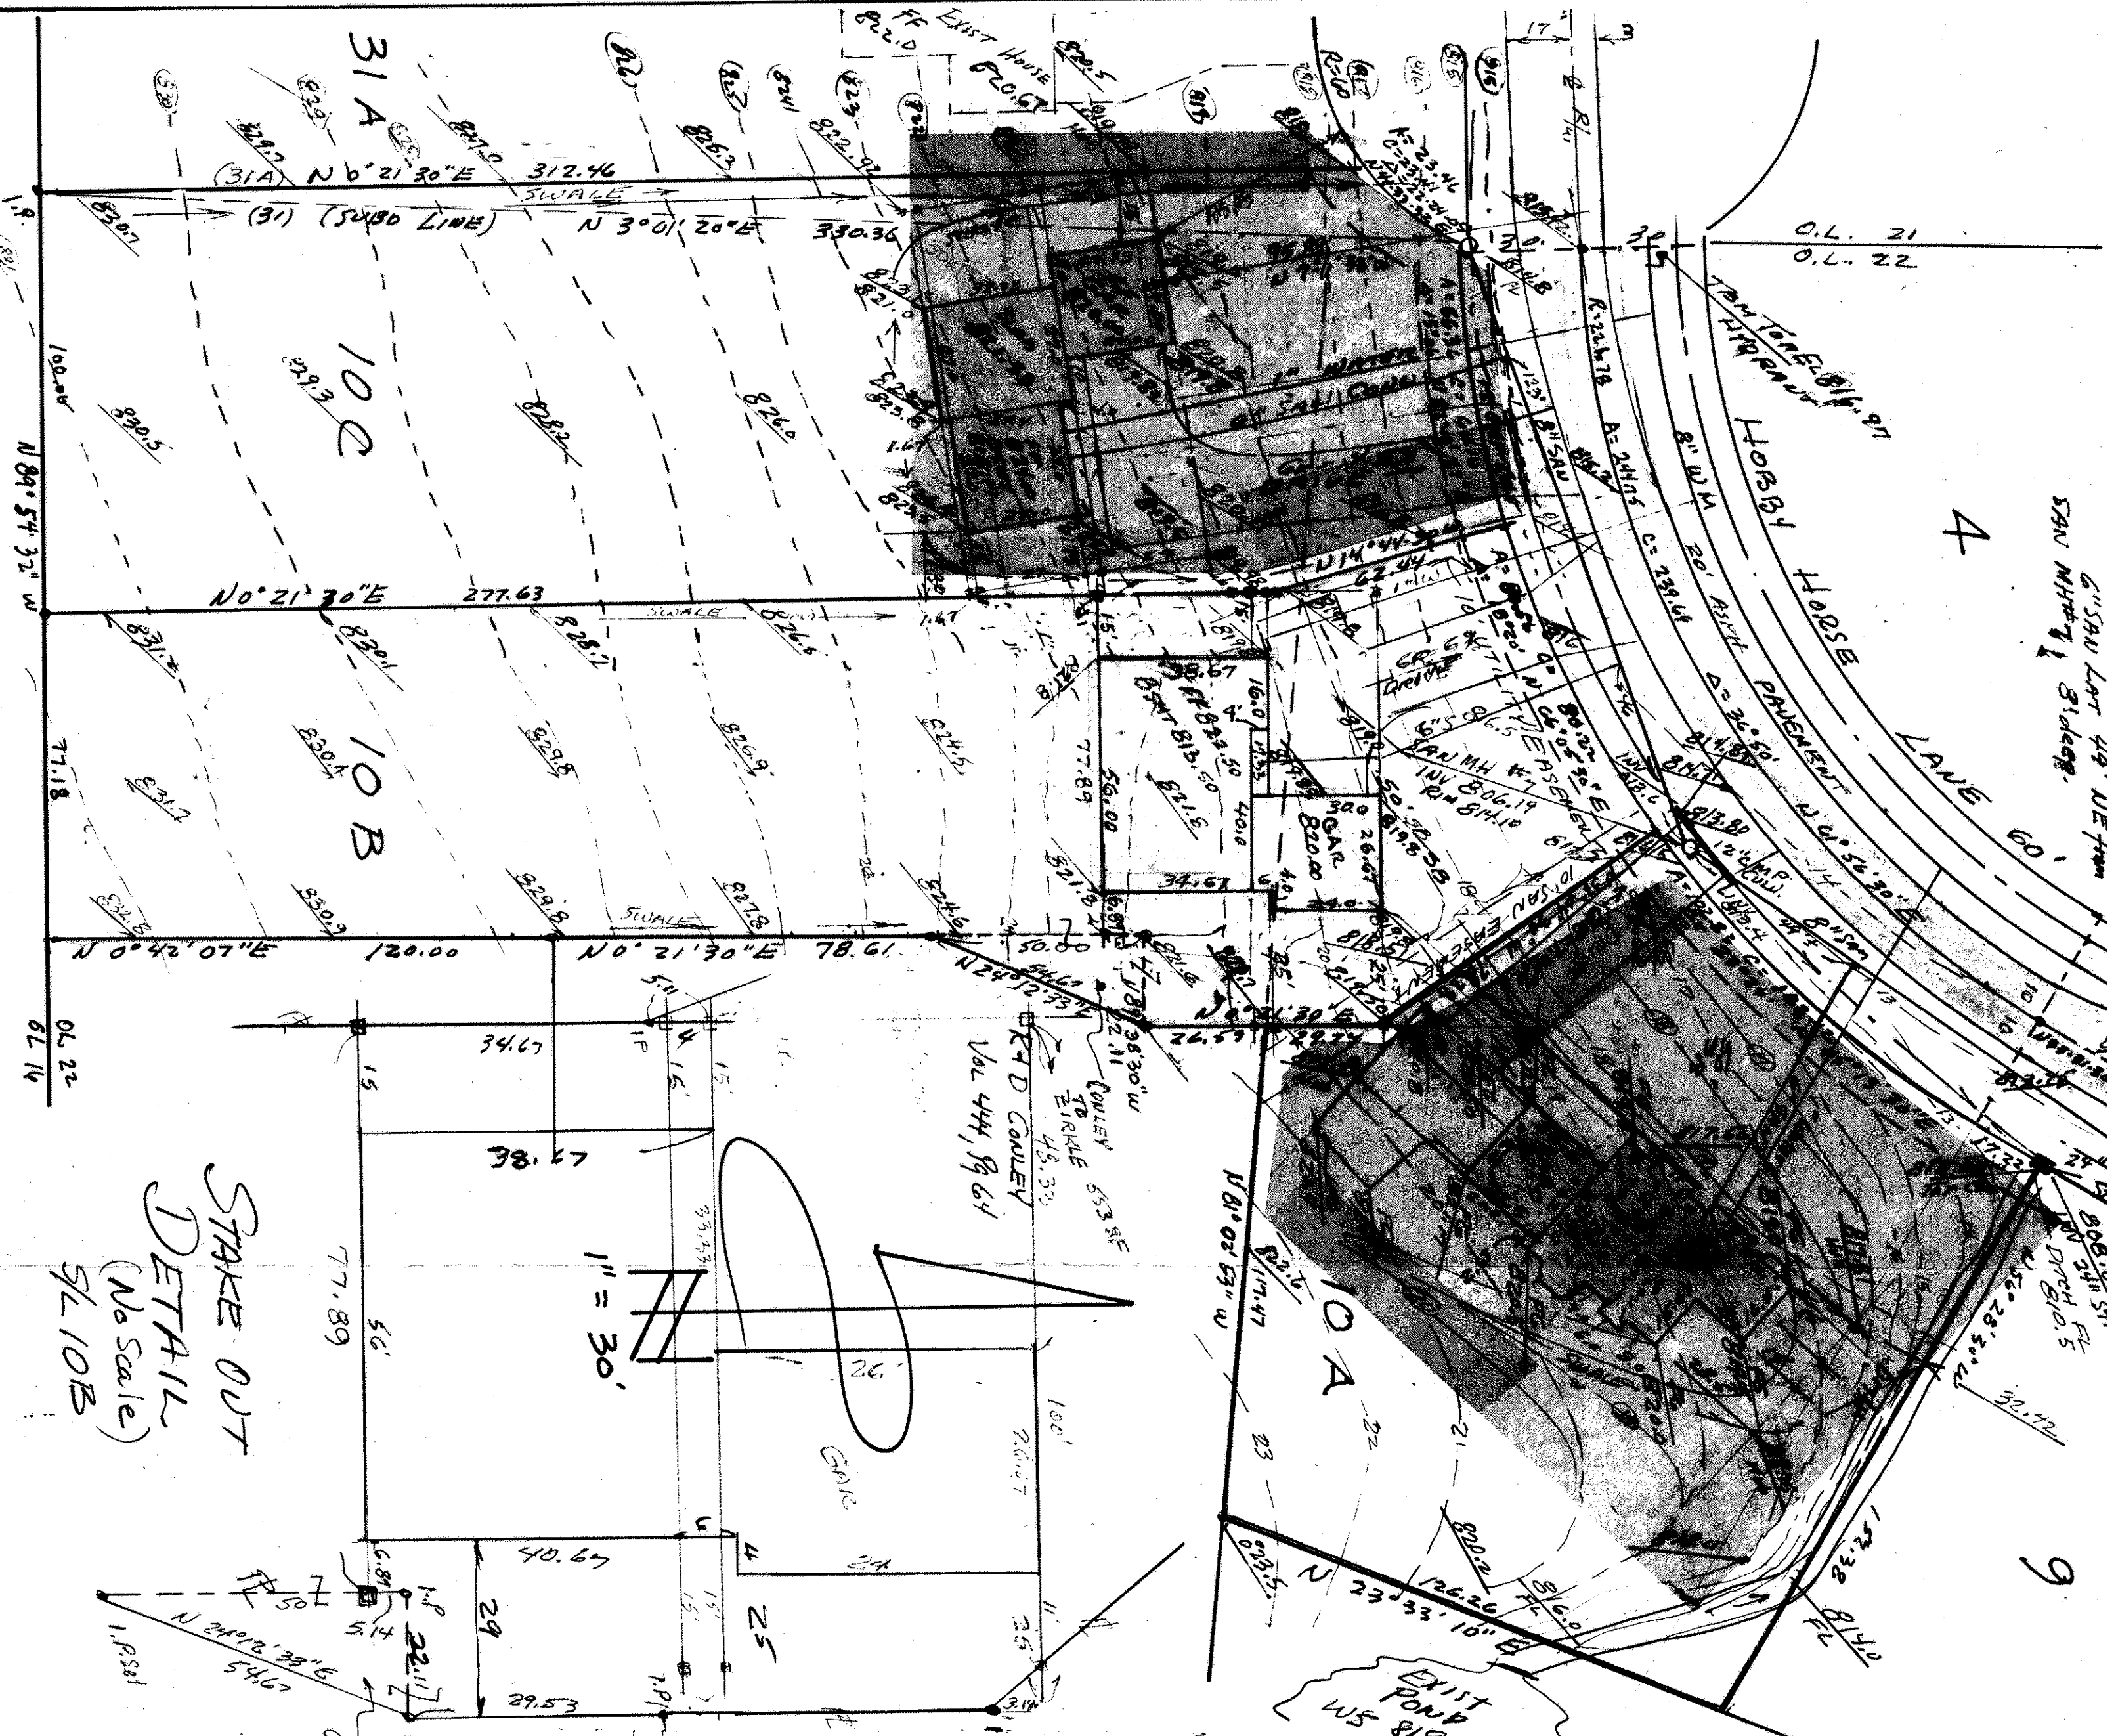

STAKE OUT
DETAIL
(No Scale)
S/L 10B