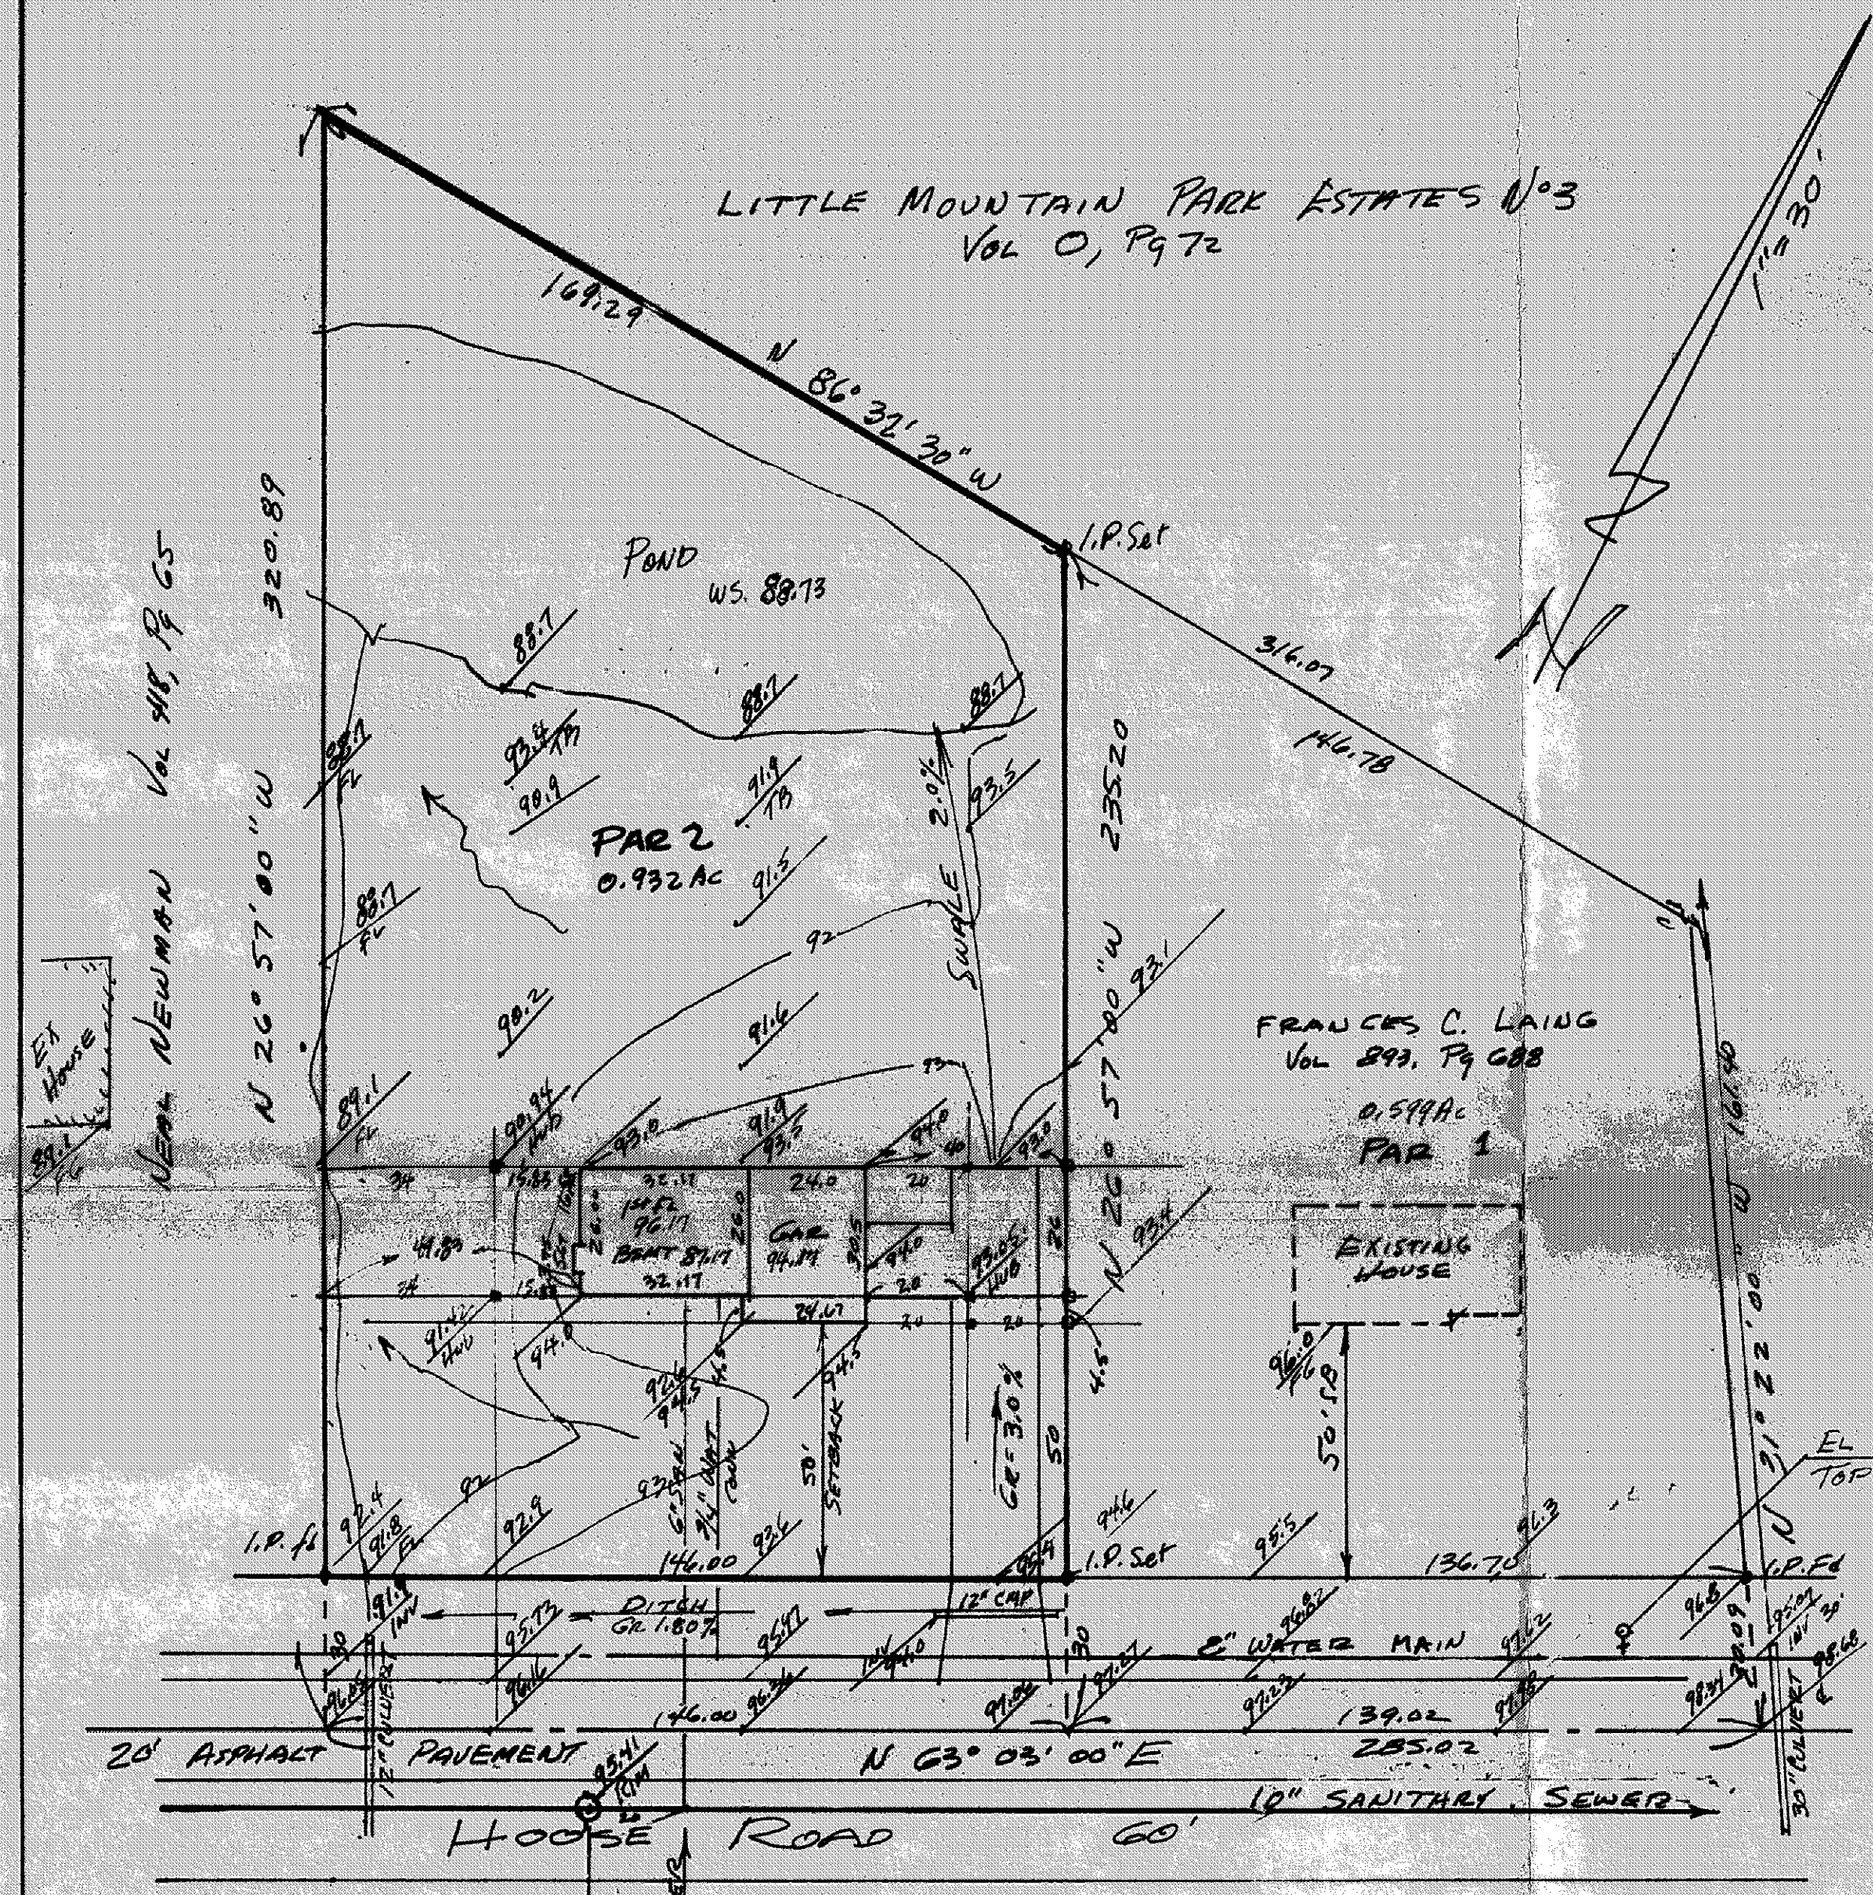

DESIGN CERTIFICATION

This Plat was prepared by me, and is correct to the best of my knowledge and belief. All boundary data shown hereon was obtained from public records.

Edward L Debevec
Registered Surveyor's Signature

Registration No: 4514

Seal:

STATE OF OHIO
EDWARD L DEBEVEC 4514
SURVEYOR

LEGEND

Existing Elevation: 100
Proposed Elevation: 100
As-Built Elevation: (100)

Existing Contour: - - - - -
Proposed Contour: ———

NOTES: Set Driveway culvert as shown on plan in existing ditch. Use 12" min diameter CMP, 12 gauge culvert pipe or equivalent.

Grading Plan Approved
as shown and/or noted
THOMAS P. GILLES, P.E.
Lake County Engineer
By GJH 3/28/91

POTENTIAL FOR STANDING WATER AND FLOODING.

THERE WILL BE NO OPEN CUTS OF EXISTING PAVEMENT ON COUNTY ROADWAYS WITHOUT THE APPROVAL OF THE LAKE COUNTY ENGINEER. WHERE OPEN CUTTING IS PERMITTED, TRAFFIC SHALL BE MAINTAINED AT ALL TIMES.

STREET OPENING PERMIT FOR THE SANITARY SEWER CONNECTION MUST BE OBTAINED FROM THE LAKE COUNTY ENGINEER.

#6710

ZONING PERMIT
ISSUED 3-19-91

SUBJECT TO APPROVAL BY:
Lake County Sanitary Eng. ☐
Lake County Eng. Dept. ☒
Lake County Planning Comm. ☐
Lake County Bldg. Dept. ☒

Pete S. Marano

SITE PLAN

For Tim Square
6388 Middle Ridge Road
Madison, Ohio 44057
Phone (216) 428-5305

PARCEL No 2
of PERMANENT PARCEL NO.
10A-023B-005
Part of
Original Concord Township
Lot No.13 in Tract No.4
9795 Hoose Road
Concord Township, Ohio

Prepared By:

Debevec-Salo & Associates, Inc.
860 Bryn Mawr Avenue
Wickliffe, Ohio 44092
Phone (216) 944-2589

1"=30' 3/15/91 6554