


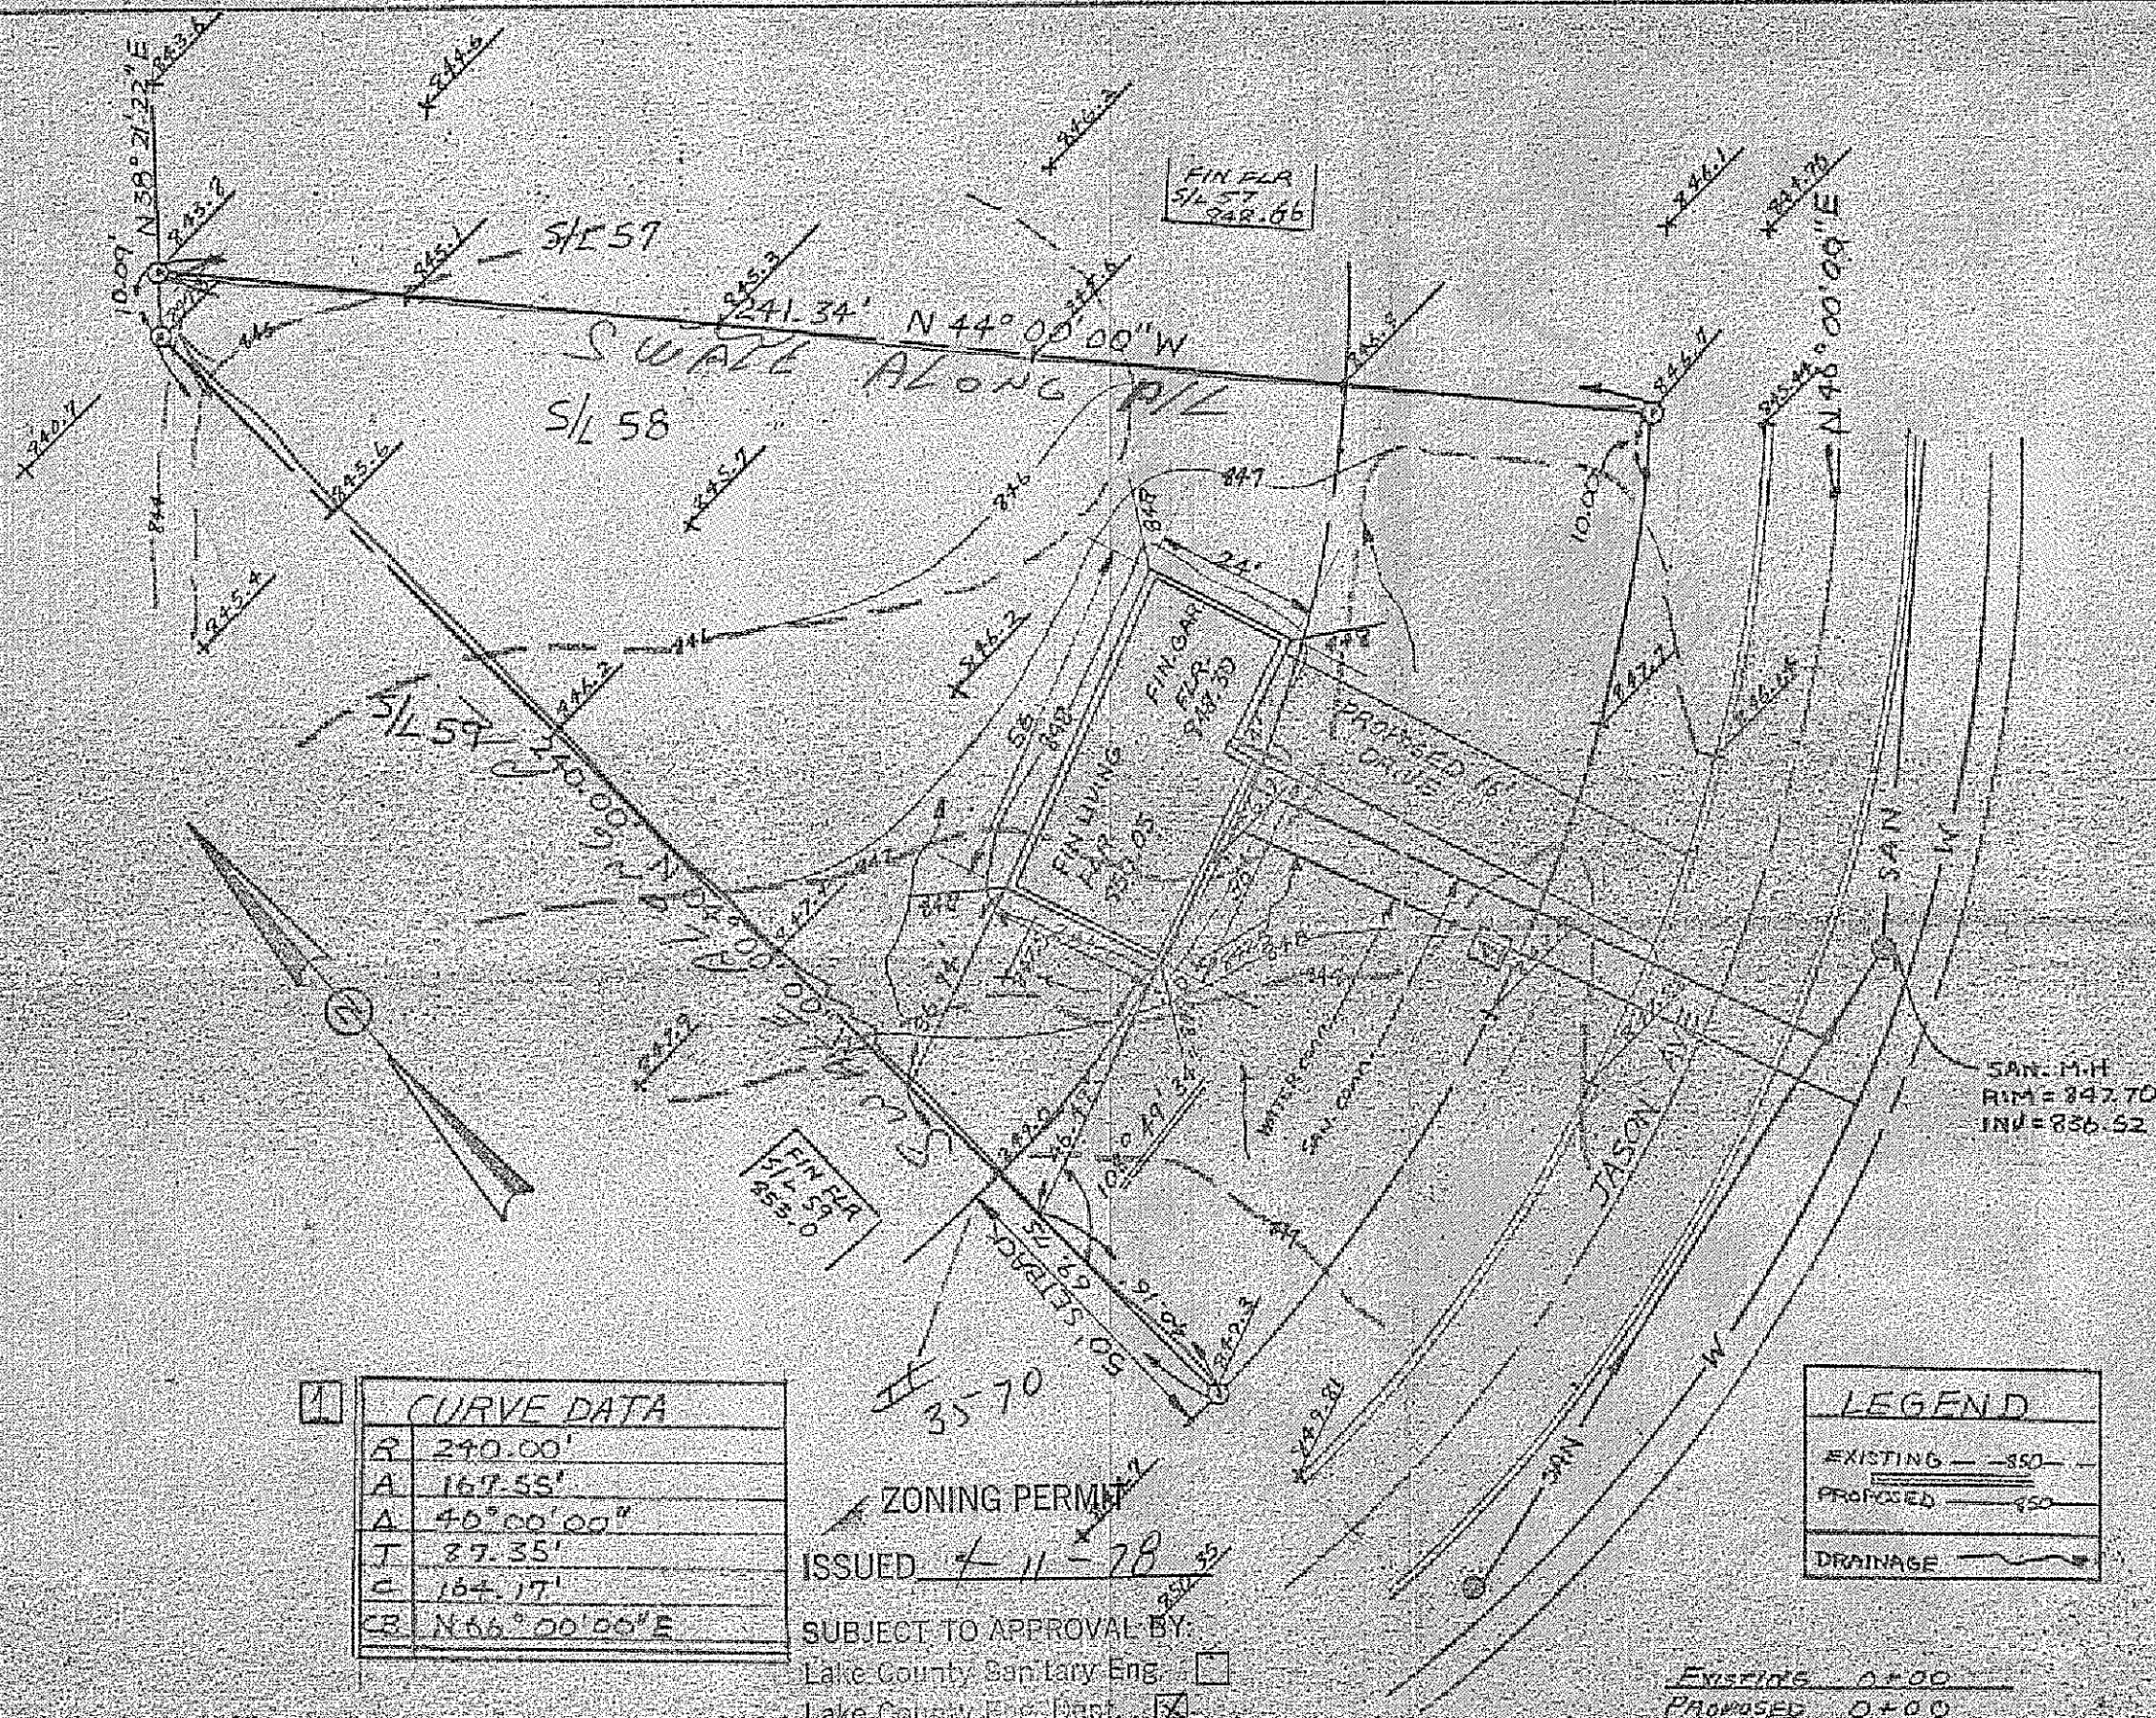

SITE PLAN FOR:

RYAN HOMES
8141 TYLER BLVD.
MENTOR, OHIO
BEING SUBLOT NO.
58 IN THE FAR HILLS SUBD.
LOCATED IN CONCORD, OHIO

Grading Plan Approved
as shown and/or noted
THO SPS P. GILLES, P.E.
Lake County Engineer
By TCO Date 2 APR 78

PREPARED BY:

WM. R. GRAY ASSOC. INC.
1547 MENTOR AVE.
MENTOR, OHIO

SCALE: 1"=30'
DATE: 4-6-78

CERTIFICATION:

I HEREBY CERTIFY
THAT THIS PLAN IS CORRECT
TO THE BEST OF MY
KNOWLEDGE.

By WM. R. Gray
WM. R. GRAY REG. SURVEYOR

