O'Kelly

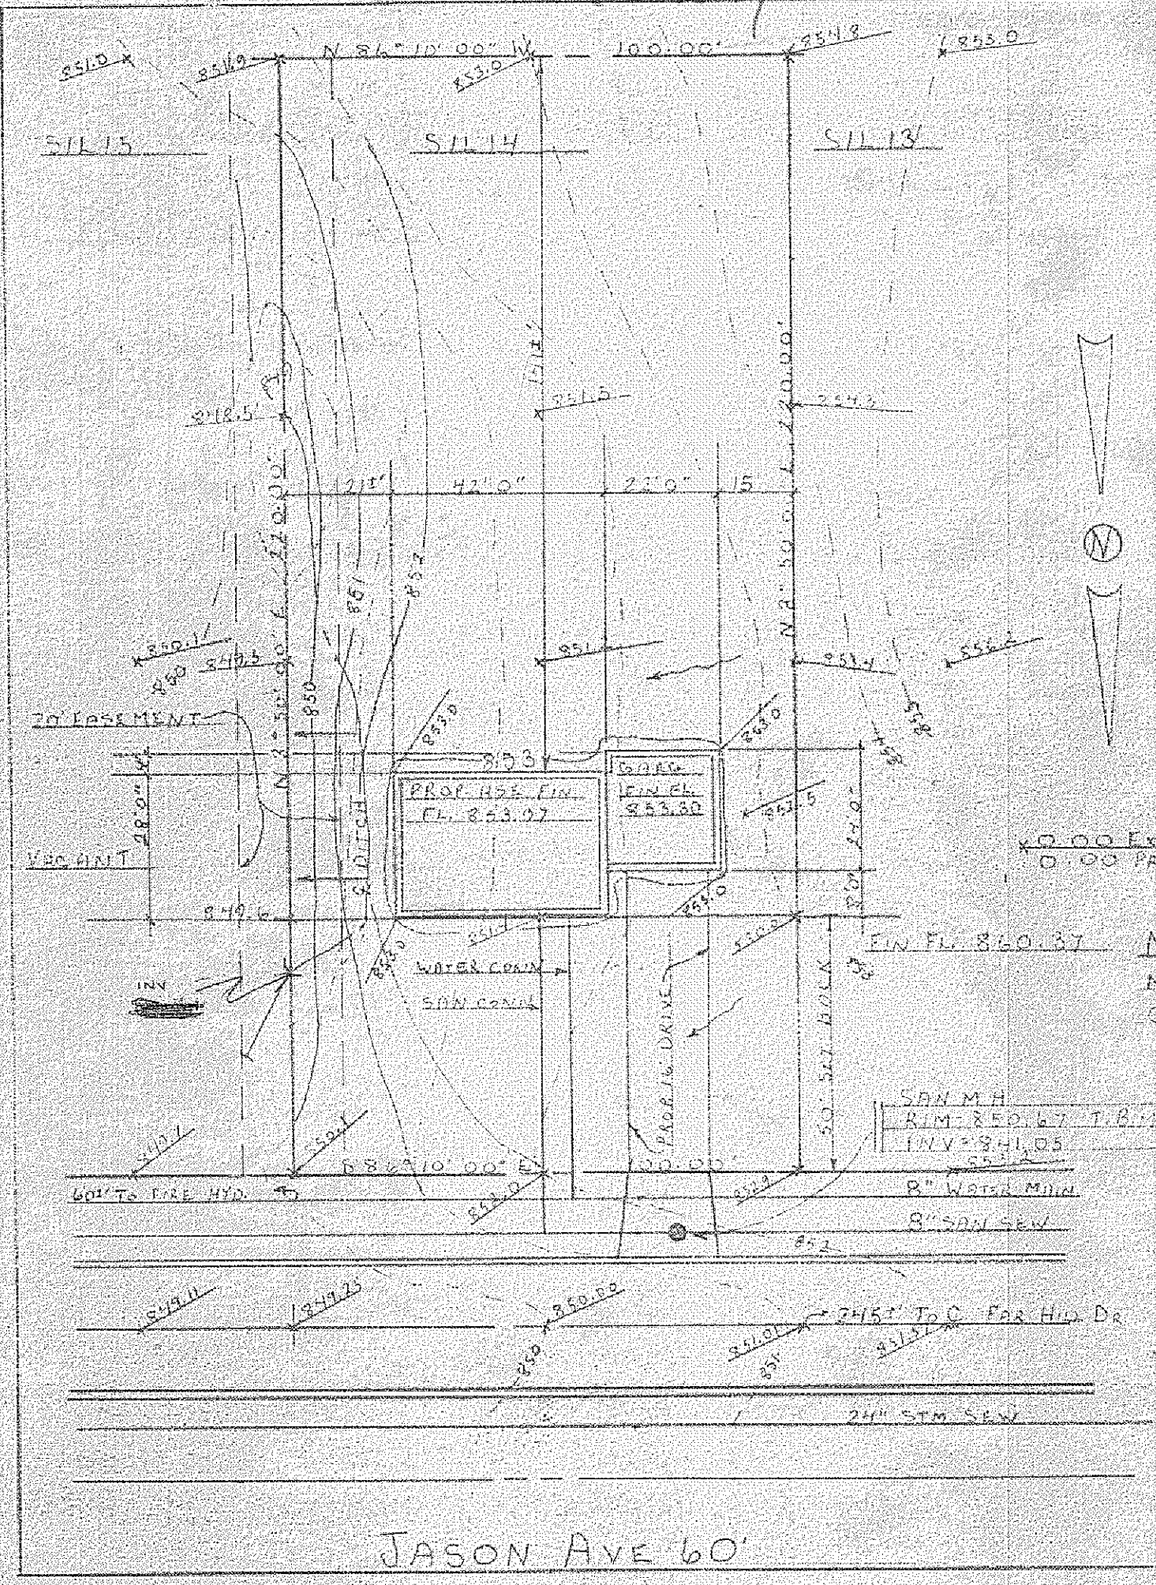

Grading Plan Approved as shown and/or noted
T. M. [illegible] P. GILLES, P. E.
Lake County Engineer
By _____ Date 30 MAY 78

0.00 EXIST. ELEV.
0.00 PROP. ELEV.

NOTE:
MOVE DITCH TO CENTER OF EASEMENT

SITE PLAN FOR:
RYAN HOMES
8141 TYLER BLVD.
MENTOR, OHIO
BEING SUBLOT NO. 14 IN THE FAR HILL ESTATES SUBDIVISION IN CONCORD TOWNSHIP, OHIO

PREPARED BY:
WM. R. GRAY ASSOC. INC.
7547 MENTOR AVE.
MENTOR, OHIO
SCALE: 1" = 30'
DATE: MAY 12, 1978

CERTIFICATION:
I HEREBY CERTIFY THAT THIS PLAT IS CORRECT TO THE BEST OF MY KNOWLEDGE
BY: Wm. R. Gray
WM. R. GRAY REG. SURV. # 2752

STATE OF OHIO
WM. R. GRAY
2752
REGISTERED
PROFESSIONAL SURVEYOR

81 Via Shennen Dora