


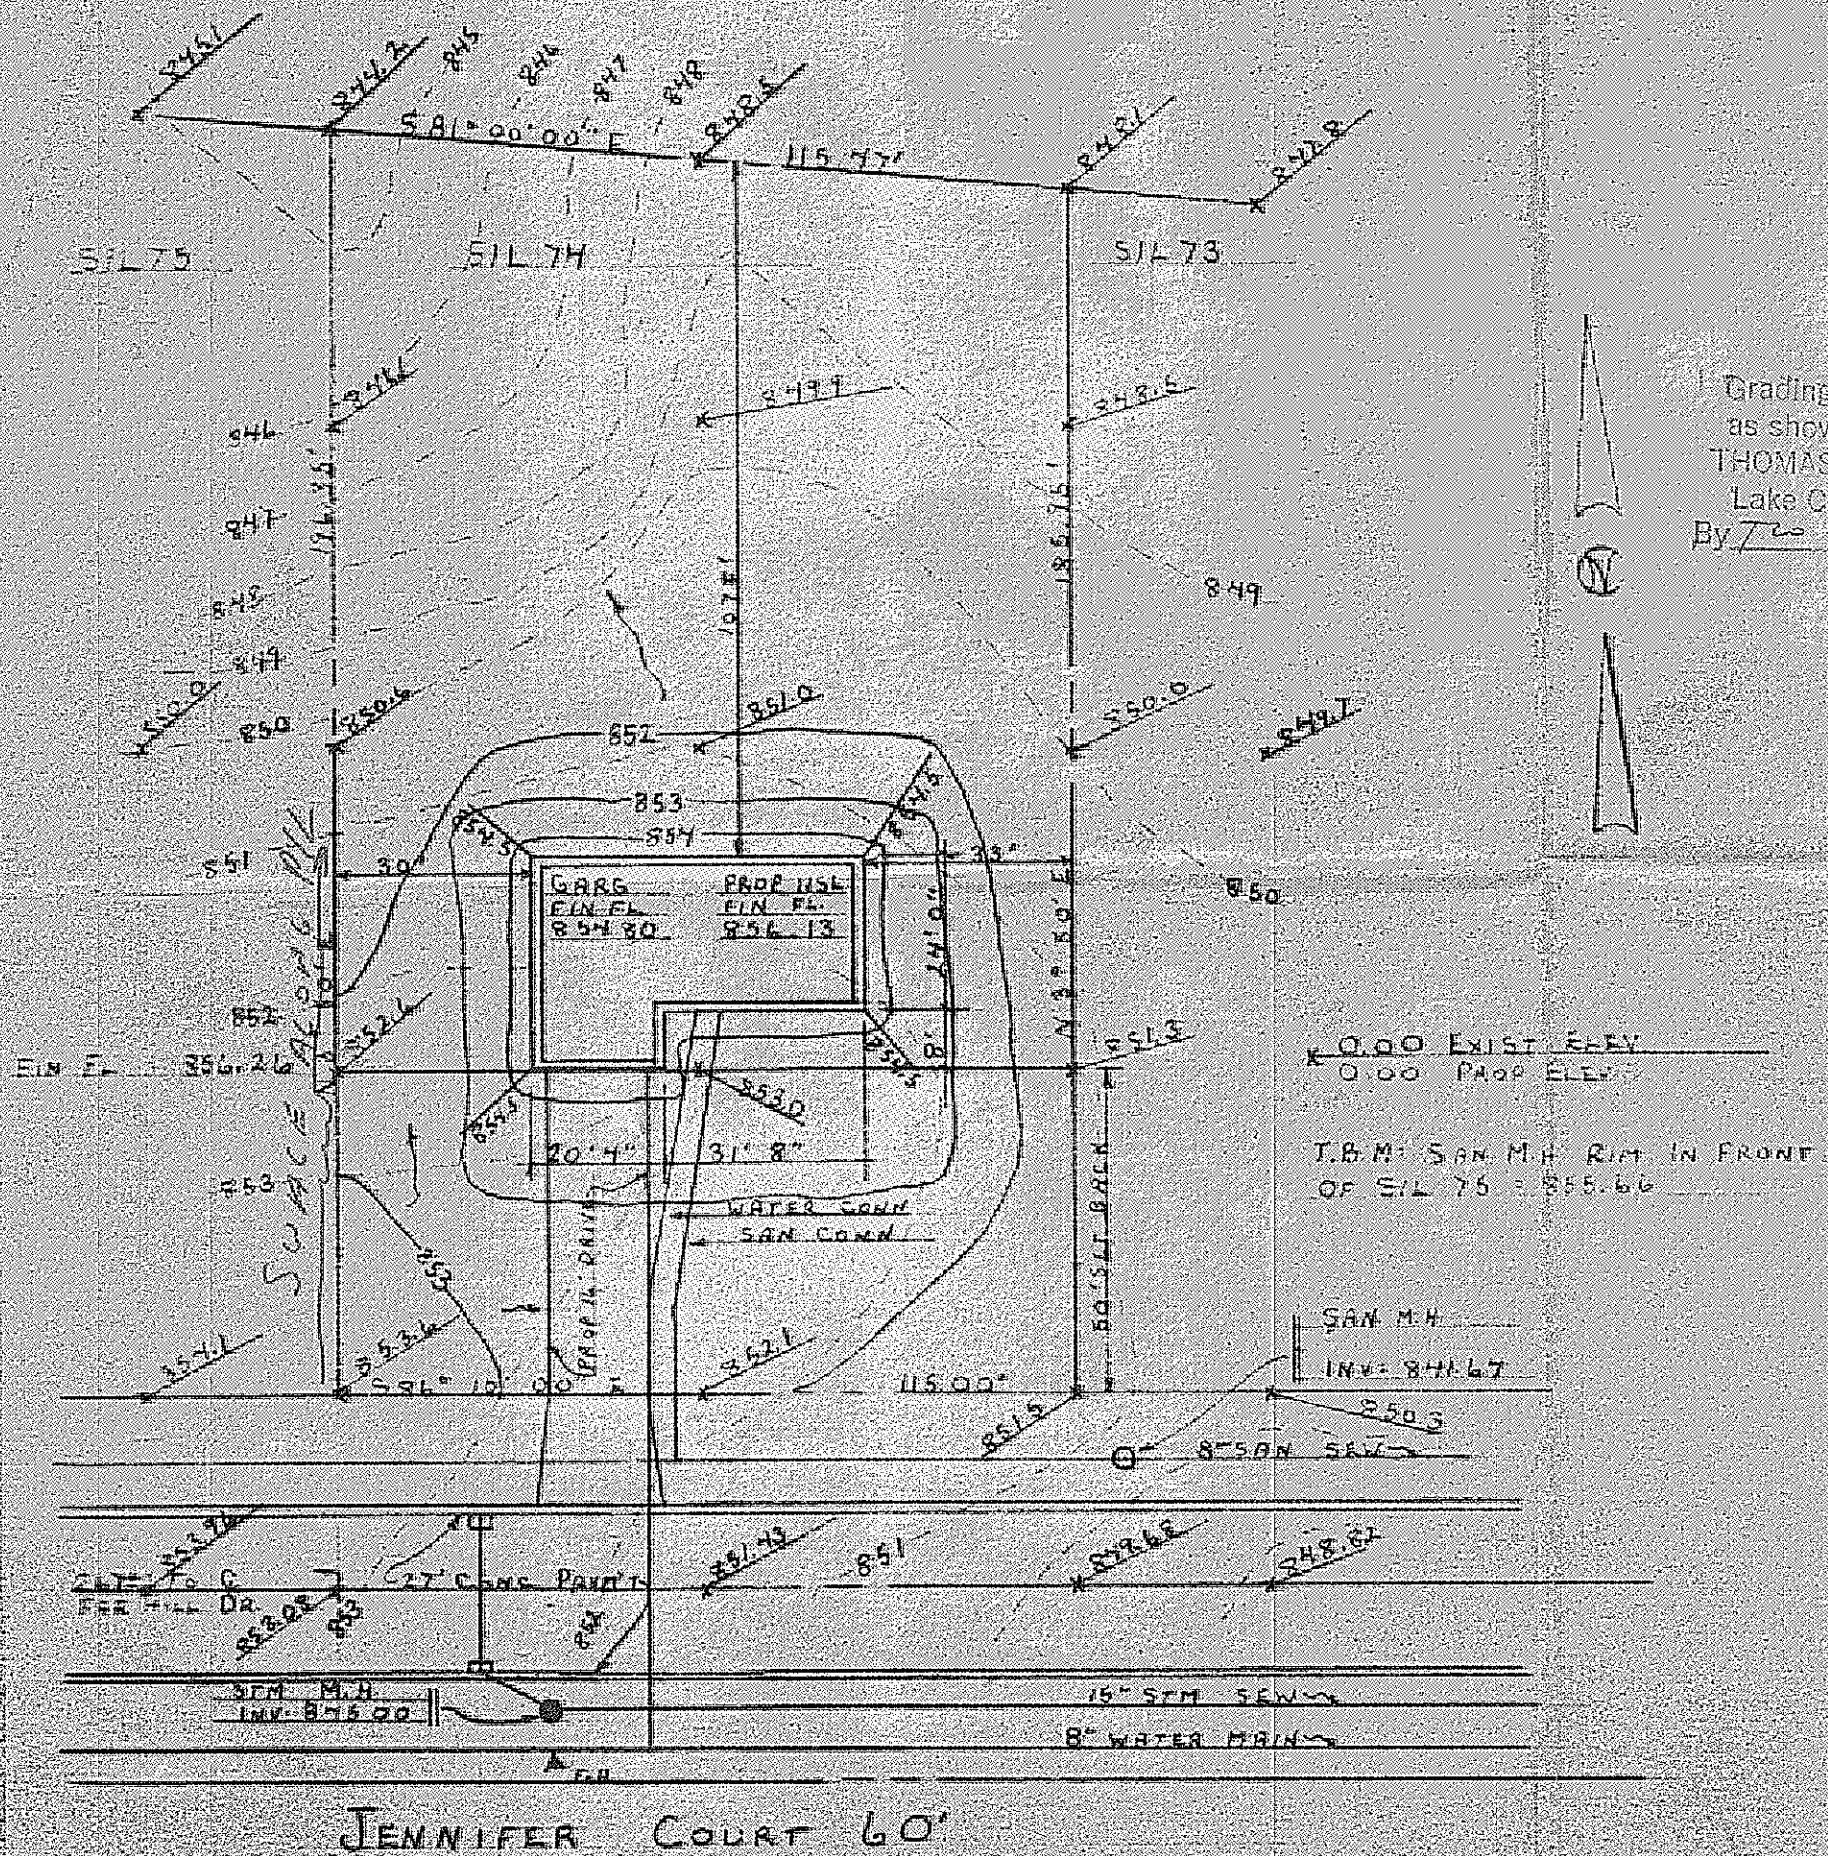

SITE PLAN FOR:

RYAN HOMES
8141 TYLER BLVD
MENTOR, OHIO

Grading Plan Approved as shown and/or noted
THOMAS P. GILLES, P.E.
Lake County Engineer
By 720 Date 6-2-78

BEING SUBLOT NO 74 IN THE FAR
HILLS SUBDIVISION IN CONCORD
TOWNSHIP, OHIO

PREPARED BY:

WM R GRAY ASSOC INC
7547 MENTOR AVE
MENTOR, OHIO

SCALE: 1"=30'

DATE: JAN 20, 1978

ZONING
PERMIT

Approved 2-2-78

CERTIFICATION:

I HEREBY CERTIFY THAT THIS
PLAN IS CORRECT TO THE BEST OF
MY KNOWLEDGE

By: Wm. R. Gray

WM R GRAY REG SURV # 2752 STATE OF OHIO

