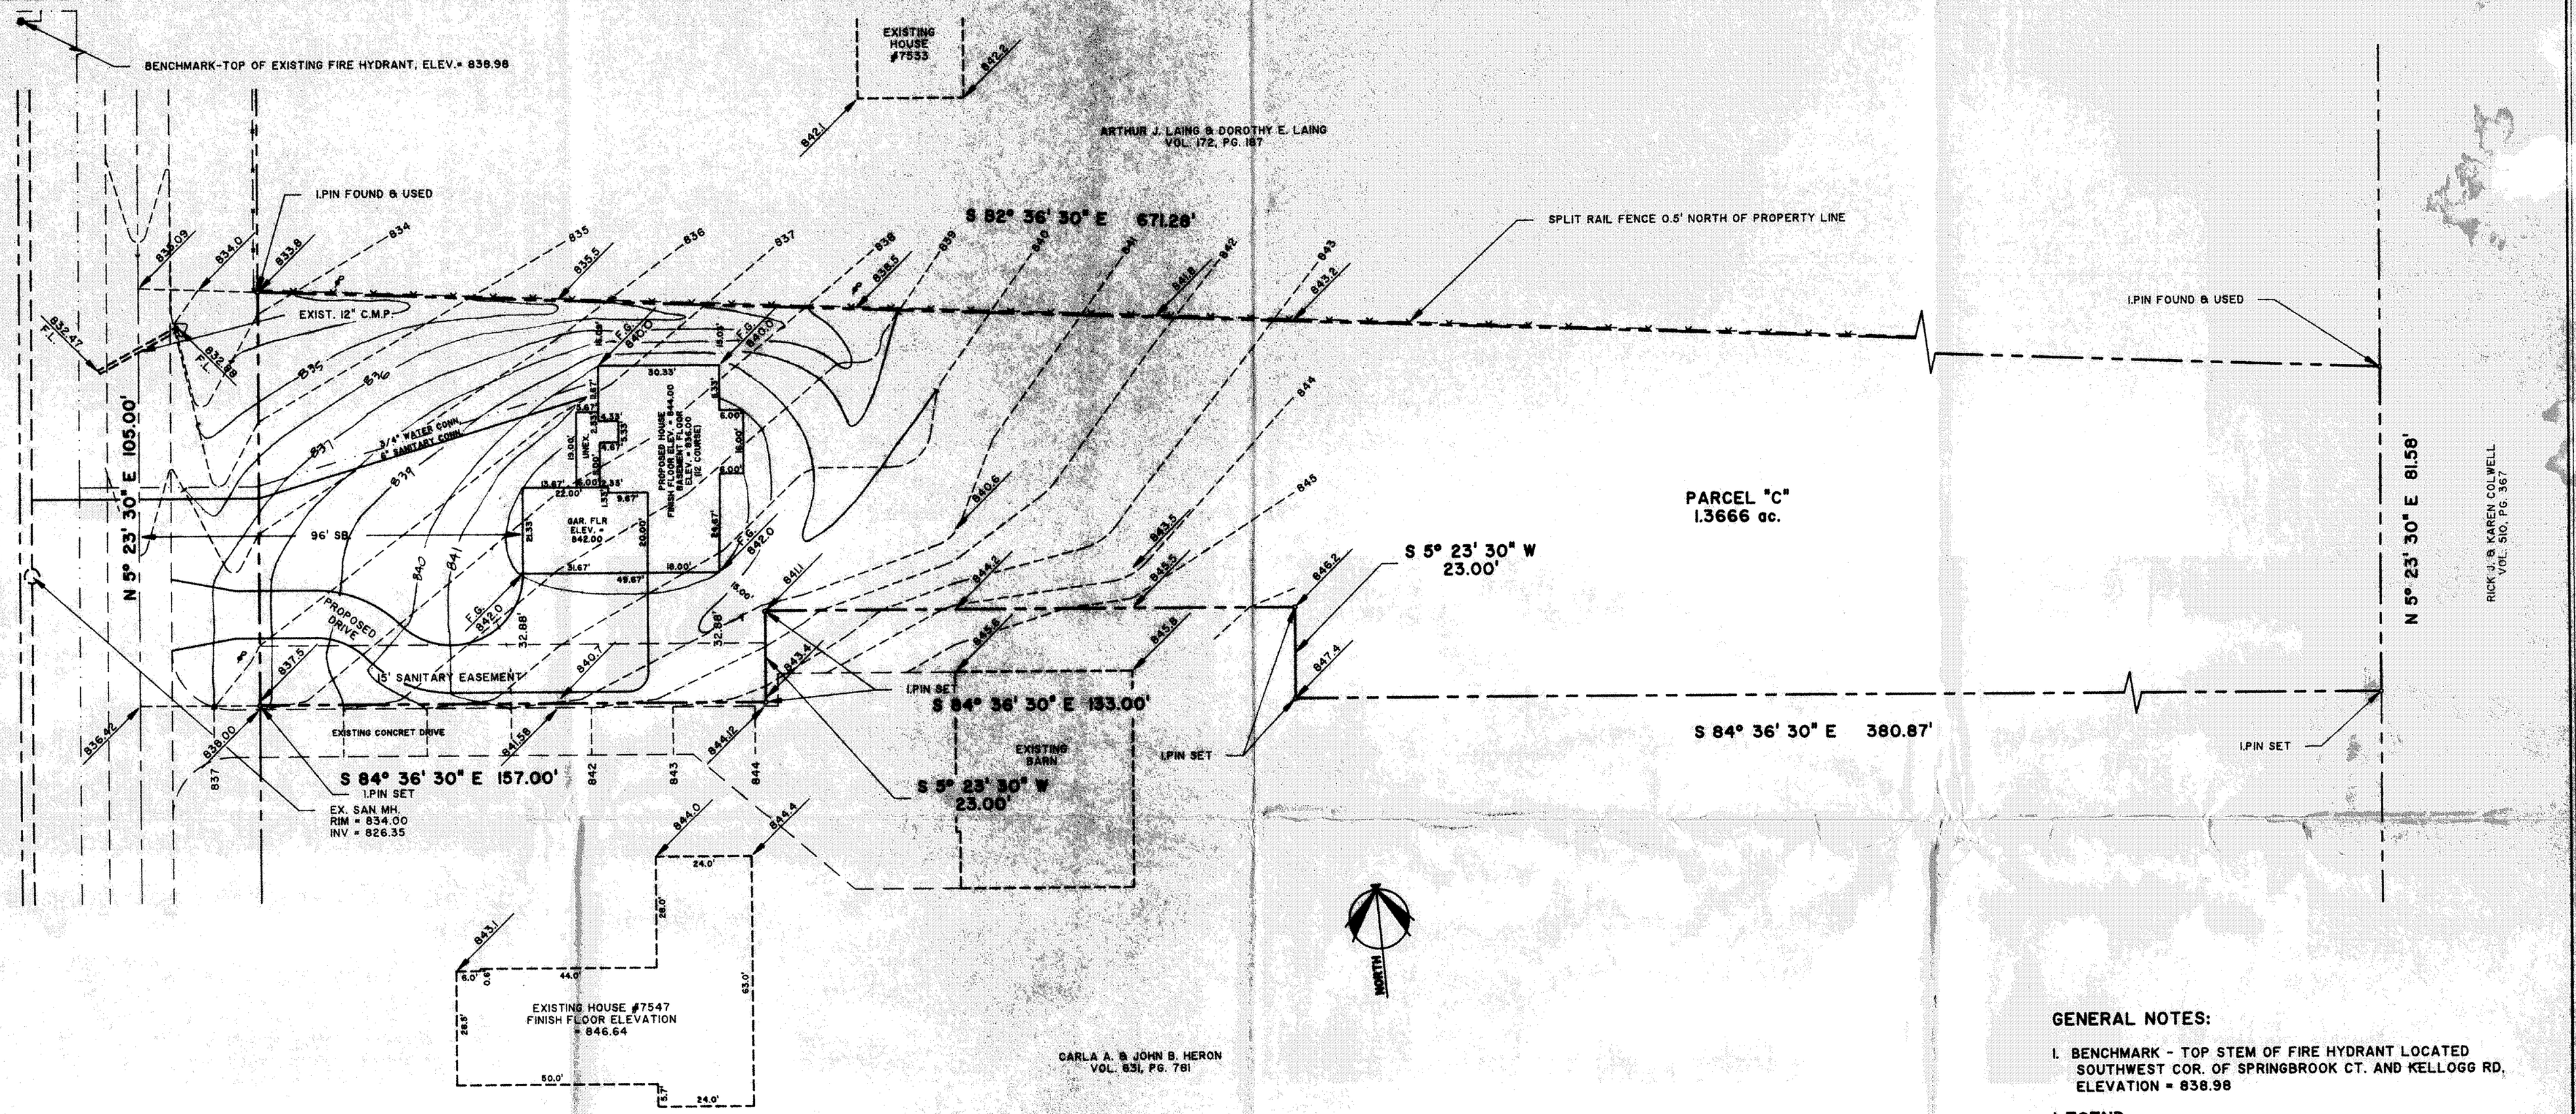

STAKE SCHEDULE

0.00'
13.67'
19.33'
19.67'
22.00'
24.34'
31.67'
49.67'
55.67'
DIAG. @ 10' = 91.01'

GENERAL NOTES:

1. BENCHMARK - TOP STEM OF FIRE HYDRANT LOCATED SOUTHWEST COR. OF SPRINGBROOK CT. AND KELLOGG RD, ELEVATION = 838.98

LEGEND

EXISTING CONTOUR
PROPOSED CONTOUR

100.00 / 100.00 — EXISTING ELEVATION / PROPOSED ELEVATION

CERTIFICATION

"I THE UNDERSIGNED HEREBY CERTIFY THAT THIS TOPOGRAPHY INDICATED BY 1' CONTOURS AND ELEVATIONS SHOWN HEREON REPRESENTS AN ACTUAL SURVEY MADE BY ME ON THE 15th DAY OF AUGUST , 1991 AND THE ELEVATIONS WERE TAKEN AT APPROPRIATE INTERVALS AND AS OF THAT DAY THEY EXISTED AS INDICATED HEREON.

"I HEREBY CERTIFY THAT THIS PLAN WAS PREPARED BY ME AND IS CORRECT TO THE BEST OF MY KNOWLEDGE"

Quentin S. Himebaugh P.S. #6820
QUENTIN S. HIMEBAUGH, P.S. No. 6820

Grading Plan Approved as shown and/or noted
THOMAS P. GILLEO, P.E.
Lake County Engineer
By GJH Date 9/10/91

ZONING PERMIT #6947
ISSUED 9-10-91
SUBJECT TO APPROVAL BY:
Lake County Sanitary Eng. ☐
Lake County Eng. Dept. ☒
Lake County Planning Comm. ☐
Lake County Bldg. Dept. ☒

REV. No.	DESCRIPTION	DATE	BY	CH'K'D.
A	REVISED HOUSE GRADES PER. R.J.C.	9/3/91	DWN	

STATE OF OHIO — QUENTIN S. HIMEBAUGH 6820 — REGISTERED SURVEYOR

Himebaugh and Associates
Surveyors and Site Consultants
38083 West Spaulding St.
Willoughby, Ohio 44094
(216) 946-1761

LITTLE MOUNTAIN HOMES, INC.
PAINESVILLE, OHIO 44077

DATE: AUGUST 21, 1991
DRAWN BY: D. W. NOVAK
CHECKED BY: Q. HIMEBAUGH
APPROVED BY:
F.B. No. 14 PG. 22

Address

SITE PLAN

1.3666 ac. PARCEL ON KELLOGG ROAD
CONCORD TOWNSHIP, OHIO

SCALES:
HORZ.: 1" = 20'
VERT.: NONE
CONTRACT No. 91-079-C
SHEET No. 1 OF 1

FORM No. 005 (04/24/90)

REF # 90-056