DISAPPROVED COPY

SITE PLAN

FOR JACK GORCA

OF 1.911 ACRE PARCEL LOCATED IN CONCORD TOWNSHIP LOT NO 2 TRACT NO 4 CONCORD TOWNSHIP OHIO MARCH 1989
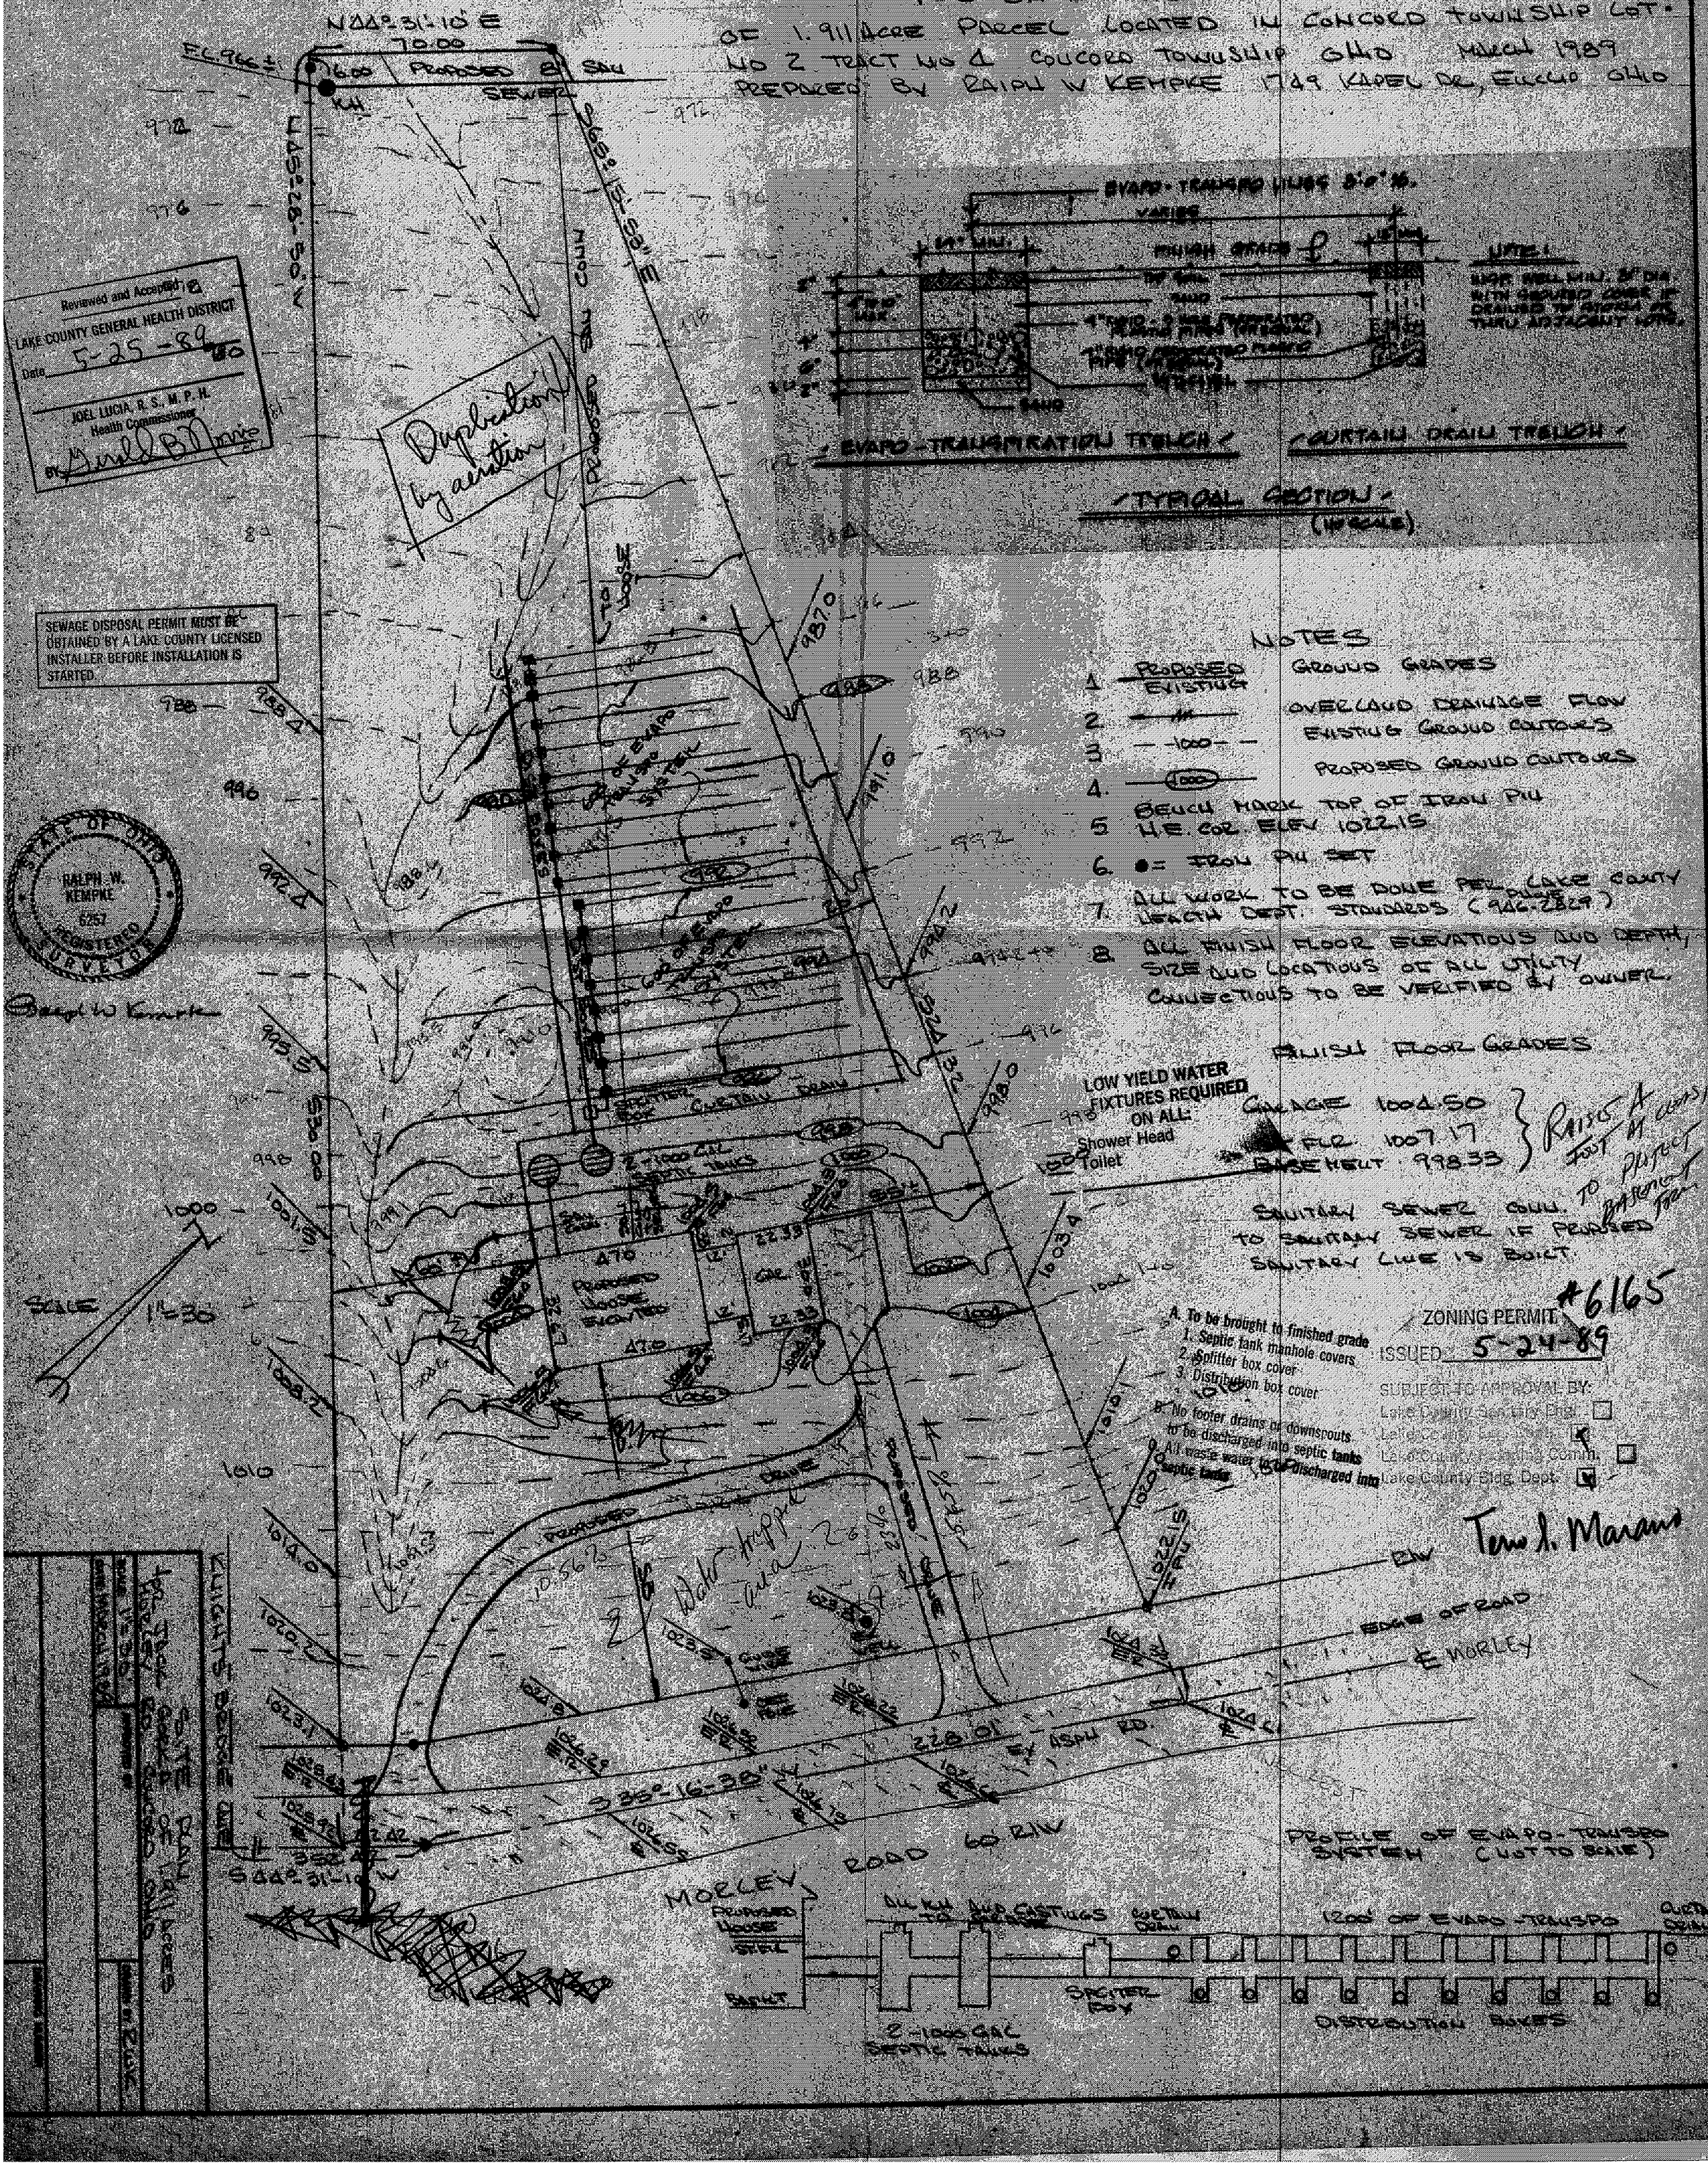
PREPARED BY RALPH W KEMPKE 1749 VADEL DR, EUCLID OHIO