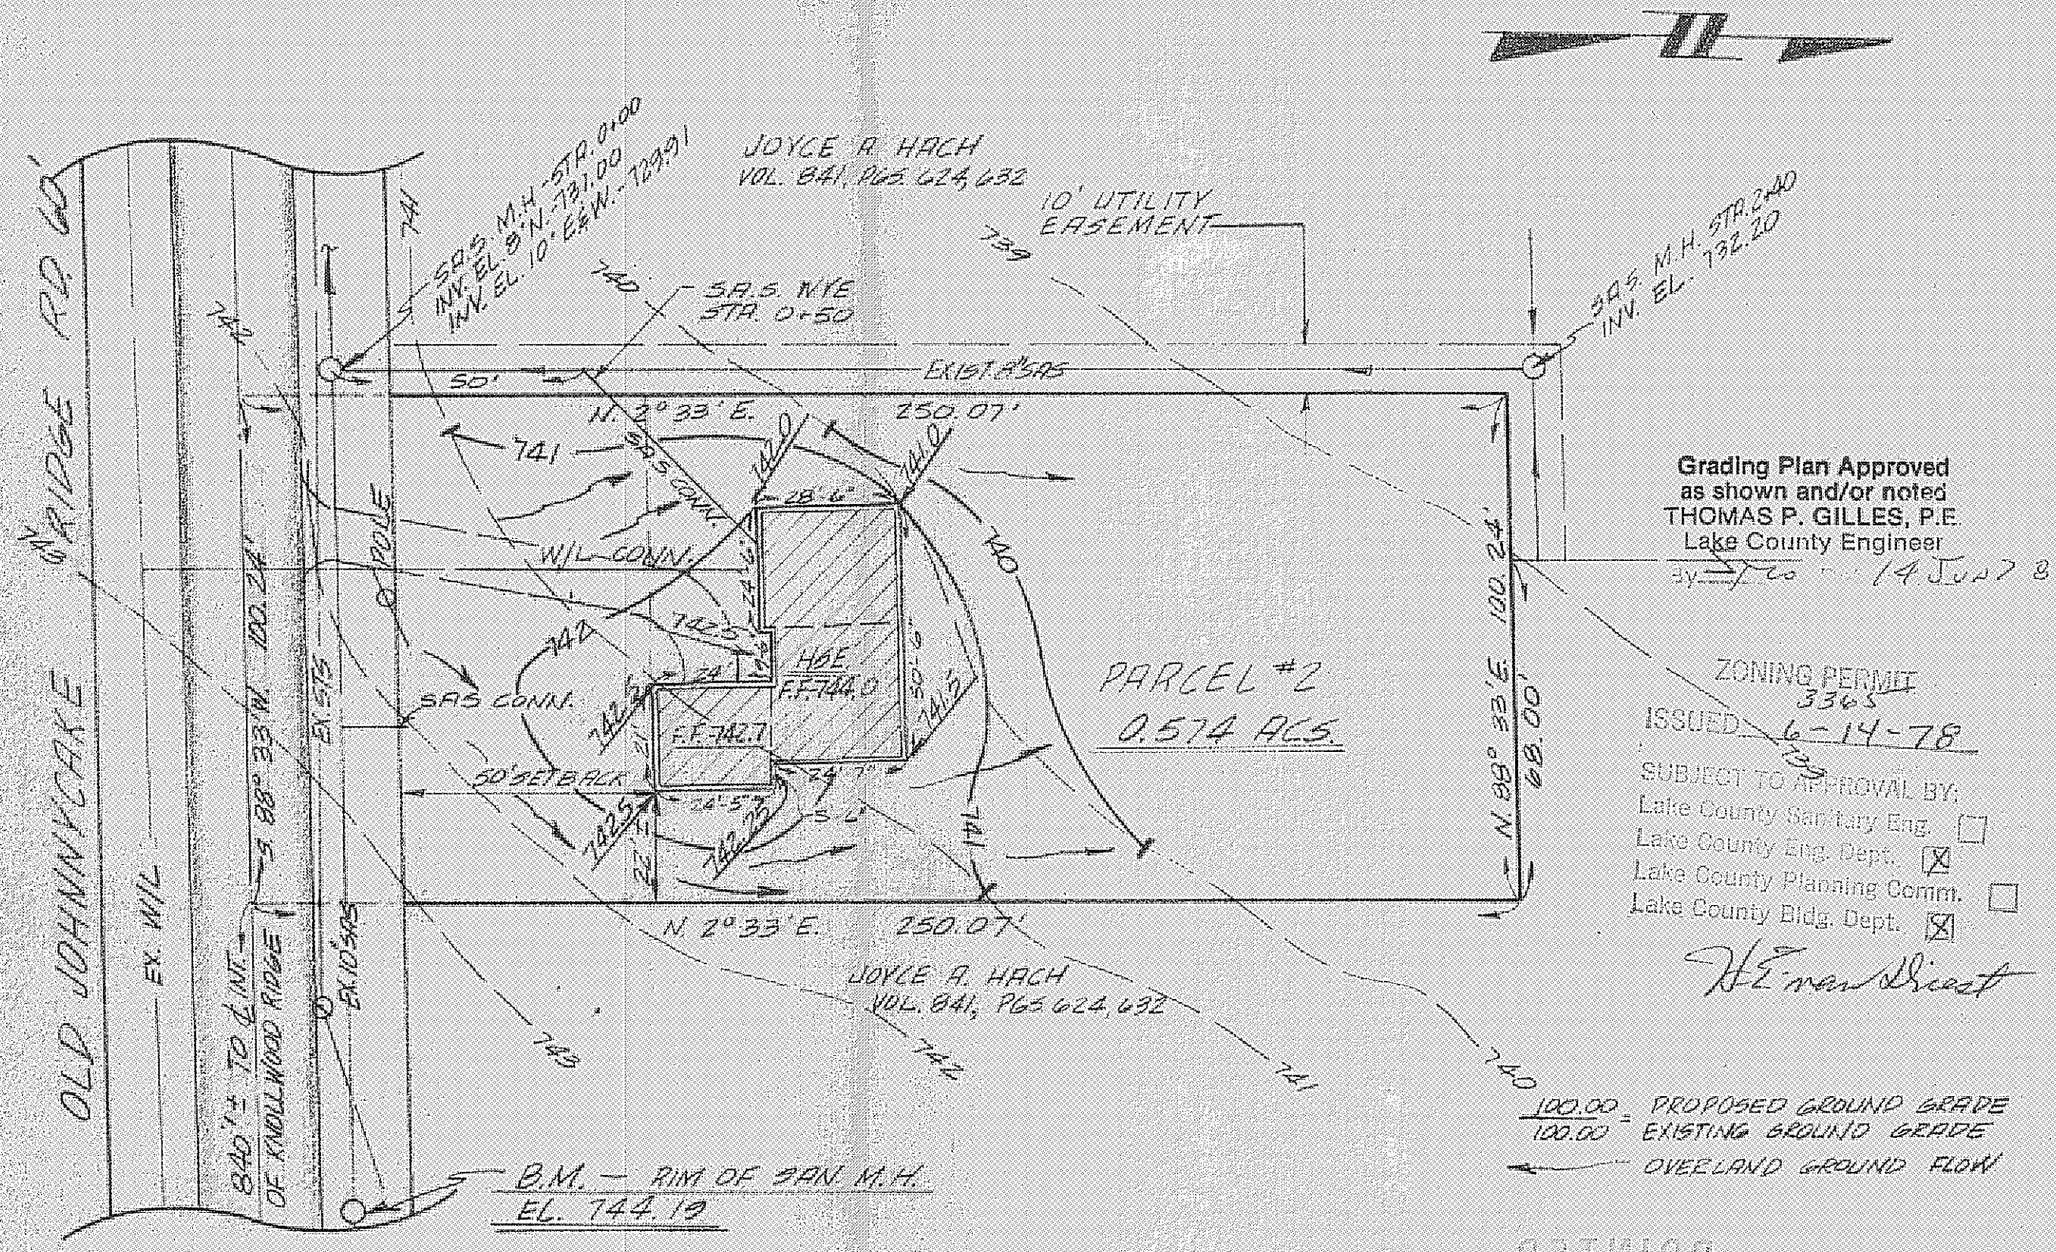

Grading Plan Approved
as shown and/or noted
THOMAS P. GILLES, P.E.
Lake County Engineer
by _____ 14 Jun 78

ZONING PERMIT
3365
ISSUED 6-14-78

SUBJECT TO APPROVAL BY:
Lake County Sanitary Eng. ☐
Lake County Eng. Dept. ☒
Lake County Planning Comm. ☐
Lake County Bldg. Dept. ☒

Herman Direct

100.00 = PROPOSED GROUND GRADE
100.00 = EXISTING GROUND GRADE
← OVERLAND GROUND FLOW

DESIGN CERTIFICATION

THIS PLAT WAS PREPARED BY ME, AND IS CORRECT TO THE BEST OF MY KNOWLEDGE AND BELIEF.

_____
REG. SURVEYOR NO. 4785

AS BUILT CERTIFICATION

I HEREBY CERTIFY THAT THE CIRCLED GRADES ARE EXISTING FINISH GRADES CHECKED IN THE FIELD ON _____ AND THAT SURVEY IS CORRECT TO THE BEST OF MY KNOWLEDGE AND BELIEF.

_____
REG. SURVEYOR NO. _____

COLPETZER · WOODS
CONSULTANTS, INC.

DATE 6/13/78
SCALE 1"=30'
DRWN BY ECF
CHKD BY #
JOB NO. 78-034
FB 320 PG 85

SITE PLAN
FOR
TED HACH

BEING PARCEL #2 OF LOT 31, TRACT 4 IN CONCORD TOWNSHIP, LAKE COUNTY, OHIO