


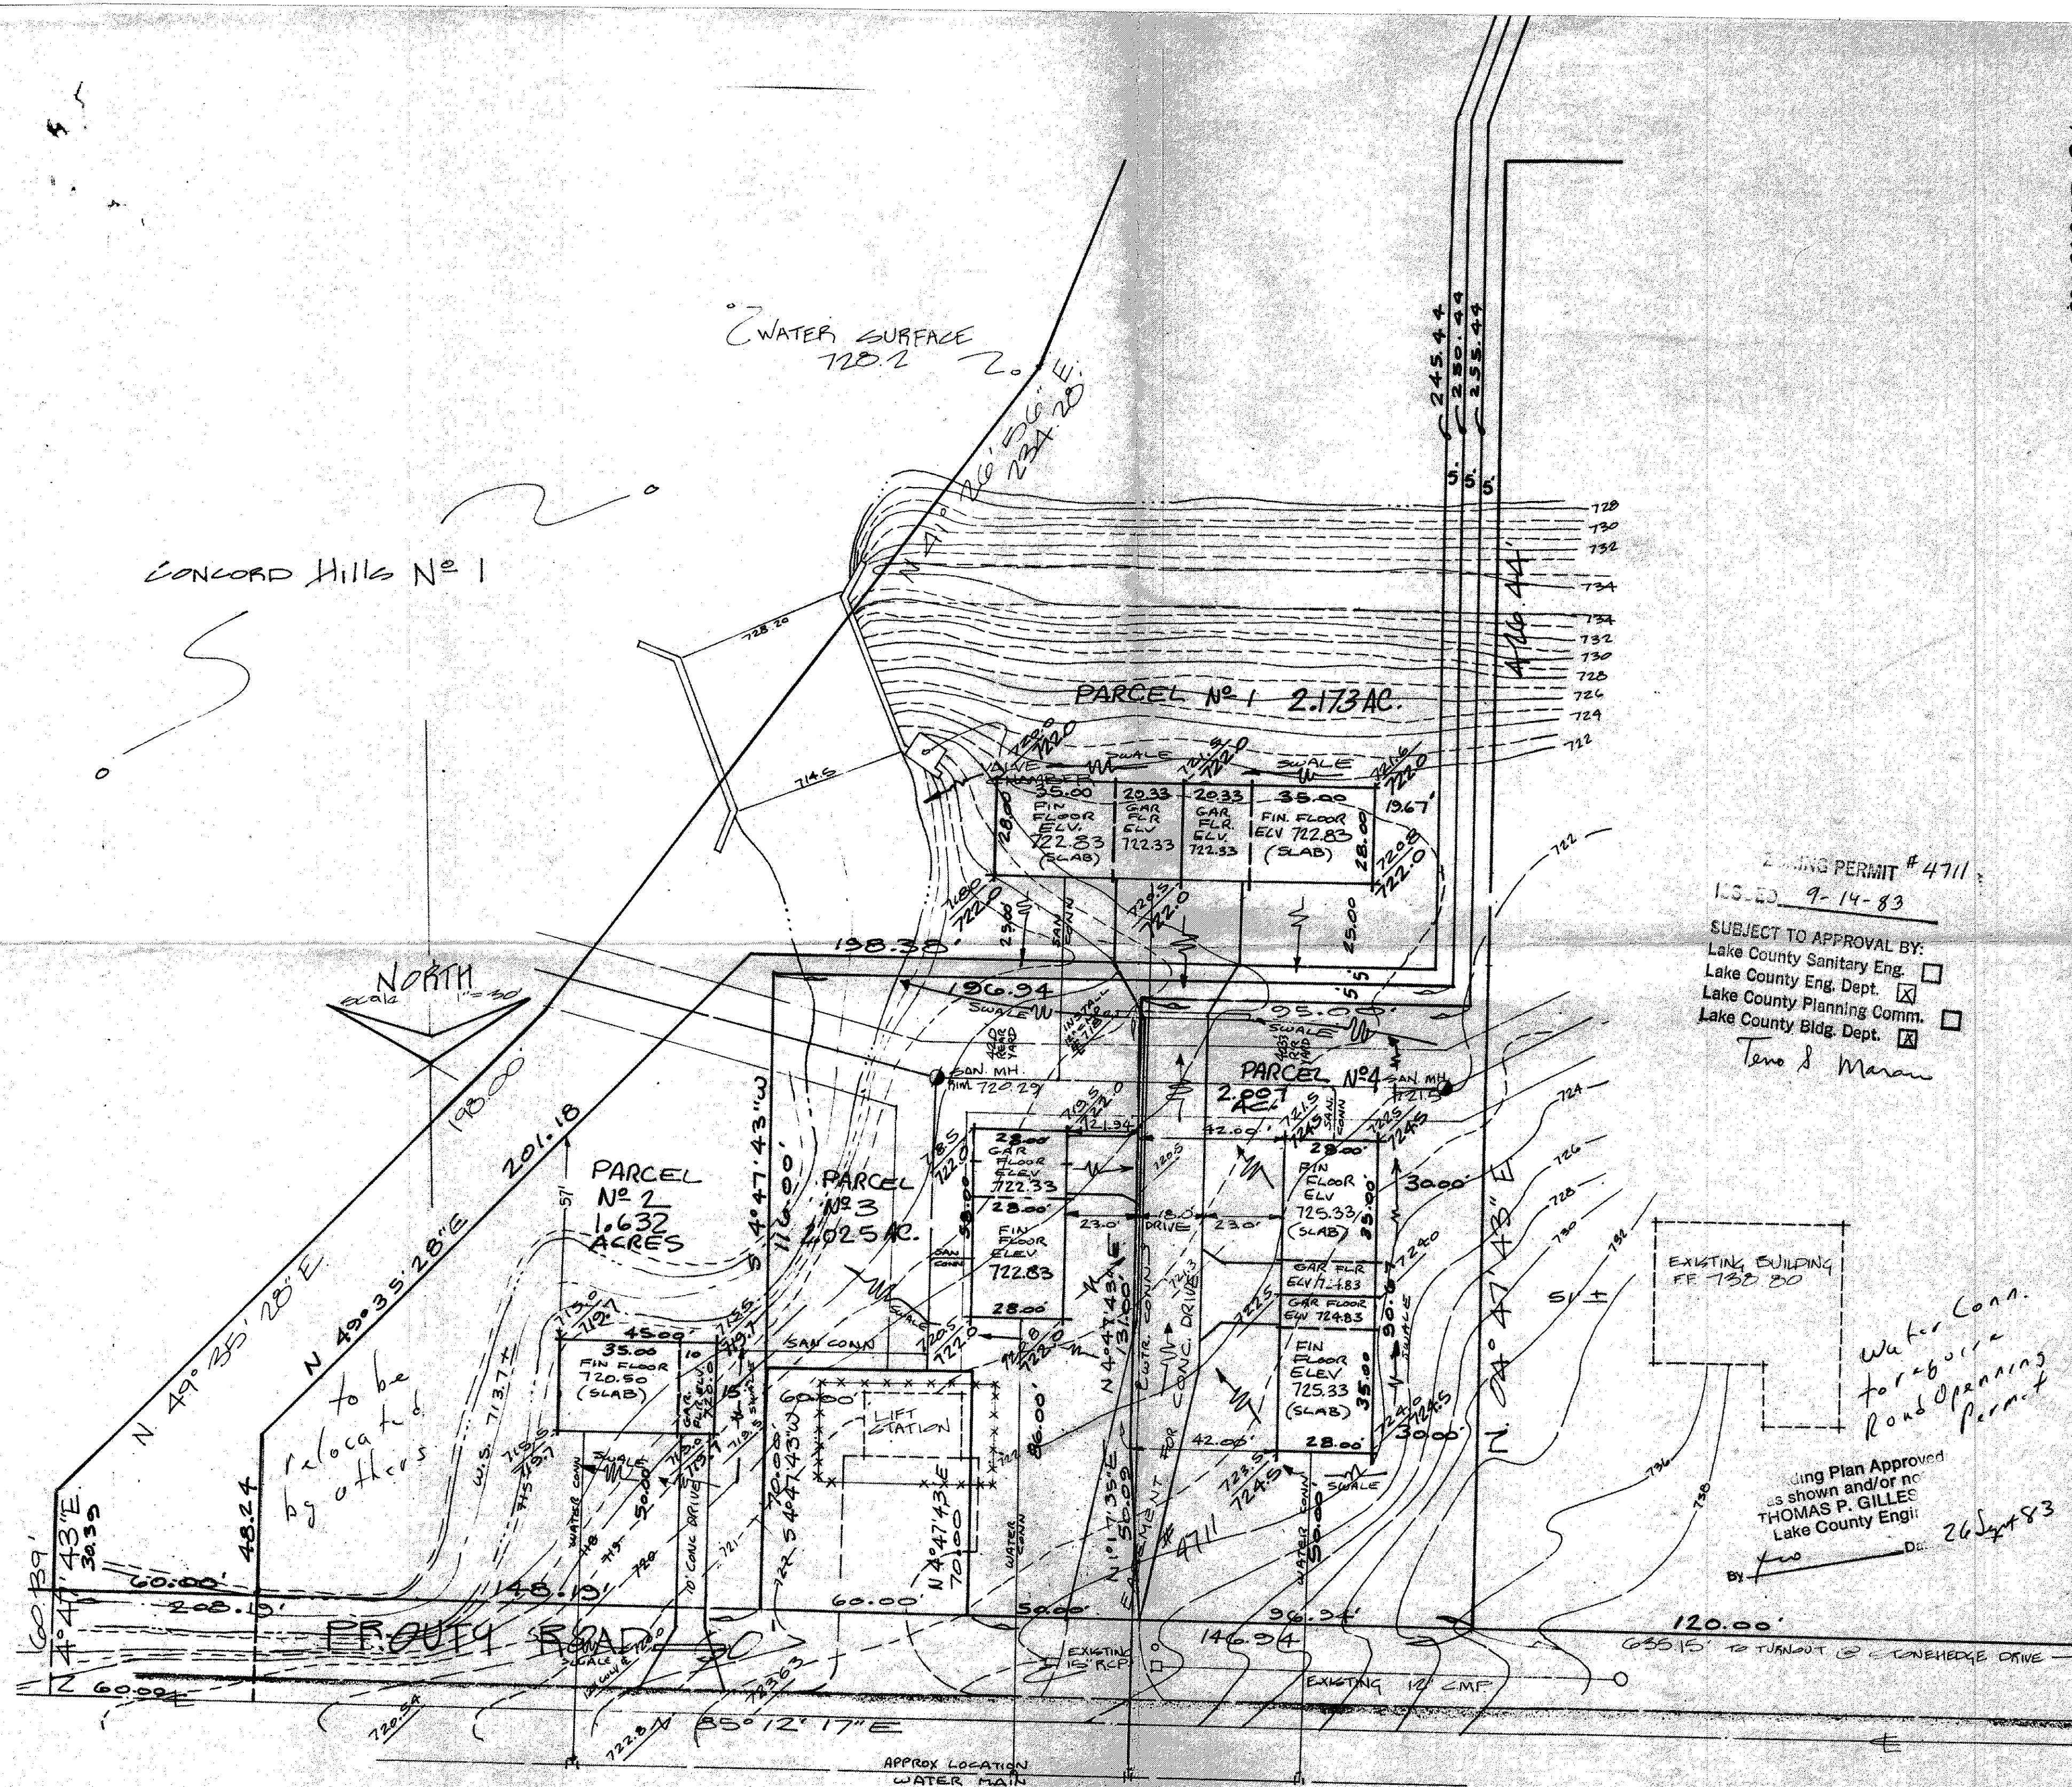

SITE PLAN for KENNETH T. SAWUL of
PART OF A 7.837 ACRE PARCEL IN ORIG LOT# 34, TRACT #4
CONCORD TOWNSHIP, LAKE COUNTY, OHIO

Colpetzer • Woods Consultants, Inc.
CONSULTING ENGINEERS AND SURVEYORS

DATE 9-14-83
SCALE 1"=50'
DRAWN BY [Signature]
CHECKED BY [Signature]

SHEET
1
OF
1