Zoning Permit # 2425
issued 11-28-72
H E van Vliet

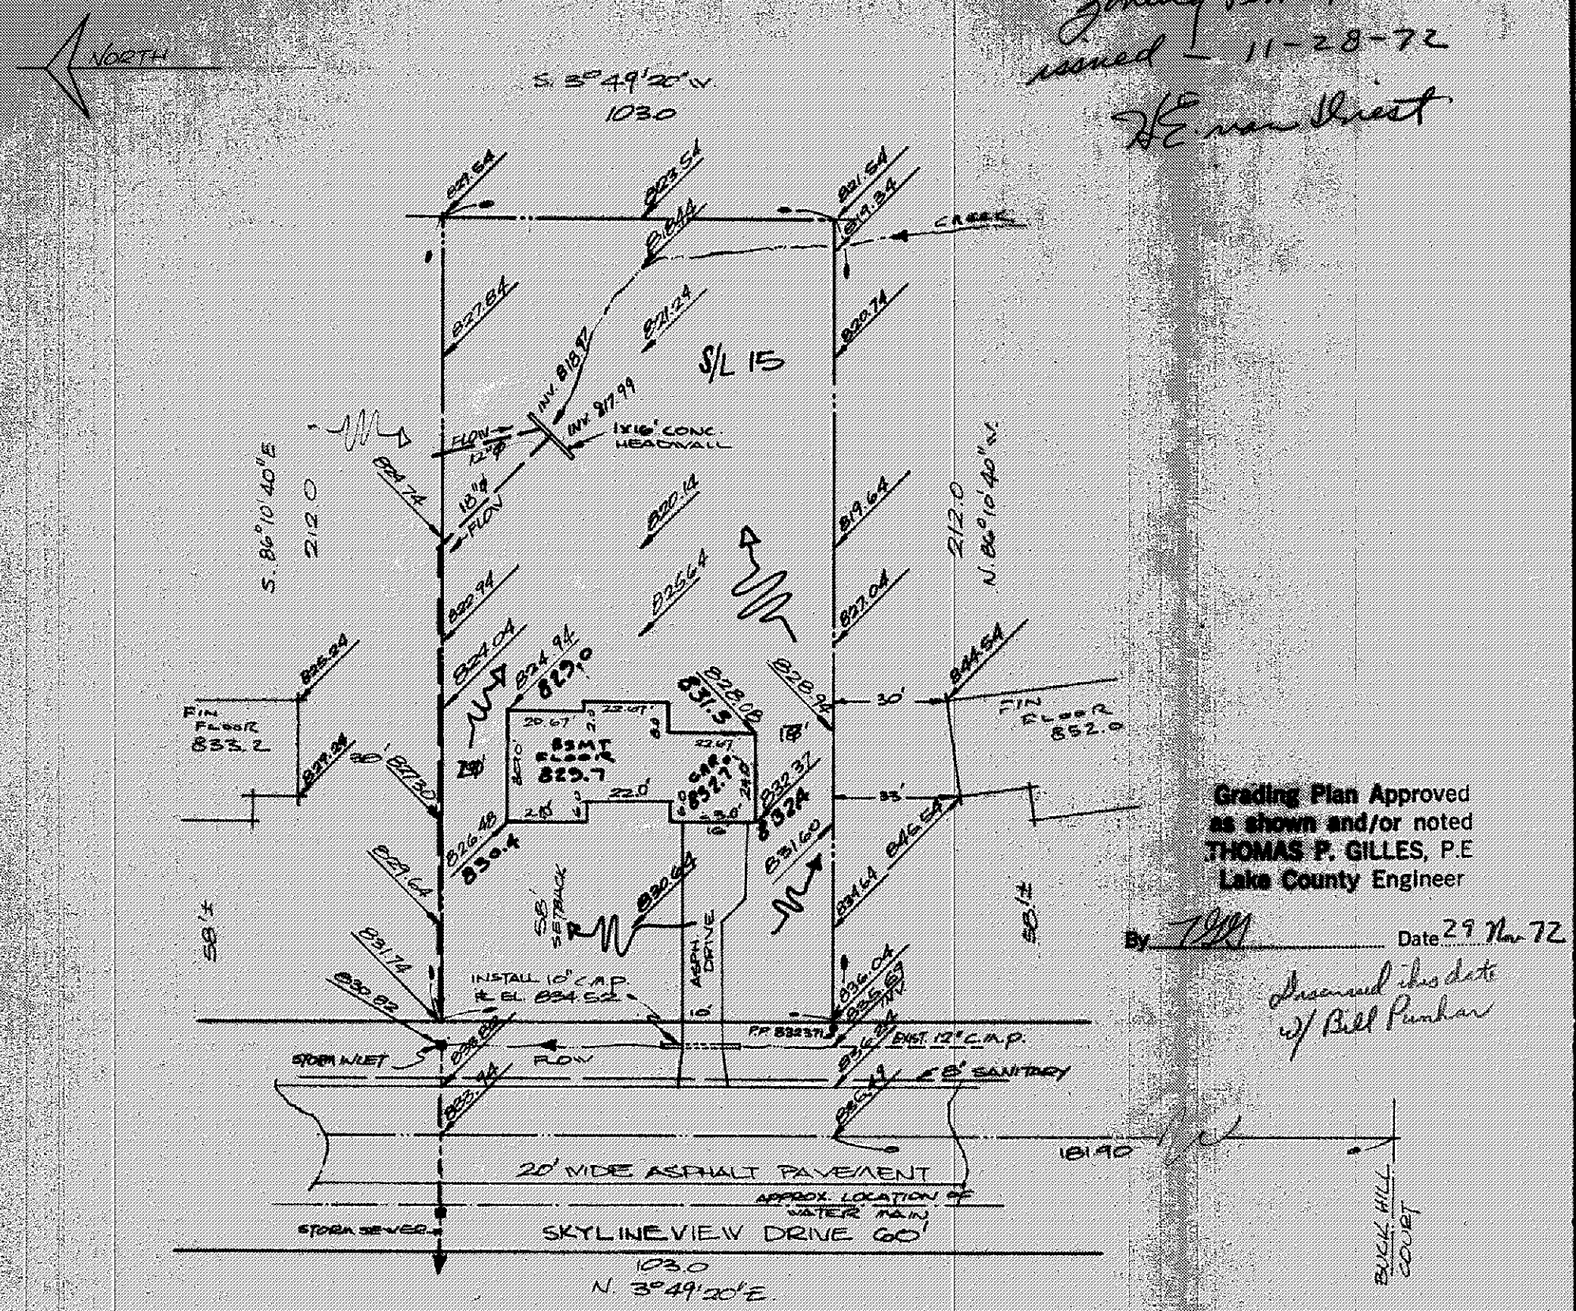

Grading Plan Approved
as shown and/or noted
THOMAS P. GILLES, P.E
Lake County Engineer

By _____ Date 29 Nov 72

Discussed this date w/ Bill Punchar

SITE PLAN

CONCORD TOWNSHIP — LAKE COUNTY, OHIO

for: MARY FRABOTTA
CLIENT · OWNER

ADDRESS — STREET — CITY — ZIP

LITTLE MOUNTAIN PARK NRS — SUBDIVISION NAME
P 13 — VOL. - PG
15 — SUBLOT NO.
SKYLINE VIEW DR — STREET

~~LOT~~ — ~~TRACT~~
~~VOLUME~~ — ~~PAGE~~
~~PERM. PARCEL #~~ — ~~STREET~~

LEGEND

SANITARY MANHOLE
STORM MANHOLE
INLET OR CATCH BASIN
HYDRANT
EXISTING CONTOURS
PROPOSED CONTOURS
EXIST. ELEV. 100.0
100.0 – PROP. ELEV.
WATER VALVE (GAS)
WATER METER (GAS)
AS BUILT ELEVATION
INDICATES DIRECTION OF SURFACE DRAINAGE

REMARKS

ALL BOUNDARY DATA SHOWN WAS OBTAINED FROM (DEEDS, RECORDED SUBDIVISION PLAT, OR OTHER PUBLIC RECORDS)

DESIGN CERTIFICATION

THIS PLAT WAS PREPARED BY ME AND IS CORRECT TO THE BEST OF MY KNOWLEDGE AND BELIEF.

NAME — SURVEYOR — REGISTRATION NO. PS #5244

CHECK LIST

DIMENSIONS
BEARINGS
TIE TO NEAREST STREET
SUBLOT NO. PARCEL NO.
SURROUNDING OWNERS
BLDG. DIMENSIONS FIN. GR.
BLDG. TIES FLR. GRADES
APRON TYPE WIDTH THICKNESS
SIDEWALK TYPE WIDTH THICKNESS
CULVERT TYPE DIA. LENGTH

WATER MAIN SIZE LOCATION
SAN. SEWER SIZE % GR. LOC.
SAN. MH. CAST ELEV. INV. ELEV.
SAN. CONN. SIZE LOC. DEPTH
STORM SEWER SIZE % GR. LOC.
STORM MH. CAST ELEV. INV. ELEV.
PAVT. TYPE GRADE CURBS
GAS LINE LOC. SIZE PRESSURE
SEPTIC TANK SIZE LOC.
WELL LOCATION

REVISIONS		
NO	DATE	BY
1		
2		
3		
4		
5		

PLAN PREPARED BY:
DEBEVEC-SALO & ASSOC., INC.
NAME
130 EAST JACKSON ST, PAINESVILLE
ADDRESS

DRAWN BY AG	SCALE 1"=40'	PHONE NO
CHK'D	DATE Nov 18 72	DRAWING NO 8793
CREW CHIEF	APP'D	

"AS BUILT" CERTIFICATION

I, HEREBY CERTIFY THAT THE CIRCLED GRADES ARE EXISTING FINISH GRADES CHECKED IN FIELD ON _____ 19__ BY SURVEYING AND ARE CORRECT TO THE BEST OF MY KNOWLEDGE AND BELIEF.

REGISTERED SURVEYOR — REG. NO.