SITE PLAN

CONCORD TOWNSHIP — LAKE COUNTY, OHIO

for: RYAN HOMES (CLIENT / OWNER)

8141 TYLER BLVD. (ADDRESS / STREET) MENTOR (CITY) 44060 (ZIP)

Grading Plan Approved as shown and/or noted
THOMAS P. GILLES, P.E.
Lake County Engineer
By _____ 6-27-79

CONCORD HILLS #3 — SUBDIVISION NAME
VOL. — PG.
143 — SUBLOT NO.
TROTWOOD — STREET

LOT — TRACT
VOLUME — PAGE
PERM. PARCEL NO. — STREET

LEGEND

- SANITARY MANHOLE
- STORM MANHOLE
- INLET OR CATCH BASIN
- HYDRANT
- EXISTING CONTOURS
- PROPOSED CONTOURS
- EXIST. ELEV. 100.0 / PROP. ELEV. 100.0
- WATER VALVE (GAS)
- WATER METER (GAS)
- AS BUILT ELEVATION 100.0
- INDICATES DIRECTION OF SURFACE DRAINAGE

REMARKS

ALL BOUNDARY DATA SHOWN WAS OBTAINED FROM (DEEDS, RECORDED SUBDIVISION PLAT OR OTHER PUBLIC RECORDS)

LOCATIONS AS SHOWN OF ADJACENT WELLS AND SEPTIC TANKS OBTAINED FROM LAKE COUNTY HEALTH DEPARTMENT

DESIGN CERTIFICATION

THIS PLAT WAS PREPARED BY ME, AND IS CORRECT TO THE BEST OF MY KNOWLEDGE AND BELIEF.

Edward E. Allen 4514
NAME SURVEYOR REGISTRATION NO.

CHECK LIST

NO. OF BEDROOMS
DIMENSIONS
BEARINGS
TIE TO NEAREST STREET
SUBLOT NO. PARCEL NO.
SURROUNDING OWNERS
BLDG. DIMENSIONS FIN. GR.
BLDG. TIES FL'R. GRADES
APRON TYPE WIDTH THICKNESS
SIDEWALK TYPE WIDTH THICKNESS
CULVERT TYPE DIA., LENGTH
ROCK OUTCROPPINGS

WATER MAIN SIZE, LOCATION
SAN. SEWER SIZE % GR. LOC.
SAN. MH. CAST. ELEV. INV. ELEV.
SAN. CONN. SIZE, LOC. DEPTH
STORM SEWER SIZE % GR. LOC.
STORM MH. CAST ELEV. INV. ELEV.
PAV'T TYPE GRADE CURBS
GAS LINE LOC. SIZE PRESSURE
SEPTIC TANK LOCATION & DUPLICATION AREA
WELL LOCATION
ISOLATION RADIUS FROM WELL

REVISIONS		
NO.	DATE	BY
1		
2		
3		
4		
5		

PLAN PREPARED BY:
DEBEVEC • SALO & ASSOCIATES, INC.
125 E. ERIE ST. PAINESVILLE, OHIO

DRAWN BY LANTZ & HODGES	SCALE 1" = 30	PHONE NO. 352-9250
CHK'D.	DATE 6-14-79	DRAWING NO. 4820-143
CREW CHIEF J.R.	APP'D.	

"AS BUILT" CERTIFICATION

I, HEREBY CERTIFY THAT THE CIRCLED GRADES ARE EXISTING FINISH GRADES CHECKED IN THE FIELD ON _____, 19___ AND ARE CORRECT TO THE BEST OF MY KNOWLEDGE AND BELIEF.

REGISTERED SURVEYOR — REG. NO.

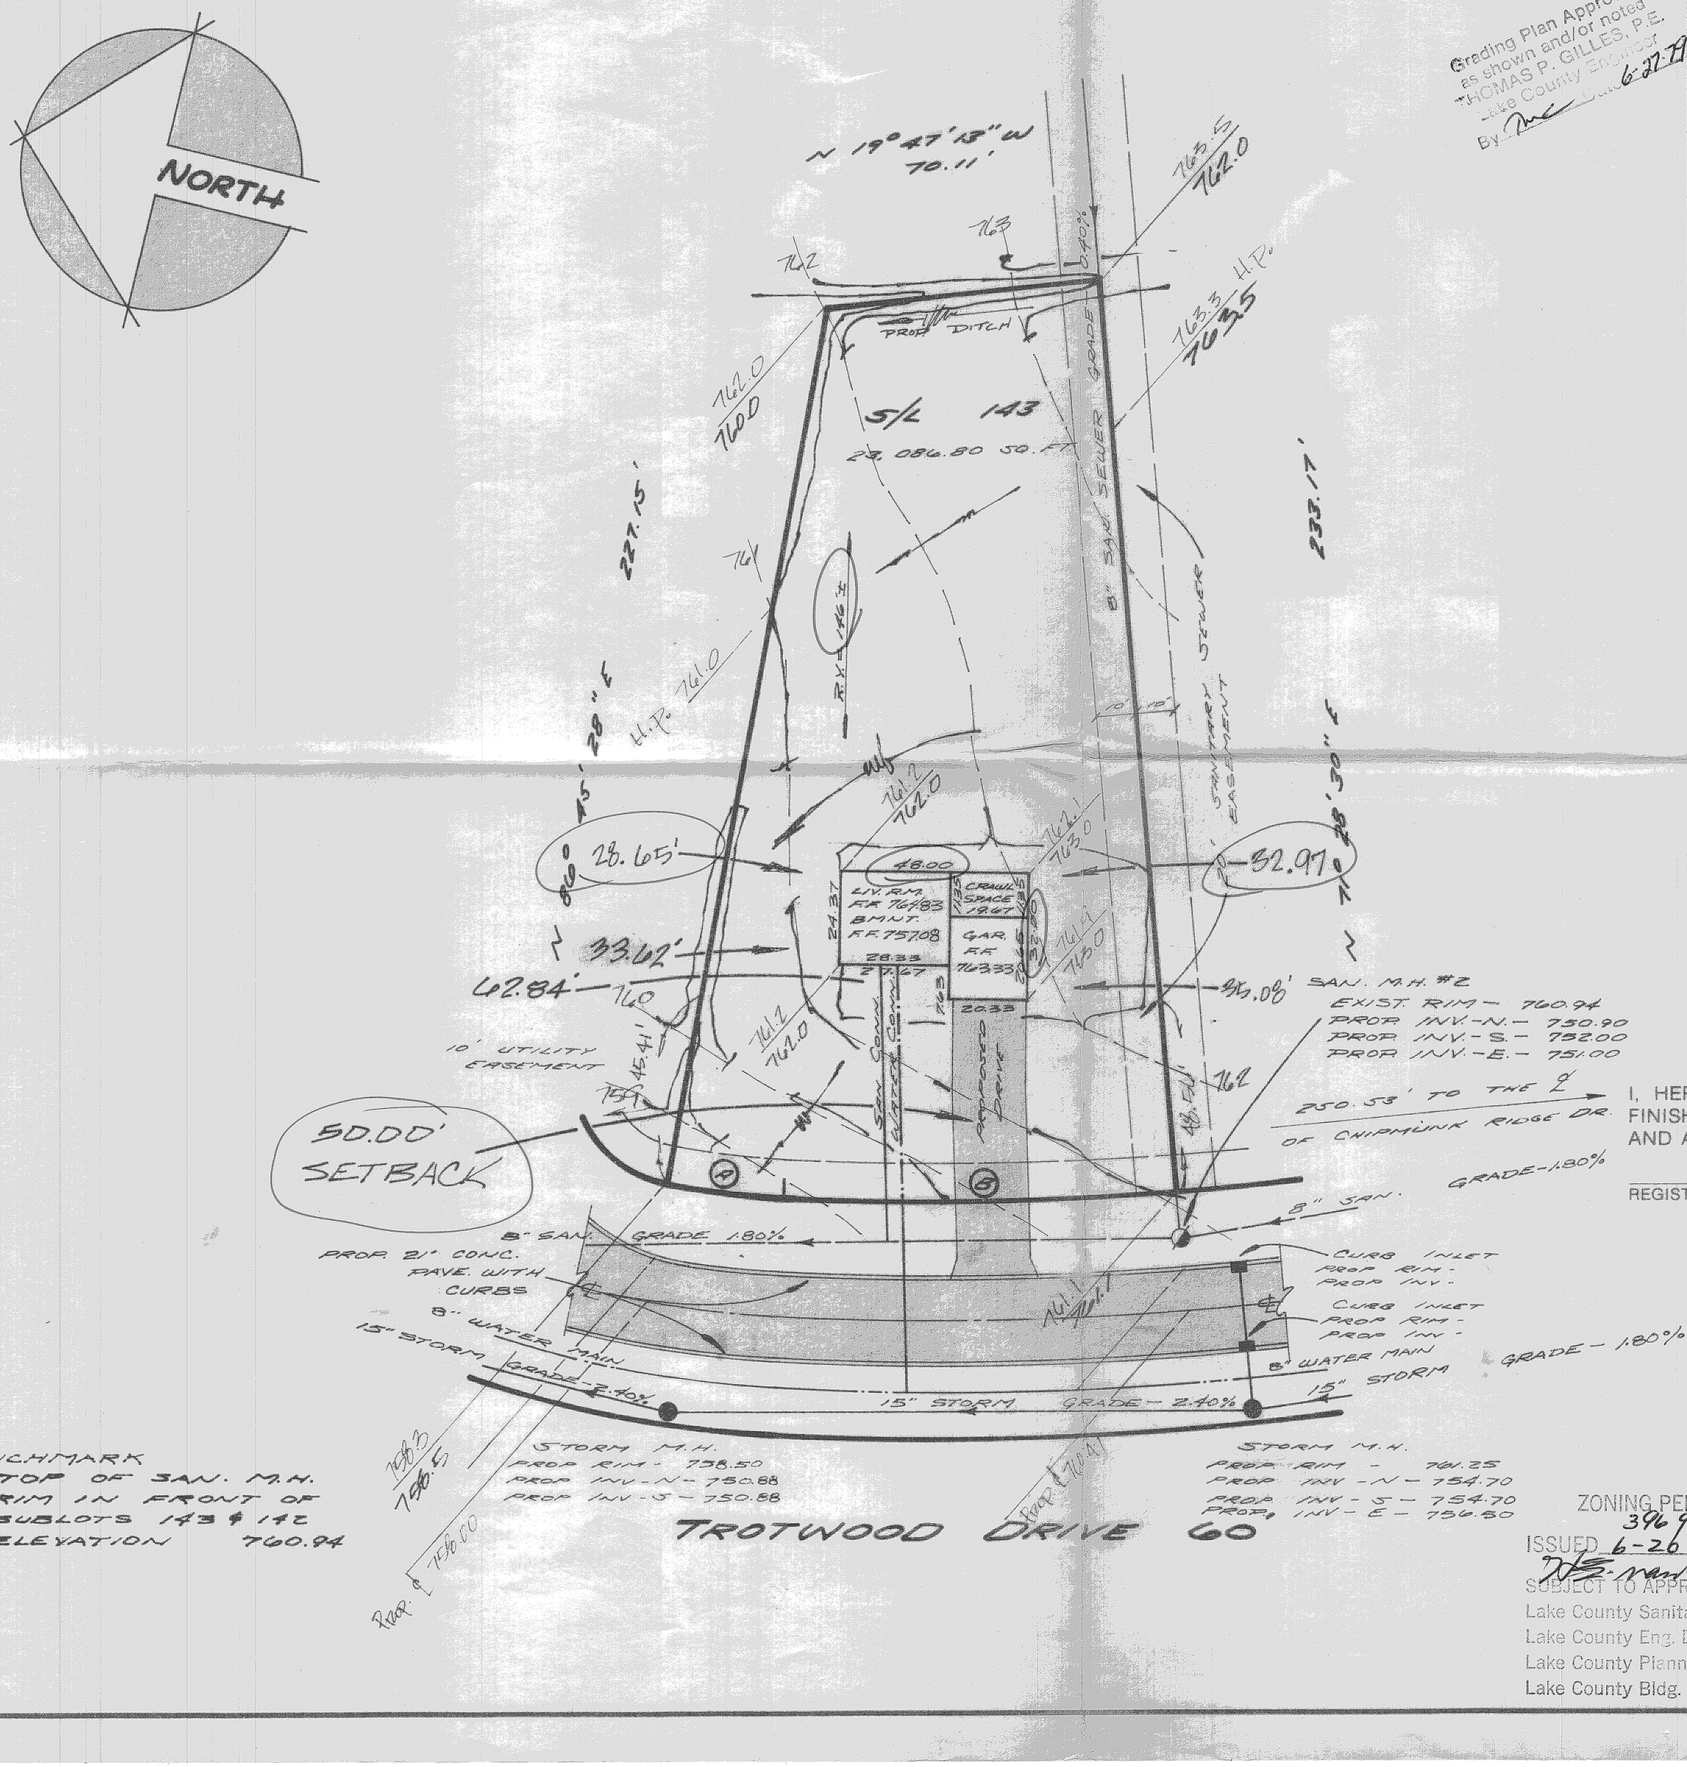

BENCHMARK
TOP OF SAN. M.H. RIM IN FRONT OF SUBLOTS 143 & 142
ELEVATION 760.94

ZONING PERMIT 396
ISSUED 6-26-79
SUBJECT TO APPROVAL BY:
- Lake County Sanitary Eng. ☐
- Lake County Eng. Dept. ☒
- Lake County Planning Comm. ☐
- Lake County Bldg. Dept. ☒

JUN 18 1979

4820-143